

GENERAL NOTES:

- ALL WORK SHOWN IS NEW UNLESS OTHERWISE INDICATED AS EXISTING (E), RELOCATED (RL) OR FUTURE.
- ALL WORK SHALL BE PERFORMED IN ACCORDANCE WITH ALL APPLICABLE FEDERAL, STATE, AND LOCAL CODES AND STANDARDS INCLUDING BUT NOT LIMITED TO 2019 CALIFORNIA MECHANICAL CODE (CMC), 2019 CALIFORNIA PLUMBING CODE (CPC), 2019 CALIFORNIA BUILDING CODE (CBC), 2016 CALIFORNIA FIRE CODE (CFC), 2019 CALIFORNIA ELECTRICAL CODE, 2019 CALIFORNIA ENERGY CODE (CAL. CTR TITLE 24, PART 6), NATIONAL FIRE PROTECTION ASSOCIATION (NFPA).
- SUBMITTALS: REFER TO SPECIFICATIONS FOR SUBMITTAL REQUIREMENTS.
- ALL EQUIPMENT SHALL BE MOUNTED AND ATTACHED TO STRUCTURE SO THAT IT IS RESTRAINED IN THE CASE OF A SEISMIC EVENT IN ACCORDANCE WITH THE REQUIREMENTS OF 2019 CBC.
- RECORD DRAWINGS: CONTRACTOR SHALL KEEP AN ACCURATE RECORD DURING CONSTRUCTION OF AS-BUILT CONDITIONS ON A SET OF CONTRACT DRAWINGS. PROGRESS AS-BUILTS SHALL BE AVAILABLE FOR OWNER REVIEW WITH EACH SUBMISSION FOR PAYMENT APPLICATION. FINAL RED LINE RECORD DRAWING MARK-UPS SHALL BE SUBMITTED TO THE OWNER'S REPRESENTATIVE WITHIN 30 DAYS OF COMPLETION OF THE PROJECT.
- OPERATION & MAINTENANCE (O&M) MANUALS: AT COMPLETION OF PROJECT CONTRACTOR SHALL SUBMIT TO THE OWNER UP TO 4 COPIES (QTY TO BE VERIFIED WITH OWNER) OF O&M MANUALS WHICH SHALL INCLUDE:
 - MFG'S O&M INSTRUCTIONS FOR ALL EQUIPMENT
 - COPIES OF APPROVED SUBMITTAL DATA SHOWING EQUIPMENT SPECIFICATIONS, CAPACITIES, ETC.
 - 11x17 (FOLDED) COPIES OF ALL SHOP DRAWINGS
 - 11x17 (FOLDED) COPIES OF CONTRACT RECORD DRAWINGSALL O&M MANUALS SHALL BE INDEXED & BOUND IN 3 RING BINDERS WITH CLEAR LABELING & TABBED DIVIDERSg.
- OWNERS STAFF AND MAINTENANCE STAFF SHALL BE THOROUGHLY INSTRUCTED IN THE USE AND MAINTENANCE OF THE ELECTRICAL SYSTEM EQUIPMENT, LIGHT FIXTURE, LIGHTING CONTROLS, AND COMMUNICATION SYSTEMS BY MANUFACTURERS AUTHORIZED DISTRIBUTOR PERSONNEL OR OWNER APPROVED EQUAL. THE INSTRUCTION TO THE STAFF SHALL INCLUDE HANDS ON DEMONSTRATION OF THE VARIOUS FUNCTIONS & OPERATIONS OF THE SYSTEMS AND INCLUDE REQUIRED MAINTENANCE TASKS AND INSTRUCTIONS. TRAINING SHALL INCLUDE A MINIMUM OF EIGHT (8) HOURS.

LIGHTING FIXTURE SCHEDULE											
FIX NO.	MANUFACTURER	CATALOG NO.	LAMP TYPE	LUMENS	COLOR TEMP	DIM	T24 WATTS	BRANCH CKT DESIGN WATTS	MOUNTING/ HEIGHT	REMARKS/ACCESSORIES	
C1	METALUX	22FP3830C9 - FPXSURF22	LED	3654	3000K / 90CRI	0-10V	39.1	45	SURFACE CEILING	SURFACE MOUNT KIT	
C1-EM	METALUX	22FP3830C9 - EL7W - FPXSURF22	LED	3654	3000K / 90CRI	0-10V	39.1	45	SURFACE CEILING	SURFACE MOUNT KIT; 7W-90 MINUTE EMERG. BATTERY	
C2	METALUX	14FP3830C9 - FPXSURF14	LED	3648	3000K / 90CRI	0-10V	38.9	45	SURFACE CEILING	SURFACE MOUNT KIT	
C2-EM	METALUX	14FP3830C9 - EL7W - FPXSURF14	LED	3648	3000K / 90CRI	0-10V	38.9	45	SURFACE CEILING	SURFACE MOUNT KIT; 7W-90 MINUTE EMERG. BATTERY	
C3	METALUX	24FP5830C9 - FPXSURF24	LED	5282	3000K / 90CRI	0-10V	58.2	70	SURFACE CEILING	SURFACE MOUNT KIT	
C3-EM	METALUX	24FP5830C9 - EL7W - FPXSURF24	LED	5282	3000K / 90CRI	0-10V	58.2	70	SURFACE CEILING	SURFACE MOUNT KIT; 7W-90 MINUTE EMERG. BATTERY	
C4	HE WILLIAMS	SLF-2-L26/830-HA-DRV-120	LED	2780	3000K / 80CRI	NON-DIM	21.3	25	SURFACE WALL	JANITORS CLOSET	
C5	LITHONIA	UCEL-36IN-30K-90CRI-SWR-WH	LED	1344	3000K / 90CRI	TRIAC	18	25	UNDER CABINET	COMMON ROOM	
C6	LITHONIA	FMVCL-24IN-MVOLT-30K-90CRI-XX (COLOR TBD)	LED	1391	3000K / 90CRI	NON-DIM	17.7	25	VANITY LIGHT		
R1	JUNO	J5F-11IN-30K-90CRI-120FRPC-WH	LED	1300	3000K / 90CRI	TRIAC	15	20	SURFACE CEILING		
R2	LITHONIA	FMVCL-24IN-MVOLT-30K-90CRI-XX (COLOR TBD)	LED	1391	3000K / 90CRI	NON-DIM	17.7	25	VANITY LIGHT		
R3	LITHONIA	UCEL-24IN-30K-90CRI-SWR-WH	LED	927	3000K / 90CRI	TRIAC	12	15	UNDER CAB	USE MAX LENGTH TO FIT AVAILABLE CABINET SPACE	
	LITHONIA	UCEL-36IN-30K-90CRI-SWR-WH	LED	1344	3000K / 90CRI	TRIAC	18	25	UNDER CAB	USE MAX LENGTH TO FIT AVAILABLE CABINET SPACE	
	LITHONIA	UCEL-48IN-30K-90CRI-SWR-WH	LED	1895	3000K / 90CRI	TRIAC	24	30	UNDER CAB	USE MAX LENGTH TO FIT AVAILABLE CABINET SPACE	
R4	JUNO	J5F-7IN-30K-90CRI-120FRPC-WH	LED	1000	3000K / 90CRI	TRIAC	13	15	SINK		
SA1	RAB	SLUM17FA-15-ADJ-BLACK	LED	1761	4000K	0-10V	14.2	20	EXT SCOCNE	COLOR: BRONZE	
SB1	GARDCO	ECF-S-32L-365-NW-G2-AR-BLC-120-BL-IMR13-BK	LED	6094	4000K	0-10V	40	50	LIGHT STANDARD	BI-LEVEL OCCUPANCY SENSING	
SB1-POLE	GARDCO	SRA-CA-4-188-15-D1-DTS-BK	-	-	-	-	-	-	15FT AFG	13FT POLE + 2FT PEDESTAL BASE; 15FT AFG	
SB2	GARDCO	ECF-S-32L-365-NW-G2-AR-5-120-BL-IMR13-BK	LED2	6094	4000K	0-10V	80	95	LIGHT STANDARD	BI-LEVEL OCCUPANCY SENSING; DOUBLE HEAD ASSEMBLY Ø 180	
SB2-POLE	GARDCO	SRA-CA-4-188-15-D2-DTS-BK	-	-	-	-	-	-	15FT AFG	13FT POLE + 2FT PEDESTAL BASE; 15FT AFG	
SC1	GARDCO	BRM832-36-108L-58-NW-G2-120-IMR1-BK	LED	1226	4000K	0-10V	38.6	45	BOLLARD	BI-LEVEL OCCUPANCY SENSING	
SD1	COOPER-HALO	PR6-FS12-D010 - PR6M-12-WD-8FS-MW	LED	2000	4000K	0-10V	21.3	25	RECESSED DOWN LIGHT		
SD1-EM	COOPER-HALO	PR6-FS12-D010-REM7 - PR6M-12-WD-8FS-MW	LED	2000	4000K	0-10V	21.3	25	RECESSED DOWN LIGHT	7W-90 MINUTE EMERG. BATTERY	
SE1	LAMPS PLUS	JOHN TIMBERLAND #BM841 (BLACK)	LED	750	3000K	N/A	10	15	SURFACE WALL		
X1	LITHONIA	LQC-W-1-G-ELN	LED	-	GREEN	NON-DIM	-	5	SURFACE WALL & CEILING	EXIT SIGNAGE	
ED1	BRK	7030BSL	-	-	-	-	-	-	SURFACE CEILING	SMOKE AND CO DET.	
AFG - ABOVE FINISH GRADE/AFS - ABOVE FINISH SLAB/ASC - ABOVE SUSPENDED CEILING/AFF - ABOVE FINISH FLOOR/ARF - ABOVE RAISED FLOOR											

ELECTRICAL SYMBOLS & ABBREVIATIONS

PANELS

VOLTAGE AND PHASE AS NOTED PER DWGS.

120/240V, 1 PHASE PANEL
240/120V, 3 PHASE PANEL
120/208V, 1 PHASE PANEL
208/120V, 3 PHASE PANEL
480/277V, 3 PHASE PANEL

480V, 3 PHASE PANEL
SPECIAL VOLTAGE PANEL
EMERGENCY POWER PANEL

CONDUIT

CONDUIT RUN CONCEALED IN OR UNDER SLAB OR BELOW GRADE FOR TELEPHONE SYSTEM

CONDUIT RUN CONCEALED IN CEILING OR WALL, U.O.N.

CONDUIT RUN CONCEALED IN OR UNDER SLAB OR BELOW GRADE FOR COMMUNICATION SYSTEM

EMERGENCY SYSTEM CIRCUITING

CONDUIT RUN CONCEALED IN OR UNDER SLAB OR BELOW GRADE FOR PA SYSTEM

PRIMARY

CONDUIT RUN CONCEALED IN OR UNDER SLAB OR BELOW GRADE FOR SECURITY SYSTEM

CONDUIT RUN CONCEALED IN OR UNDER SLAB OR BELOW GRADE FOR TELEPHONE SYSTEM

HOME RUN TO POWER SOURCE

CONDUIT TURN DOWN

CONDUIT TURN UP

GROUND CONDUCTOR NEUTRAL CONDUCTOR POWER CONDUCTORS

LOW VOLTAGE CONTROL CONDUCTORS

CONDUIT SIZE

DEVICES

SINGLE POLE SWITCH, +46" U.O.N.
0 - CIRCUIT # & SWITCHING
1 - DOUBLE POLE
2 - 3 WAY
4 - 4 WAY

240V RECEPT

208V RECEPT

480V RECEPT

FOUR-PLEX RECEPT, NEMA 5-20R, +18" U.O.N.

DUPLEX RECEPT, W/GROUND FAULT INTERRUPTER +44", U.O.N.

ROOF/CEILING/RECEPT/DROP RECEPT

ROOF/CEILING 4 PLEX/DROP RECEPT

FLOOR RECEPTACLE

POWER PACK

A.C. MOTOR GENERAL SYMBOL

SAFETY SWITCH, SIZE AS NOTED

MAGNETIC STARTER

COMBINATION STARTER

MANUAL STARTER

DISTRIBUTION TRANSFORMER
P - PRIMARY
S - SECONDARY

BOX SIZE

PULL BOX - POWER, TEL, COMMUNICATION

SECURITY CAMERA FIELD COORDINATE WITH OWNERS SECURITY CONSULTANT

TIME CLOCK

JUNCTION BOX

TELEPHONE OUTLET

TELECO/DATA OUTLET

CABLE TV OUTLET

LIGHTING CONTROL STATION

OS = OCCUPANCY SENSOR
DS = DAYLIGHT SENSOR
IR = INFRARED SENSOR

SINGLE OR DUAL SWITCH OCCUPANCY SENSOR

ROOM CONTROL
X=CONTROL REFERENCE NUMBER

LIGHTING DEVICES

FLUORESCENT FIXTURE, RECESSED IN CEILING

FLUORESCENT FIXTURE, SURFACE OR PENDANT MOUNTED

FLUORESCENT FIXTURE, WALL MOUNTED

FLUORESCENT STRIP, SURFACE, PENDANT, OR WALL MOUNTED AS NOTED.

NL = NIGHT LIGHT
EM = EMERGENCY LIGHT

LIGHT FIXTURE

EMERGENCY BATTERY POWERED LIGHT

EXIT SIGN, WITH DIRECTIONAL ARROWS AS SHOWN

SINGLE POLE SWITCH, +46" U.O.N.
0 - CIRCUIT # & SWITCHING
1 - DOUBLE POLE
2 - 3 WAY
4 - 4 WAY

LIGHTING CONTROL STATION

OS = OCCUPANCY SENSOR
DS = DAYLIGHT SENSOR
IR = INFRARED SENSOR

SINGLE OR DUAL SWITCH OCCUPANCY SENSOR

ROOM CONTROL
X=CONTROL REFERENCE NUMBER

IDENTIFICATION LABELS

LIGHT FIXTURE TAG

MECHANICAL EQUIPMENT TAG

COMPLY WITH LETTER OR NUMBER NOTE ON SHEET

SEE DETAIL 8, SHEET E4

FEEDER IDENTIFICATION TAG

XXX=FEEDER:
YY=

P-PRIMARY POWER
S-SECONDARY POWER
E-ELECTRIC POWER
EM-EMERGENCY POWER
T-TELECO SERVICE
TD-TELECO DATA
CA-CABLE SERVICE

ABBREVIATIONS

A - AMP
ADMIN - ADMINISTRATION
AFF - ABOVE FINISHED FLOOR
AFS - ABOVE FINISHED GRADE
AFS - ABOVE FINISHED SLAB
AL - ALUMINUM
ARCH - ARCHITECT
ARF - ABOVE RAISED FLOOR
ASC - ABOVE SUSPENDED CEILING
BD - BOARD
BLDG - BUILDING
C - CONDUIT
CIR - CIRCUIT
CO - CONDUIT ONLY
CONG - CONCRETE
CONN - CONNECT
CU - COPPER
DISC - DISCONNECT
DWG - DRAWING
(E) - EXISTING
ELEC - ELECTRICAL
EM - EMERGENCY
EP - EXPLOSION PROOF

EQUIP - EQUIPMENT
ES - ENERGY SAVING
EXIST - EXISTING
FA - FIRE ALARM
FACP - FIRE ALARM CONTROL PANEL
FAP - FIRE ALARM PANEL
FDR - FEEDER
GND - GROUND
HP - HORSEPOWER
MAX - MAXIMUM
MECH - MECHANICAL
MFG - MANUFACTURER
MIN - MINIMUM
MSB - MAIN SWITCH BOARD
MTG - MOUNTING
(N) - NEW
NL - NIGHT LIGHT
(NL) - NEW LOCATION
NFS - NON-FUSED DISC. SW.
OH - OVERHEAD
P - PULL BOX
P.O.C - POINT OF CONNECTION
PGAS - PACIFIC GAS AND ELECTRIC
PNL - PANEL

QTY - QUANTITY
(R) - REMOVE
(RL) - RELOCATE
RIG - RIGID GALVANIZED STEEL
(RR) - REMOVE AND REPLACE EXISTING
(RRN) - REMOVE AND REPLACE NEW
SCH - SCHEDULE
STRUCT - STRUCTURAL
SW - SWITCH
SWBD - SWITCHBOARD
SYM - SYMMETRICAL
SYS - SYSTEM
TELE - TELEPHONE
TERM - TERMINAL
TRANS - TRANSFORMER
(N) - NEW
UC - UNDERGROUND
UNION - UNLESS OTHERWISE NOTED
VF - VERTICAL IN FIELD
V - VOLTS
WRG - WEATHERPROOF
WRGS - WRAPPED RIGID GALVANIZED STEEL
- PHASE

NOTE: DIMENSIONS TO CENTERLINE, UNLESS OTHERWISE NOTED.

ELECTRICAL DRAWING INDEX

PG	SHEET	TITLE
1	E0.00	ELECTRICAL INFORMATION SHEET
2	E0.10	T24 LIGHTING INTERIOR
3	E0.20	T24 LIGHTING EXTERIOR
4	E0.30	T24 ELECTRICAL POWER DISTRIBUTION
5	E1.00	ELECTRICAL SITE PLAN
6	E1.01	UTILITY & MAIN SERVICE DETAILS
7	E1.10	SITE LIGHTING PLAN
8	E1.11	DETAILS
9	E2.10	FIRST FLOOR LIGHTING PLAN
10	E2.20	SECOND FLOOR LIGHTING PLAN
11	E2.30	THIRD FLOOR LIGHTING PLAN
12	E3.10	FIRST FLOOR POWER PLAN
13	E3.20	SECOND FLOOR POWER PLAN
14	E3.30	THIRD FLOOR POWER PLAN
15	E3.40	ROOF POWER PLAN
16	E4.10	LIGHTING & POWER PLANS - UNITS 101, 102, 103
17	E4.20	LIGHTING & POWER PLANS - UNITS 201, 202, 203, 204, 205, 207, 208
18	E4.21	LIGHTING & POWER PLANS - UNITS 206, 209
19	E4.30	LIGHTING & POWER PLANS - UNITS 301, 302, 303, 304, 305, 306, 307, 308
20	E5.00	ONE-LINE DIAGRAM
21	E6.00	SITE SECURITY CAMERA PLAN
22	E6.10	FIRST FLOOR SECURITY CAMERA PLAN
23	E6.20	SECOND FLOOR SECURITY CAMERA PLAN
24	E6.30	THIRD FLOOR SECURITY CAMERA PLAN
25	E7.00	ELECTRICAL SPECIFICATIONS
26	EL1.10	SITE LIGHTING PHOTOMETRICS - NORMAL
27	EL2.10	FIRST FLOOR PHOTOMETRICS - NORMAL
28	EL2.10E	FIRST FLOOR PHOTOMETRICS - EMERG
29	EL2.20	SECOND FLOOR PHOTOMETRICS - NORMAL
30	EL2.20E	SECOND FLOOR PHOTOMETRICS - EMERG
31	EL2.30	THIRD FLOOR PHOTOMETRICS - NORMAL
32	EL2.30E	THIRD FLOOR PHOTOMETRICS - EMERG

MECHANICAL EQUIPMENT

	VOLT	PHASE	HP	FLA	VA	EQUIP. FDR C.B.	EQUIP. DISC. SIZE	EQUIP. DISC. FUSE SIZE	REMARKS
EF-1	120	1	-	0.54	65	(8)	(8)	N/A	EXHAUST FAN - LAUNDRY ROOM
EF-2	120	1	-	0.56	67.1	(8)	(8)	N/A	EXHAUST FAN - TRASH ROOM
EF-3	120	1	-	0.21	25.0	(8)	(8)	N/A	EXHAUST FAN - LAUNDRY ROOM
EF-4	120	1	-	0.21	25.0	(8)	(8)	N/A	EXHAUST FAN - TOILET ROOM 112
FC-1	120	1	-	16.7	2004	30A-1P	(8)	N/A	ELECTRIC FAN CONNECTOR
ERV-1	120	1	-	0.75	90	(8)	(4)	N/A	ENERGY RECOVERY UNIT
ERV-2	120	1	-	0.75	90	(8)	(4)	N/A	ENERGY RECOVERY UNIT
HP-1	208	1	-	16.5	3432	30A-2P	30AF-2P	20A	OFFICE & COMMON ROOM SPLIT SYSTEM
AH-1	208	1	-	0.46	100	N/A	(8)	N/A	COMMON ROOM FAN COIL; FED FROM OUTDOOR UNIT
HPHW-1	208	3	-	101.5	36567	150A-3P	200AF-3P	125A	ROOF TOP WATER HEATER
EW-1	208	3	-	67.0	24138	100A-3P	100AF-3P	90A	ELECTRIC WATER HEATER
EW-2	208	3	-	67.0	24138	100A-3P	100AF-3P	90A	ELECTRIC WATER HEATER
DHW-1A	115	1	-	4.4	506	(8)	NEMA 5-20R	N/A	HOT WATER CIRCULATION PUMP - FIRST FLOOR
DHW-1B	115	1	-	4.4	506	(8)	NEMA 5-20R	N/A	HOT WATER CIRCULATION PUMP - SECOND & THIRD FLOORS
FSD-1	120	1	-	< 1.0	< 120	(8)	(8)	N/A	FIRE SMOKE DAMPER - COORDINATE AUX CONTACTS WITH FIRE ALARM
PS-1	120	1	-	< 2.0	< 240	(8)	NEMA 5-20R	N/A	SOLAR PUMPING STATION; MFG: VESSMANN; MODEL: DN25
(1) CONTRACTOR TO FIELD VERIFY ALL EQUIPMENT ELECTRICAL CHARACTERISTICS.									
(2) TOGGLE TYPE MOTOR RATED DISCONNECT SWITCH, PROVIDED WITH EQUIPMENT OVERLOADS.									
(3) COMBINE WITH LIGHTING CIRCUITS.									
(4) PROVIDE EQUIP. SERVICE DISC. SWITCH IF UNIT DOES NOT HAVE INTEGRAL DISCONNECTING MEANS.									
(5) PROVIDE RECEPTACLE TO MATCH UNIT CORD.									
(6) PROVIDE MOTOR THERMAL OVERLOAD PROTECTION IF MOTOR DOES NOT HAVE MOTOR THERMAL OVERLOAD PROTECTION.									
(7) SIZE PER EQUIPMENT FULL LOAD NAMEPLATE CURRENT.									
(8) SEE ELECTRICAL PLAN.									
N/A - NOT APPLICABLE.									

PROPRIETARY DATA

THE USE OF THE PLANS AND SPECIFICATIONS IS LIMITED TO THE PROJECT AND SITE WHERE THEY WERE PREPARED, AND NO PART THEREOF IS TO BE REPRODUCED OR TRANSMITTED IN ANY FORM OR BY ANY MEANS, WITHOUT THE WRITTEN PERMISSION OF THE ENGINEER. THE ENGINEER'S LIABILITY IS LIMITED TO THE PROFESSIONAL DESIGN AND SPECIFICATIONS OF THE PLANS AND SPECIFICATIONS, AND DOES NOT INCLUDE THE CONSTRUCTION OF THE PROJECT OR THE PERFORMANCE OF THE WORK THEREON. THE ENGINEER'S LIABILITY IS LIMITED TO THE PROFESSIONAL DESIGN AND SPECIFICATIONS OF THE PLANS AND SPECIFICATIONS, AND DOES NOT INCLUDE THE CONSTRUCTION OF THE PROJECT OR THE PERFORMANCE OF THE WORK THEREON.

REGISTERED PROFESSIONAL ENGINEER
EXPIRATION DATE: 08-30-24
ELECTRICAL
STATE OF CALIFORNIA

Central Pacific Engineering, Inc.
Professional Engineers
9035 Soquel Avenue, Suite 205
Santa Cruz, CA 95062
831-478-1525
831-478-1525
CPE JOB 21-044-0

DATE	08/27/22	10/14/22			
DESCRIPTION	ISSUED FOR PLAN CHECK	PLAN CHECK & OWNER COMMENTS			
REV.					

AFFORDABLE HOUSING PROJECT

LOCATION: 415 NATURAL BRIDGES DRIVE
SANTA CRUZ, CALIFORNIA

OWNER: THE HOUSING AUTHORITY OF THE COUNTY OF SANTA CRUZ

DR. DATE: 04/20/22

APPD. SCALE: AS NOTED

CHK. DGS

SAK

JOB NO. 21-044-0

DWG. NO. **E0.00**

SH 1 OF 32 REV. 1

ELECTRICAL INFORMATION SHEET

Indoor Lighting

NCC-114 (Issued 04/23)

CITY OF CALIFORNIA

CALIFORNIA ENERGY COMMISSION

NRCCLT-114

Page 3 of 8

10-30-2022

Project Name: AFFORDABLE HOUSING PROJECT

Report Page: 3

Project Address: 415 NATURAL BRIDGES DRIVE

Date Prepared: 10-30-2022

01	02	03	04	05	06	07	08	09	10
Name or Item Tag	Complete Luminaire Description	Modular (Track) Fixture	Small Aperture & Color Change	Watts per luminaire ¹	How Wattage is determined	Total number luminaires	Exempt per §140.6(a)(3)	Design Watts	Field Inspector
C3	ZX4 LED FLAT PANEL SURFACE	<input type="checkbox"/>	<input type="checkbox"/>	58.2	Mfr. Spec ²	4	<input type="checkbox"/>	232.8	Pass <input type="checkbox"/> Fail <input type="checkbox"/>
C4	JANITOR CLOSET LIGHT	<input type="checkbox"/>	<input type="checkbox"/>	21.3	Mfr. Spec ²	1	<input type="checkbox"/>	21.3	<input type="checkbox"/> <input type="checkbox"/>
C5	LED VANITY LIGHT	<input type="checkbox"/>	<input type="checkbox"/>	17.7	Mfr. Spec ²	1	<input type="checkbox"/>	17.7	<input type="checkbox"/> <input type="checkbox"/>
Total Designed Watts UNCONDITIONED SPACES:								1,754.2	

¹ FOOTNOTE: Design Watts for small aperture and color changing luminaires which qualify per §140.6(a)(4B) is adjusted to be 75% of their rated wattage. Table F automatically makes this adjustment, the permit applicant should enter full rated wattage in column 05.
² Authority Having Jurisdiction may ask for Luminaire cut sheets to confirm wattage used for compliance per §130.0(c) Wattage used must be the maximum rated for the luminaire, not the lamp.

G. MODULAR LIGHTING SYSTEMS

This Section Does Not Apply

H. INDOOR LIGHTING CONTROLS (Not including PAFs)

*Table Instructions: Please include lighting controls for conditioned and unconditioned spaces in this table. When an option having a * is selected, the notes section of this table must be completed. The lighting controls section of the Compliance Summary Table on the first page will show "DOES NOT COMPLY" if the notes are left blank.*

01				02				03	
Mandatory Demand Response §110.12(c)				Shut-Off Controls §130.1(c)				Field Inspector	
Not Required ≤ 10,000 SF				See Area/Space Level Controls				Pass	Fail
<input type="checkbox"/>	<input type="checkbox"/>	<input type="checkbox"/>	<input type="checkbox"/>	<input type="checkbox"/>	<input type="checkbox"/>	<input type="checkbox"/>	<input type="checkbox"/>	<input type="checkbox"/>	<input type="checkbox"/>

04	05	06	07	08	09	10	11	12
Area Description	Complete Building or Area Category Primary Function Area	Area Controls §130.1(a)	Multi-Level Controls §130.1(b)	Shut-Off Controls §130.1(c)	Primary/Skylit Daylighting §130.1(d)	Secondary Daylighting §140.6(d)	Interlocked Systems §140.6(a)(1)	Field Inspector
ELECTRIC LIGHT ROOM	Electrical, Mechanical, Telephone Rooms	Manual ON/ OFF	Exempt*	Exempt*	NA	NA	<input type="checkbox"/>	Pass <input type="checkbox"/> Fail <input type="checkbox"/>

STATE OF CALIFORNIA Indoor Lighting WIC-LTI-E (Updated 04/21)		CALIFORNIA ENERGY COMMISSION NRCC-LTI-E Page 6 of 8 10-30-2022		
CERTIFICATE OF COMPLIANCE				
Project Name: AFFORDABLE HOUSING PROJECT		Report Page:		
Project Address: 415 NATURAL BRIDGES DRIVE		Date Prepared:		
N. ADDITIONAL LIGHTING ALLOWANCE: TAILORED ORNAMENTAL/SPECIAL EFFECTS				
This Section Does Not Apply				
O. ADDITIONAL LIGHTING ALLOWANCE: TAILORED VERY VALUABLE MERCHANDISE				
This Section Does Not Apply				
P. POWER ADJUSTMENT: LIGHTING CONTROL CREDIT (POWER ADJUSTMENT FACTOR (PAF))				
This Section Does Not Apply				
Q. RATED POWER REDUCTION COMPLIANCE FOR ALTERATIONS				
This Section Does Not Apply				
R. 80% LIGHTING POWER FOR ALTERATIONS - CONTROLS EXCEPTIONS				
This Section Does Not Apply				
S. DAYLIGHT DESIGN POWER ADJUSTMENT FACTOR (PAF)				
This Section Does Not Apply				
T. DECLARATION OF REQUIRED CERTIFICATES OF INSTALLATION				
Table Instructions: Selections have been made based on information provided in previous tables of this document. If any selection needs to be changed, please explain why in Table E. Additional Remarks. These documents must be provided to the building inspector during construction and can be found online at https://www2.energy.ca.gov/title24/2019standards/2019_compliance_documents/Nonresidential_Documents/NR/C/				
YES	NO	Form/Title	Field Inspector	
			Pass	Fail
<input checked="" type="radio"/>	<input type="radio"/>	NRCC-LTI-01-E - Must be submitted for all buildings	<input type="checkbox"/>	<input type="checkbox"/>
<input type="radio"/>	<input checked="" type="radio"/>	NRCC-LTI-02-E - Must be submitted for a lighting control system, or for an Energy Management Control System (EMCS), to be recognized for compliance.	<input type="checkbox"/>	<input type="checkbox"/>
<input type="radio"/>	<input checked="" type="radio"/>	NRCC-LTI-04-E - Must be submitted for two interlocked systems serving an auditorium, a convention center, a conference room, a multipurpose room, or a theater to be recognized for compliance.	<input type="checkbox"/>	<input type="checkbox"/>
<input type="radio"/>	<input checked="" type="radio"/>	NRCC-LTI-05-E - Must be submitted for a Power Adjustment Factor (PAF) to be recognized for compliance.	<input type="checkbox"/>	<input type="checkbox"/>

TITLE 24 - LIGHTING INTERIOR

STATE OF CALIFORNIA

Outdoor Lighting

CERTIFICATE OF COMPLIANCE

Project Name: AFFORDABLE HOUSING PROJECT

Project Address: 415 NATURAL BRIDGES DRIVE

Report Page: Page 1 of 6

Date Prepared: 10-30-2022

A. GENERAL INFORMATION

01 Project Location (city) SANTA CRUZ

02 Climate Zone 3

03 Outdoor Lighting Zone per Title 24, Part 1 §10-11.4 or as designated by Authority Having Jurisdiction (AHJ):

04 Total Illuminated Hardscape Area (ft²) 8,090.6

05 Luminaires Being Added or Altered

06 Luminaires Being Removed

07 Total Luminaires

08 Total Watts

09 Compliance

B. PROJECT SCOPE

Table Instructions: Include any outdoor lighting systems that are within the scope of the permit application and are demonstrating compliance using the prescriptive path outlined in §140.7 or §141.0(b)(2), for alterations.

My project consists of:

01 New Lighting System

02 Must Comply with Allowances from §140.7

03 Altered Lighting System

04 Is your alteration increasing the connected lighting load (Watts)?

05 Yes No

06 % of Existing Luminaires Being Altered

07 Sum Total of Luminaires Being Added or Altered

08 Calculation Method

09 % of Existing Luminaires Being Altered = (Sum Total of Luminaires Being Added or Altered / Existing Luminaires within the Scope of the Permit Application) x 100

C. COMPLIANCE RESULTS

Table Instructions: If any cell on this table says "DOES NOT COMPLY" or "COMPLIES with Exceptional Conditions" refer to Table D, for guidance.

Calculation of Total Allowed Lighting Power (Watts) §140.7 or §141.0(b)(2)

01 General Hardscape Allowance

02 Per Application

03 Sales Frontage

04 Ornamental

05 Per Specific Area

06 Existing Power

07 Total Allowed (Watts)

08 Total Actual (Watts)

09 07 Must be ≥ 08

10 Cutoff Compliance (See Table G for Details)

11 Controls Compliance (See Table H for Details)

12 COMPLIES

CA Building Energy Efficiency Standards - 2019 Nonresidential Compliance: <http://www.energy.ca.gov/title24/2019standards>

January 2021

STATE OF CALIFORNIA

Outdoor Lighting

CERTIFICATE OF COMPLIANCE

Project Name: AFFORDABLE HOUSING PROJECT

Project Address: 415 NATURAL BRIDGES DRIVE

Report Page: Page 4 of 6

Date Prepared: 10-30-2022

Table Continued

Table Instructions: Please complete this table for areas using the allowance calculations per §140.7. General Hardscape Allowance is per Table 140.7-A while "Use it or lose it" Allowances are per Table 140.7-B. Indicate which allowances are being used to expand sections for user input. Luminaires that qualify for one of the "Use it or lose it" allowances shall not qualify for another "Use it or lose it" allowance.

01 "Use it or lose it" Allowances (select all that apply)

02 General Hardscape Allowance

03 Per Application

04 Sales Frontage

05 Ornamental

06 Per Specific Area

07 Table I (below)

08 Table J

09 Table K

10 Table L

11 Table M

12 Calculated General Hardscape Lighting Power Allowance per Table 140.7-A (LZ 2 & 3)

13 02

14 03

15 04

16 05

17 06

18 07

19 08

20 09

21 10

22 Area Description

23 Surface Type

24 Illuminated Area (ft²)

25 Allowed Density (W/ft²)

26 Area Allowance (Watts)

27 Perimeter Length (ft)

28 Allowed Density (W/ft²)

29 Linear Allowance (Watts)

30 Total General AWA + LWA (Watts)

31 FRONT WALKWAY

32 Concrete

33 977.6

34 0.025

35 24.44

36 463

37 0.4

38 185.2

39 209.64

40 PARKING LOT

41 Asphalt

42 7,113

43 0.023

44 163.599

45 602

46 0.17

47 102.34

48 265.939

49 Initial Wattage Allowance for Entire Site (Watts): 250

50 Total General Hardscape Allowance (Watts): 725.579

J. LIGHTING ALLOWANCE: PER APPLICATION

This Section Does Not Apply

K. LIGHTING ALLOWANCE: SALES FRONTAGE

This Section Does Not Apply

L. LIGHTING ALLOWANCE: ORNAMENTAL

This Section Does Not Apply

M. LIGHTING ALLOWANCE: PER SPECIFIC AREA

This Section Does Not Apply

N. EXISTING CONDITIONS POWER ALLOWANCE (alterations only)

This Section Does Not Apply

CA Building Energy Efficiency Standards - 2019 Nonresidential Compliance: <http://www.energy.ca.gov/title24/2019standards>

January 2021

STATE OF CALIFORNIA

Outdoor Lighting

CERTIFICATE OF COMPLIANCE

Project Name: AFFORDABLE HOUSING PROJECT

Project Address: 415 NATURAL BRIDGES DRIVE

Report Page: Page 2 of 6

Date Prepared: 10-30-2022

D. EXCEPTIONAL CONDITIONS

This table is auto-filled with unedited comments because of selections made or data entered in tables throughout the form.

No exceptional conditions apply to this project.

E. ADDITIONAL REMARKS

This table includes remarks made by the permit applicant to the Authority Having Jurisdiction.

F. OUTDOOR LIGHTING FIXTURE SCHEDULE

Table Instructions: For new or altered lighting systems demonstrating compliance with §140.7 (ie Table I has been expanded for input), include all luminaires being installed and any existing luminaires remaining or being moved within the spaces covered by the permit application in the Table below. For altered lighting systems using the Existing Power method per §141.0(b)(2), (ie Table N has been expanded for input), include only new luminaires being installed and replacement luminaires being installed as part of the project scope (ie, do not include existing luminaires remaining or existing luminaires being moved).

Designed Wattage:

01

02

03

04

05

06

07

08

09

10

Name or Item Tag

Complete Luminaire Description

Watts per luminaire¹,²

How Wattage is determined

Total number luminaires²

Luminaire Status³

Excluded per §140.7(a)

Design Watts

Cutoff Req. ≥ 6,200 initial lumen output §130.2(b)⁴

Field Inspector

Pass

Fail

SA1 WALL MTG DOWN LIGHT

Linear

15

Mfr. Spec¹

11

New

165

NA: <6,200 lumens

SB1 POLE LIGHT

Linear

40

Mfr. Spec¹

1

New

40

NA: <6,200 lumens

SB2 POLE LIGHT

Linear

80

Mfr. Spec¹

1

New

80

NA: <6,200 lumens

SC1 BOLLARD

Linear

38.6

Mfr. Spec¹

6

New

231.6

NA: <6,200 lumens

SD1 DOWNLIGHT

Linear

21.3

Mfr. Spec¹

2

New

42.6

NA: <6,200 lumens

SE1 WALL MTG LIGHT

Linear

10

Mfr. Spec¹

2

New

20

NA: <6,200 lumens

Total Designed Watts: 579.2

NOTES: Selections with a * require a note in the space below explaining how compliance is achieved.
EX: Luminaire is lighting a statue; EXCEPTION 2 to §130.2(b).

CA Building Energy Efficiency Standards - 2019 Nonresidential Compliance: <http://www.energy.ca.gov/title24/2019standards>

January 2021

STATE OF CALIFORNIA

Outdoor Lighting

CERTIFICATE OF COMPLIANCE

Project Name: AFFORDABLE HOUSING PROJECT

Project Address: 415 NATURAL BRIDGES DRIVE

Report Page: Page 5 of 6

Date Prepared: 10-30-2022

O. DECLARATION OF REQUIRED CERTIFICATES OF INSTALLATION

Table Instructions: Selections have been made based on information provided in previous tables of this document. If any selection needs to be changed, please explain why in Table E. Additional Remarks. These documents must be provided to the building inspector during construction and can be found online at https://www.energy.ca.gov/title24/2019standards/2019_compliance_documents/Nonresidential_Documents/NRCL/.

YES NO Form/Title Field Inspector

Pass Fail

NRCL-LTO-01-E - Must be submitted for all buildings.

NRCL-LTO-02-E - Must be submitted for a lighting control system; or for an Energy Management Control System (EMCS), to be recognized for compliance.

P. DECLARATION OF REQUIRED CERTIFICATES OF ACCEPTANCE

Table Instructions: Selections have been made based on information provided in previous tables of this document. If any selection needs to be changed, please explain why in Table E. Additional Remarks. These documents must be provided to the building inspector during construction and must be completed through an Acceptance Test Technician Certification Provider (ATTCP). For more information visit: <http://www.energy.ca.gov/title24/attcp/providers.html>

YES NO Form/Title Field Inspector

Pass Fail

NRCL-LTO-02-A - Must be submitted for all outdoor lighting controls except for alterations where controls area added to ≤ 20 luminaires.

CA Building Energy Efficiency Standards - 2019 Nonresidential Compliance: <http://www.energy.ca.gov/title24/2019standards>

January 2021

STATE OF CALIFORNIA

Outdoor Lighting

CERTIFICATE OF COMPLIANCE

Project Name: AFFORDABLE HOUSING PROJECT

Project Address: 415 NATURAL BRIDGES DRIVE

Report Page: Page 3 of 6

Date Prepared: 10-30-2022

FOOTNOTES: Authority Having Jurisdiction may ask for Luminaire cut sheets to confirm wattage used for compliance per §130.0(c).
² For linear luminaires, wattage should be indicated as W/ft instead of Watts/luminaire. Total linear feet for the luminaire should be indicated in column 05 instead of number of luminaires.
³ Select "New" for new luminaires in a new outdoor lighting project or for added luminaires in an alteration. Select "Altered" for replacement luminaires in an alteration. Select "Existing to Remain" for existing luminaires within the project scope that are not being altered and are remaining. Select "Existing Reinstalled" for existing luminaires which are being removed and reinstalled as part of the project scope.
⁴ Compliance with mandatory cutoff requirements is required for luminaires with initial lumen output ≥ 6,200 unless exempted by §130.2(b).

G. CUTOFF REQUIREMENTS (BUG)

This Section Does Not Apply

H. OUTDOOR LIGHTING CONTROLS

Table Instructions: Complete this table demonstrating compliance with controls requirements for all new or altered luminaires installed as part of the permit application. For alteration projects, luminaires which are existing to remain (ie untouched) and luminaires which are removed and reinstalled (wiring only) do not need to be included in this table even if they are within the spaces covered by the permit application.
When an option having a * is selected, the notes section of this table must be completed. The lighting controls section of the Compliance Summary Table on the first page will show "DOES NOT COMPLY" if the notes are left blank. For each requirement in columns 02 through 04, do not leave the field blank, instead select NA or Exempt* from the dropdown list to indicate not applicable or an exemption.

Mandatory Controls

01

02

03

04

05

Area Description

Shut-Off §130.2(c)1

Auto-Schedule §130.2(c)2

Motion Sensor §130.2(c)3

Field Inspector

Pass

Fail

FRONT WALKWAY

Photocontrol

Yes

Yes

PARKING LOT

Photocontrol

Yes

Yes

NOTES: Controls with a * require a note in the space below explaining how compliance is achieved.
EX: Not permitted by health & safety to be turned off; EXCEPTION 1 to §130.2(c).

I. LIGHTING POWER ALLOWANCE (per §140.7)

Table Continued

CA Building Energy Efficiency Standards - 2019 Nonresidential Compliance: <http://www.energy.ca.gov/title24/2019standards>

January 2021

STATE OF CALIFORNIA

Outdoor Lighting

CERTIFICATE OF COMPLIANCE

Project Name: AFFORDABLE HOUSING PROJECT

Project Address: 415 NATURAL BRIDGES DRIVE

Report Page: Page 6 of 6

Date Prepared: 10-30-2022

DOCUMENTATION AUTHOR'S DECLARATION STATEMENT

I certify that this Certificate of Compliance documentation is accurate and complete

Documentation Author Name: DAVID SMITH, PE

Documentation Author Signature: David Smith

Company: CENTRAL PACIFIC ENGINEERING, INC

Signature Date: 10-30-22

Address: 9035 SOQUEL AVE, SUITE 205

CEA/ HERS Certification Identification (if applicable):

City/State/Zip: SANTA CRUZ, CA 95062

Phone: 831-476-1525

RESPONSIBLE PERSON'S DECLARATION STATEMENT

I certify the following under penalty of perjury, under the laws of the State of California:

1. The information provided on this Certificate of Compliance is true and correct.

2. I am eligible under Division 3 of the Business and Professions Code to accept responsibility for the building design or system design identified on this Certificate of Compliance (responsible designer).

3. The energy features and performance specifications, materials, components, and manufactured devices for the building design or system design identified on this Certificate of Compliance conform to the requirements of Title 24, Part 1 and Part 6 of the California Code of Regulations.

4. The building design features or system design features identified on this Certificate of Compliance are consistent with the information provided on other applicable compliance documents, worksheets, calculations, plans and specifications submitted to the enforcement agency for approval with this building permit application.

5. I will ensure that a completed signed copy of this Certificate of Compliance shall be made available with the building permit(s) issued for the building, and made available to the enforcement agency for all applicable inspections. I understand that a completed signed copy of this Certificate of Compliance is required to be included with the documentation the builder provides to the building owner at occupancy.

Responsible Designer Name: DAVID SMITH, PE

Responsible Designer Signature: David Smith

Company: CENTRAL PACIFIC ENGINEERING, INC

Date Signed: 10-30-22

Address: 9035 SOQUEL AVE, SUITE 205

License: CA-E13492

City/State/Zip: SANTA CRUZ, CA 95062

Phone: 831-476-1525

CA Building Energy Efficiency Standards - 2019 Nonresidential Compliance: <http://www.energy.ca.gov/title24/2019standards>

January 2021

TITLE 24 - LIGHTING EXTERIOR

PROPRIETARY DATA

THE USE OF THE PLANS AND SPECIFICATIONS IS LIMITED TO THE PROJECT FOR WHICH THEY WERE PREPARED, AND NO PART OF THEM SHALL BE REPRODUCED OR TRANSMITTED IN ANY FORM OR BY ANY MEANS, ELECTRONIC OR MECHANICAL, INCLUDING PHOTOCOPYING, RECORDING, OR BY ANY INFORMATION STORAGE AND RETRIEVAL SYSTEM, WITHOUT THE WRITTEN PERMISSION OF THE ENGINEER. THE ENGINEER'S LIABILITY IS LIMITED TO THE PROFESSIONAL ENGINEERING AND ARCHITECTURAL SERVICES PROVIDED BY HIMSELF OR HERSELF, AND NO OTHER LIABILITY SHALL BE ASSUMED BY THE ENGINEER. THE ENGINEER'S LIABILITY IS LIMITED TO THE PROFESSIONAL ENGINEERING AND ARCHITECTURAL SERVICES PROVIDED BY HIMSELF OR HERSELF, AND NO OTHER LIABILITY SHALL BE ASSUMED BY THE ENGINEER.

REGISTERED PROFESSIONAL ENGINEER
DATE GRANTED: 11/15/2011
EXPIRATION DATE: 09-30-24
ELECTRICAL
STATE OF CALIFORNIA

Central Pacific Engineering, Inc.
Professional Engineers
9035 Soquel Avenue, Suite 205
Santa Cruz, CA 95062
831-476-1525
CPE JOB 21-044-0

TITLE: AFFORDABLE HOUSING PROJECT

LOCATION: 415 NATURAL BRIDGES DRIVE
SANTA CRUZ, CALIFORNIA

OWNER: THE HOUSING AUTHORITY OF THE COUNTY OF SANTA CRUZ

DR: SAK

DATE: 04/20/22

CHK: DGS

APPRO: DGS

SCALE: AS NOTED

JOB NO. 21-044-0

DWG. NO. E0.20

SH 3 OF 32

REV. 1

STATE OF CALIFORNIA

Electrical Power Distribution

NRCC-ELC-E (Created 11/19)

CALIFORNIA ENERGY COMMISSION

NRCC-ELC-E

CERTIFICATE OF COMPLIANCE

This document is used to demonstrate compliance with mandatory requirements in §130.5 for electrical systems in newly constructed nonresidential, high-rise residential and hotel/motel occupancies. Additions and alterations to electrical service systems in these occupancies will also use this document to demonstrate compliance per §141.0(a) or §141.0(b)(2) for alterations.

Project Name: AFFORDABLE HOUSING PROJECT

Report Page: Page 1 of 5

Project Address: 415 NATURAL BRIDGES DRIVE

Date Prepared: 08-15-2022

A. GENERAL INFORMATION

01 Project Location (city) SANTA CRUZ

02 Occupancy Types Within Project:

☒ Office ☐ Retail ☐ Warehouse ☐ Hotel/ Motel ☐ School ☐ Support Areas

☐ Parking Garage ☒ High-Rise Residential ☐ Relocatable ☐ Healthcare Facilities ☐ Other (Write in):

B. PROJECT SCOPE

Table Instructions: Include any electrical service systems that are within the scope of the permit application.

01 02 03 04 05 06

Electrical Service Designation/ Description Scope of Work¹ Rating (kVA) Utility Provided Metering System Exception to §130.5(a)² System subject to CA Elec Code Article §17 Exception to §130.5(a)&(b) Where required, demand response controls must be specified which are capable of receiving and automatically responding to at least one standards based messaging protocol which enables demand response after receiving a demand response signal. Sections §120.2, §130.1 and §130.3 and compliance documents NRCC-MCH, NRCC-LTI and NRCC-LTS will indicate when demand response controls are required.

MAIN PANEL New electrical service equipment & meter 432 ☒

¹ FOOTNOTES: Adding only new feeders and branch circuits triggers Voltage Drop §130.5(c), no other requirements from §130.5 are required.

² Applicable if the utility company is providing a metering system that indicates instantaneous kW demand and kWh for a utility-defined period.

C. COMPLIANCE RESULTS

Table Instructions: If this table says "DOES NOT COMPLY" refer to Table D. for guidance and review the Table that indicates "No".

01 02 03 04 05

Service Electrical Metering §130.5(a) AND Separation for Monitoring §130.5(b) AND Voltage Drop §130.5(c) AND Controlled Receptacles §130.5(d) Compliance Results

(See Table F) (See Table G) (See Table H) (See Table I)

AND Yes AND Yes AND Yes COMPLIES with Exceptional Conditions

CA Building Energy Efficiency Standards - 2019 Nonresidential Compliance: <http://www.energy.ca.gov/title24/2019standards>

November 2019

STATE OF CALIFORNIA

Electrical Power Distribution

NRCC-ELC-E (Created 11/19)

CALIFORNIA ENERGY COMMISSION

NRCC-ELC-E

CERTIFICATE OF COMPLIANCE

Project Name: AFFORDABLE HOUSING PROJECT

Report Page: Page 2 of 5

Project Address: 415 NATURAL BRIDGES DRIVE

Date Prepared: 08-15-2022

D. EXCEPTIONAL CONDITIONS

This table is auto-filled with uneditable comments because of selections made or data entered in tables throughout the form.

Table B indicates the project is exempt from §130.5(a) Service Electrical Metering requirements because the utility company has provided the project a metering system that indicates instantaneous kW demand and kWh for a utility-defined period.

E. ADDITIONAL REMARKS

This table includes remarks made by the permit applicant to the Authority Having Jurisdiction.

F. SERVICE ELECTRICAL METERING

This Section Does Not Apply

G. SEPARATION OF ELECTRICAL CIRCUITS FOR ENERGY MONITORING

Table Instructions: Complete this table for entirely new or complete replacement electrical power distribution systems to demonstrate compliance with §130.5(b). Using the dropdown choices in column 01, indicate the load types included for each service. Any load types that are not included in the service do not need to be shown.

Electrical Service Designation/Description: MAIN PANEL

01 02 03 04 05

Load Type per Table 130.5-B¹ Minimum Required Separation of Load per Table 130.5-B Compliance Method² Location of Requirements in Construction Documents Field Inspector

Plug Loads and appliances < 25kVA All plug load separated by floor, type or area Groups of plug loads exceeding 25 kVA connected load in an area less than 5000 sf Method 1 E5.00 ☐ ☐

* NOTES: If "Other" is selected under Compliance Method above, please indicate how compliance has been achieved in the space provided below.

¹ FOOTNOTES: For each separate load type, up to 10% of the connected load may be of any type.

² Method 1: Switchboards/ motor control centers/ panelboard loads disaggregated for each load type

Method 2: Switchboards/ motor control centers/ panelboard supply other distribution equipment with loads disaggregated for each load type

Method 3: Branch circuits serve load types individually & provisions for adding future branch circuit monitoring

Method 4: Complete metering system measures and reports loads by type

See Chapter 8 of the Nonresidential Compliance Manual for more detail on Compliance Methods.

CA Building Energy Efficiency Standards - 2019 Nonresidential Compliance: <http://www.energy.ca.gov/title24/2019standards>

November 2019

STATE OF CALIFORNIA

Electrical Power Distribution

NRCC-ELC-E (Created 11/19)

CALIFORNIA ENERGY COMMISSION

NRCC-ELC-E

CERTIFICATE OF COMPLIANCE

Project Name: AFFORDABLE HOUSING PROJECT

Report Page: Page 3 of 5

Project Address: 415 NATURAL BRIDGES DRIVE

Date Prepared: 08-15-2022

H. VOLTAGE DROP

Table Instructions: Please complete this table for entirely new or complete replacement electrical power distribution systems, or alterations that add, modify or replace both feeders and branch circuits to demonstrate compliance with §130.5(c). For alterations, only the altered circuits must demonstrate compliance per §141.0(b)(2)(ii).

01 02 03 04 05

Electrical Service Designation/ Description Combined Voltage Drop on Installed Feeder/Branch Circuit Conductors Compliance Method Location of Voltage Drop Calculations¹ Sheet Number for Voltage Drop Calculations in Construction Documents Field Inspector

MAIN PANEL ☒ Voltage drop < 5% ☐ Permitted by CA Elec Code (Exception to §130.5(c))² In construction documents E5.00- FEEDER SCHEDULE ☐ ☐

*NOTES If "Permitted by CA Elec Code" is selected under Compliance Method above, please indicate where the exception applies in the space provided below.

¹ FOOTNOTES: Voltage drop calculations may be attached to the permit application outside the construction documents if allowed by the Authority Having Jurisdiction. Select "attached" if applicable. If calculations will be the responsibility of the installing contractor, select "Contractor Responsible".

I. CIRCUIT CONTROLS FOR 120-VOLT RECEPTACLES AND CONTROLLED RECEPTACLES

Table Instructions: Please complete this table for entirely new or complete replacement electrical power distribution systems to demonstrate compliance with §130.5(d). Both controlled and uncontrolled receptacles must be provided in office areas, lobbies, conference rooms, kitchen areas in office spaces, copy rooms and hotel/motel guest rooms.

01 02 03 04 05 06

Room Name or Description Location/ Type of Controlled Receptacles Shut-Off Controls Permanent Durable Marking Will be Used Location of Requirements in Construction Documents Field Inspector

OFFICE Within 6ft of uncontrolled receptacles Occupancy Sensor ☒ E3.10 ☐ ☐

* If "Other" is selected under Compliance Method above, please indicate how compliance has been achieved in the space provided below.

J. DECLARATION OF REQUIRED CERTIFICATES OF INSTALLATION

Table Instructions: Selections have been made based on information provided in previous tables of this document. If any selection needs to be changed, please explain why in Table E. Additional Remarks. These documents must be provided to the building inspector during construction and can be found online at https://www2.energy.ca.gov/title24/2019standards/2019_compliance_documents/Nonresidential_Documents/NRCC/

YES NO Form/Title Field Inspector

☒ ☐ NRCC-ELC-01-E - Must be submitted for all buildings. ☐ ☐

CA Building Energy Efficiency Standards - 2019 Nonresidential Compliance: <http://www.energy.ca.gov/title24/2019standards>

November 2019

STATE OF CALIFORNIA

Electrical Power Distribution

NRCC-ELC-E (Created 11/19)

CALIFORNIA ENERGY COMMISSION

NRCC-ELC-E

CERTIFICATE OF COMPLIANCE

Project Name: AFFORDABLE HOUSING PROJECT

Report Page: Page 4 of 5

Project Address: 415 NATURAL BRIDGES DRIVE

Date Prepared: 08-15-2022

K. DECLARATION OF REQUIRED CERTIFICATES OF ACCEPTANCE

There are no Certificates of Acceptance applicable to electrical power distribution requirements.

CA Building Energy Efficiency Standards - 2019 Nonresidential Compliance: <http://www.energy.ca.gov/title24/2019standards>

November 2019

STATE OF CALIFORNIA

Electrical Power Distribution

NRCC-ELC-E (Created 11/19)

CALIFORNIA ENERGY COMMISSION

NRCC-ELC-E

CERTIFICATE OF COMPLIANCE

Project Name: AFFORDABLE HOUSING PROJECT

Report Page: Page 5 of 5

Project Address: 415 NATURAL BRIDGES DRIVE

Date Prepared: 08-15-2022

DOCUMENTATION AUTHOR'S DECLARATION STATEMENT

I certify that this Certificate of Compliance documentation is accurate and complete.

Documentation Author Name: DAVID SMITH, PE Documentation Author Signature: David Smith

Company: CENTRAL PACIFIC ENGINEERING, INC Signature Date: 08-15-2022

Address: 9035 SOQUEL AVE, SUITE 205 CEA/ HERS Certification Identification (if applicable):

City/State/Zip: SANTA CRUZ, CA 95062 Phone: 831-476-1525

RESPONSIBLE PERSON'S DECLARATION STATEMENT

I certify the following under penalty of perjury, under the laws of the State of California:

1. The information provided on this Certificate of Compliance is true and correct.

2. I am eligible under Division 3 of the Business and Professions Code to accept responsibility for the building design or system design identified on this Certificate of Compliance (responsible designer)

3. The energy features and performance specifications, materials, components, and manufactured devices for the building design or system design identified on this Certificate of Compliance conform to the requirements of Title 24, Part 1 and Part 6 of the California Code of Regulations.

4. The building design features or system design features identified on this Certificate of Compliance are consistent with the information provided on other applicable compliance documents, worksheets, calculations, plans and specifications submitted to the enforcement agency for approval with this building permit application.

5. I will ensure that a completed signed copy of this Certificate of Compliance shall be made available with the building permit(s) issued for the building, and made available to the enforcement agency for all applicable inspections. I understand that a completed signed copy of this Certificate of Compliance is required to be included with the documentation the builder provides to the building owner at occupancy.

Responsible Designer Name: DAVID SMITH, PE Responsible Designer Signature: David Smith

Company: CENTRAL PACIFIC ENGINEERING, INC Date Signed: 08-15-2022

Address: 9035 SOQUEL AVE, SUITE 205 License: CA-E13492, EXP 09-30-2020

City/State/Zip: SANTA CRUZ, CA 95062 Phone: 831-476-1525

CA Building Energy Efficiency Standards - 2019 Nonresidential Compliance: <http://www.energy.ca.gov/title24/2019standards>

November 2019

PROPRIETARY DATA

THE USE OF THE PLANS AND SPECIFICATIONS IS LIMITED TO THE PROJECT FOR WHICH THEY WERE PREPARED, AND NO PART OF THEM MAY BE REPRODUCED OR TRANSMITTED IN ANY FORM OR BY ANY MEANS, ELECTRONIC OR MECHANICAL, INCLUDING PHOTOCOPYING, RECORDING, OR BY ANY INFORMATION STORAGE AND RETRIEVAL SYSTEM, WITHOUT THE WRITTEN PERMISSION OF THE ENGINEERING FIRM. IF ANY PART OF THESE PLANS OR SPECIFICATIONS IS USED FOR ANY OTHER PROJECT, THE USER ASSUMES ALL LIABILITY FOR ANY VIOLATIONS OF ANY APPLICABLE CODES, ORDINANCES, RULES, REGULATIONS, OR STANDARDS. THE ENGINEERING FIRM ASSUMES NO LIABILITY FOR ANY SUCH VIOLATIONS.

REGISTERED PROFESSIONAL ENGINEER
DAVID GRANT SMITH
ELECTRICAL
EXPIRATION DATE: 09-30-24
STATE OF CALIFORNIA

Central Pacific Engineering, Inc.
Professional Engineers
9035 Soquel Avenue, Suite 205
Santa Cruz, CA 95062
831-476-1525
CPE JOB 21-044-0

REV. DESCRIPTION DATE

1 ISSUED FOR PLAN CHECK 08/27/22

2 PLAN CHECK & OWNER COMMENTS 10/14/22

3

4

5

6

TITLE: AFFORDABLE HOUSING PROJECT

JOB NO. 21-044-0

DWG. NO. E0.30

SH 4 OF 32 REV. 1

LOCATION: 415 NATURAL BRIDGES DRIVE
SANTA CRUZ, CALIFORNIA

OWNER: THE HOUSING AUTHORITY OF THE COUNTY OF SANTA CRUZ


DR. DATE 04/20/22

CHK. DGS

APPD. DGS

SCALE AS NOTED

TITLE 24 - ELECTRICAL POWER DISTRIBUTION

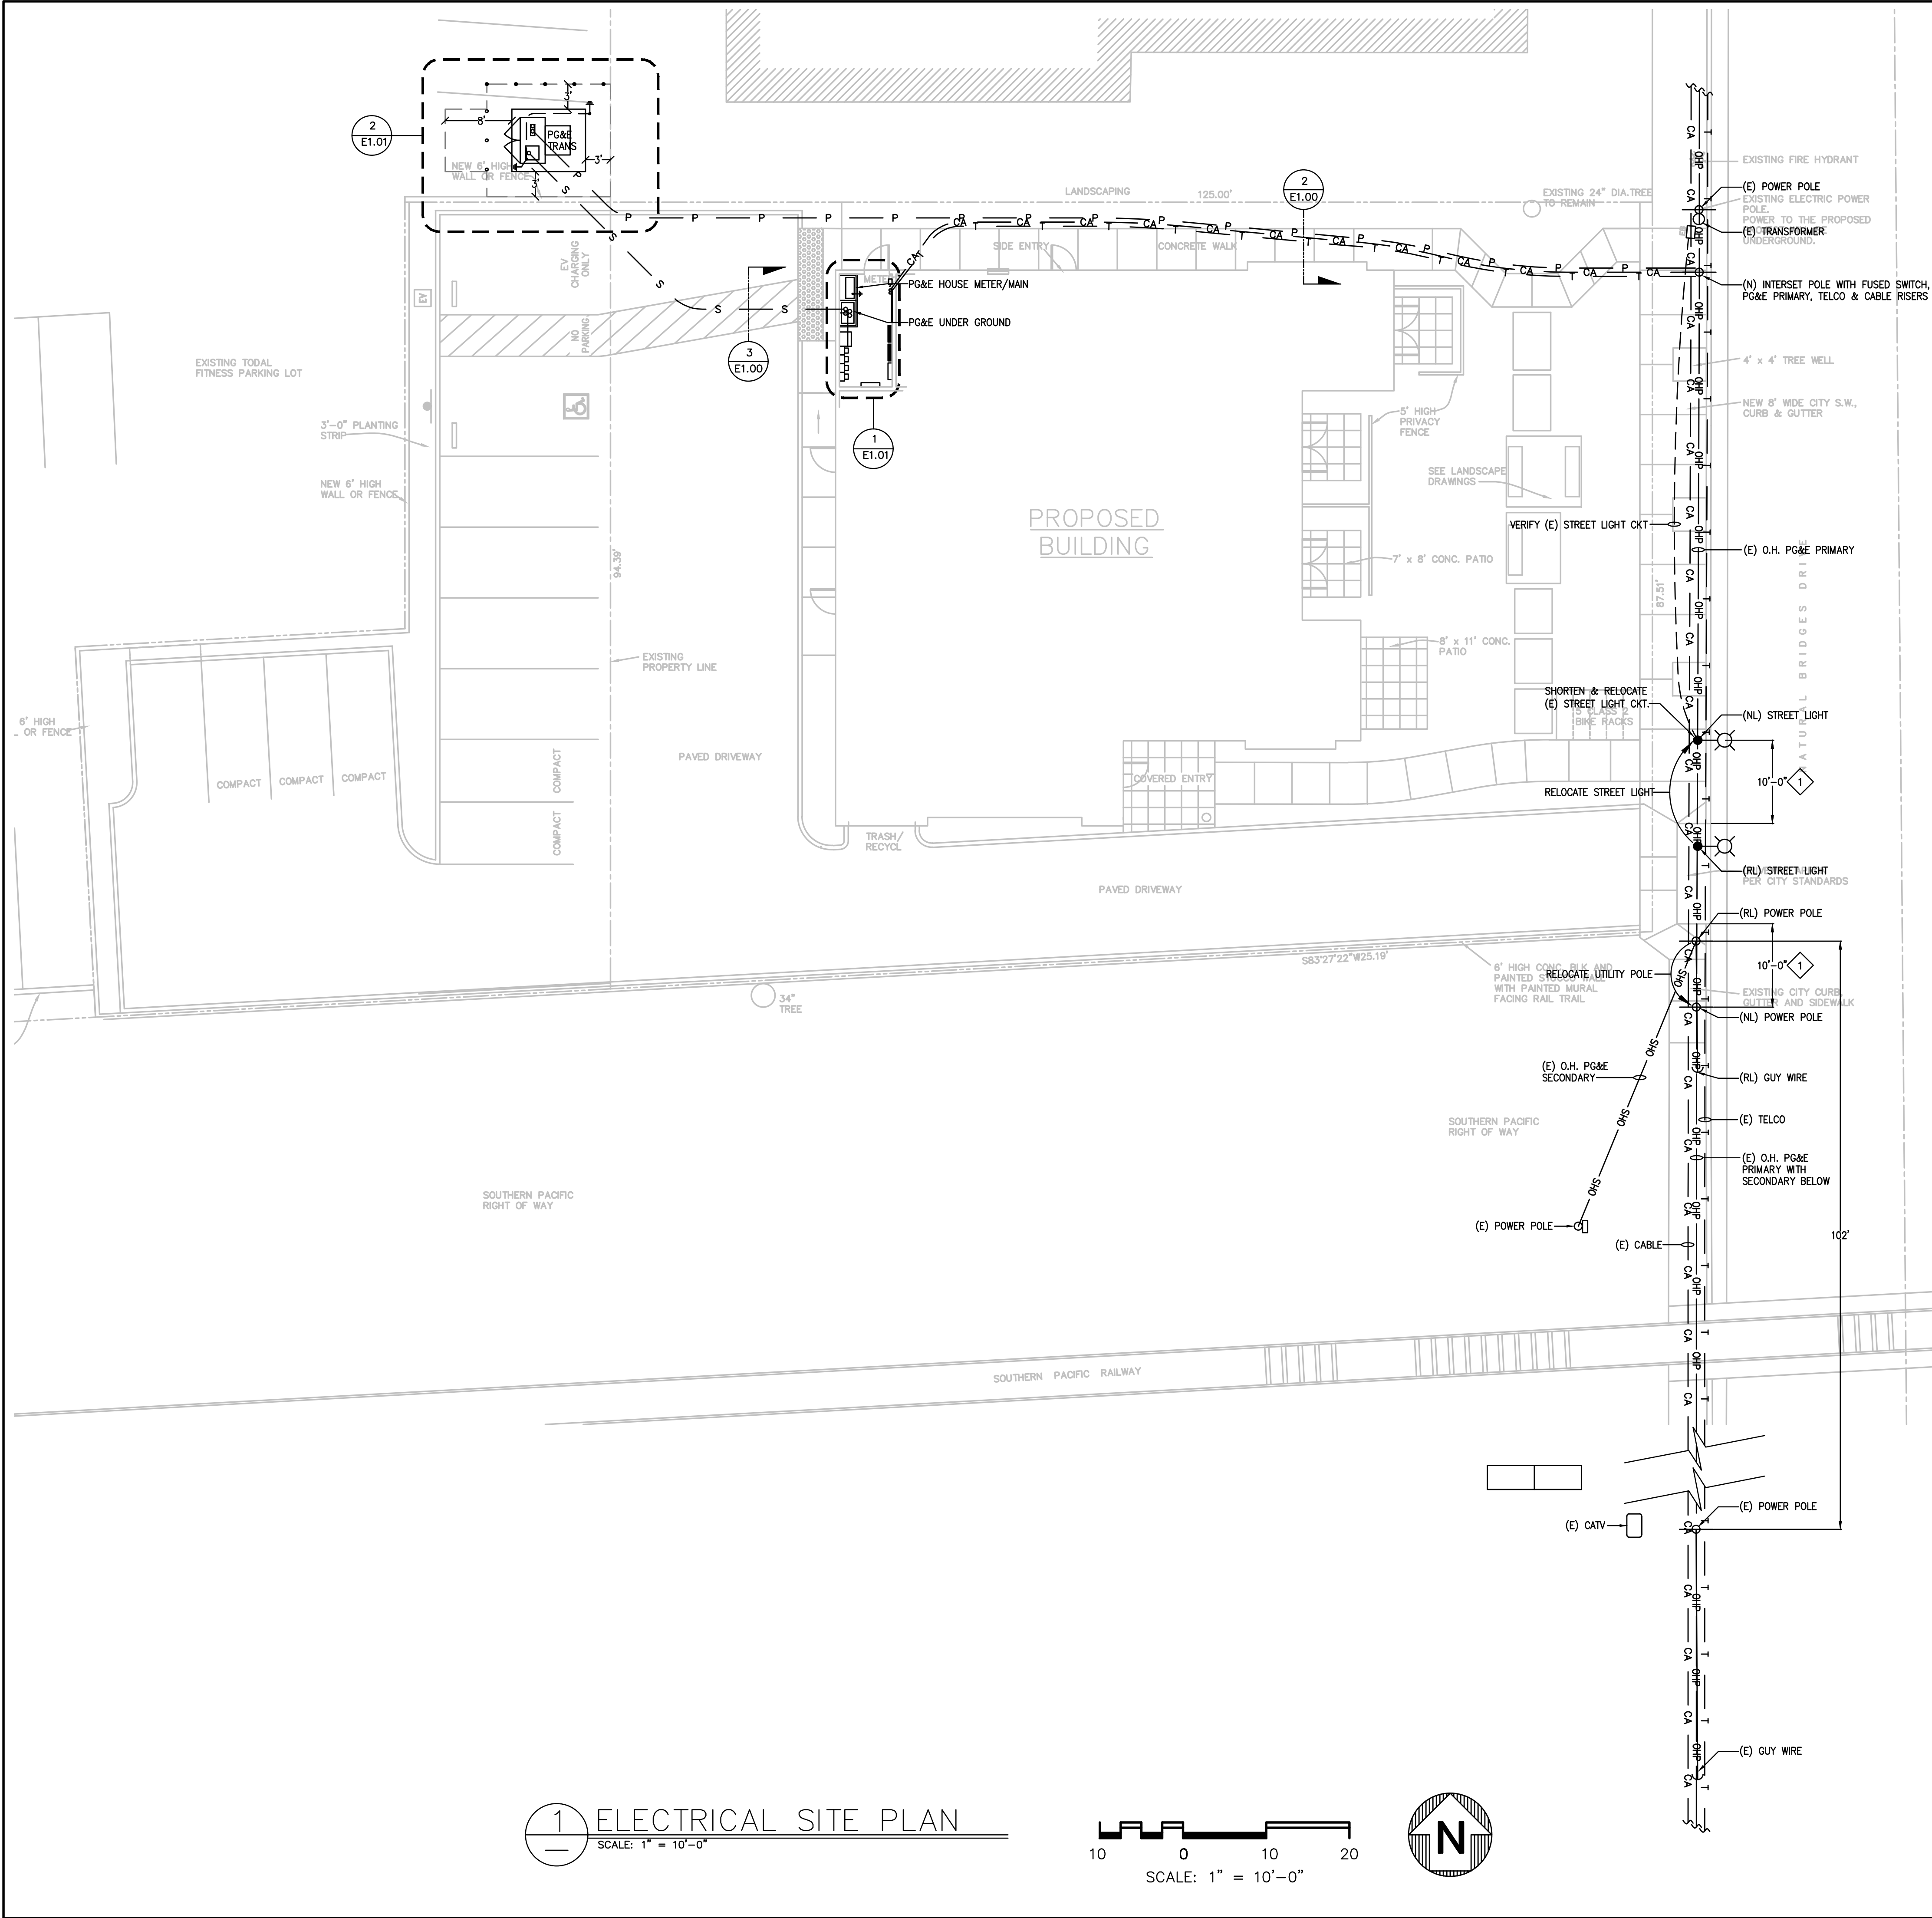

SHEET NOTES:

- CITY REQUIRED SETBACK FROM DRIVEWAY ENTRANCE.


SHEET LEGEND

P	P	UG PRIMARY
S	S	UG SECONDARY
OHP	OHP	OVERHEAD PRIMARY
OHS	OHS	OVERHEAD SECONDARY
T	T	TELCO - AT&T
CA	CA	CABLE SERVICE - COMCAST

STANDARD PG&E UTILITY SHOWN HEREON, IN WHOLE OR IN PART, ARE FOR THE CONVENIENCE OF THE CONTRACTOR ONLY. ALL SAID DETAILS SHALL BE VERIFIED WITH PG&E PRIOR TO CONSTRUCTION. THE ENGINEER DOES NOT ASSUME ANY RESPONSIBILITY FOR CONSTRUCTION ERRORS DUE TO THE USE OF DETAILS SHOWN HEREON FOR ACTUAL CONSTRUCTION.

CONDUIT SEPARATION TABLE						
FACILITY	GAS	TELEPHONE (CONDUIT)	TELEPHONE (DIRECT BURIED)	CABLE TELEVISION	SECONDARY ELECTRIC	PRIMARY ELECTRIC
ALL MEASUREMENTS ARE IN INCHES						
GAS	N/A	12	12	12	6	12
TELEPHONE (CONDUIT)	12	N/A	1	1	12	12
TELEPHONE (DIRECT BURIED)	12	1	N/A	1	12	12
CABLE TELEVISION	12	1	1	N/A	12	12
SECONDARY ELECTRIC	6	12	12	12	N/A	3
PRIMARY ELECTRIC	12	12	12	12	3	N/A


NOTE: GREATER DEPTH MAY BE NECESSARY AT THE RISER, DEPENDING ON THE RADIUS OF RISER SWEEP USED.

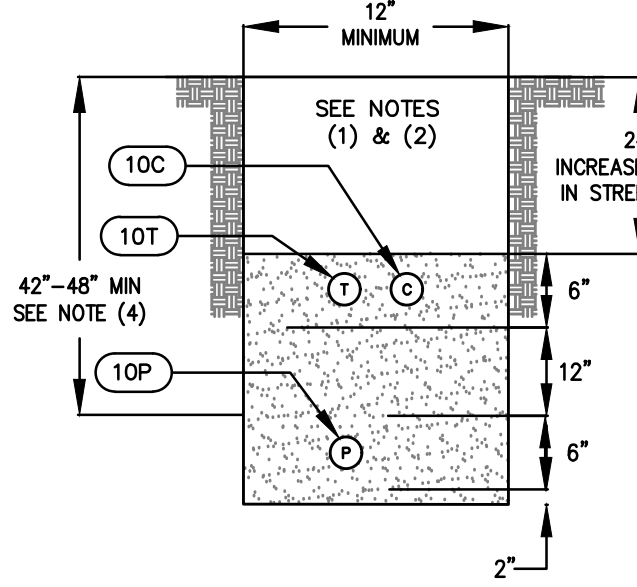

- NOTES:
- ROCKFREE EARTHILL (SAND OR NATIVE SOIL WHEN SUITABLE) +12" MIN. SHALL BE USED BY THE CONTRACTOR TO PROVIDE A SMOOTH BEDDING AND COVER FOR THE CONDUIT. SOILS CONTAINING OCCASIONAL ROUNDED ROCKS LESS THAN 1/2" DIAMETER IS ACCEPTABLE BACKFILL. CRUSHED ROCK OR SHARP-EDGED MATERIALS OF ANY KIND ARE UNACCEPTABLE. FROM A LEVEL 4" BELOW TO 6" ABOVE ALL FACILITIES WITHIN TRENCH AREA. FILL TO BE AT 90% COMPACTION. SANDFILL TO BE AT +12", 90% COMPACTION.
 - BACKFILL AND COMPACTION TO MEET CIVIL, CITY, COUNTY, STATE REQUIREMENTS.
 - DEPTHS AND SEPARATIONS SHOWN ARE MINIMUMS.
 - ADDITIONAL DEPTH MUST BE PROVIDED TO MAINTAIN THE REQUIRED SEPARATION AND COVER IF OTHER FACILITIES CROSS ELECTRIC, TELEPHONE, OR CABLE TELEVISION FACILITIES.

2 TRENCH DETAIL

NO SCALE

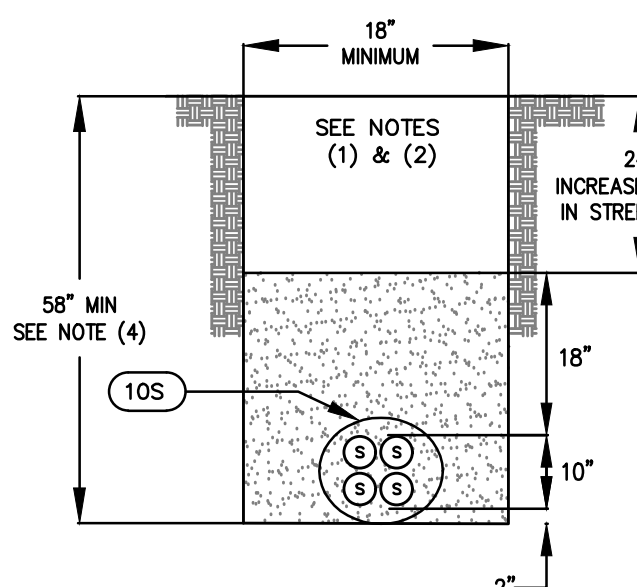

- NOTES:
- ROCKFREE EARTHILL (SAND OR NATIVE SOIL WHEN SUITABLE) +12" MIN. SHALL BE USED BY THE CONTRACTOR TO PROVIDE A SMOOTH BEDDING AND COVER FOR THE CONDUIT. SOILS CONTAINING OCCASIONAL ROUNDED ROCKS LESS THAN 1/2" DIAMETER IS ACCEPTABLE BACKFILL. CRUSHED ROCK OR SHARP-EDGED MATERIALS OF ANY KIND ARE UNACCEPTABLE. FROM A LEVEL 4" BELOW TO 6" ABOVE ALL FACILITIES WITHIN TRENCH AREA. FILL TO BE AT 90% COMPACTION. SANDFILL TO BE AT +12", 90% COMPACTION.
 - BACKFILL AND COMPACTION TO MEET CIVIL, CITY, COUNTY, STATE REQUIREMENTS.
 - DEPTHS AND SEPARATIONS SHOWN ARE MINIMUMS.
 - ADDITIONAL DEPTH MUST BE PROVIDED TO MAINTAIN THE REQUIRED SEPARATION AND COVER IF OTHER FACILITIES CROSS ELECTRIC, TELEPHONE, OR CABLE TELEVISION FACILITIES.

3 TRENCH DETAIL

NO SCALE

PROPRIETARY DATA

THE USE OF THE PLANS AND SPECIFICATIONS IS LIMITED TO THE PROJECT AND SITE FOR WHICH THEY WERE PREPARED, AND NO PUBLICATION THEREOF IS PERMITTED WITHOUT THE WRITTEN CONSENT OF THE ENGINEER. ANY REUSE OR MODIFICATION OF THE PLANS OR SPECIFICATIONS FOR ANY OTHER PROJECT WITHOUT THE WRITTEN CONSENT OF THE ENGINEER SHALL BE AT THE USER'S SOLE RISK AND WITHOUT LIABILITY TO THE ENGINEER. THE USER AGREES TO HOLD THE ENGINEER HARMLESS FROM ANY AND ALL CLAIMS, DAMAGES, LOSSES, AND EXPENSES, INCLUDING ATTORNEY'S FEES, THAT MAY BE ASSERTED AGAINST THE ENGINEER BY ANY THIRD PARTY AS A RESULT OF SUCH REUSE OR MODIFICATION.





REGISTERED PROFESSIONAL ENGINEER
DATE GRANTED: 08-30-24
EXPIRATION DATE: 08-30-24
ELECTRICAL
STATE OF CALIFORNIA


AFFORDABLE HOUSING PROJECT

TITLE: 415 NATURAL BRIDGES DRIVE
SANTA CRUZ, CALIFORNIA
OWNER: THE HOUSING AUTHORITY OF THE COUNTY OF SANTA CRUZ
DR: SAK
CHK: DGS
DATE: 04/20/22
AS NOTED

JOB NO. 21-044-0
DWG. NO. E100
SH 5 OF 32
REV. 1


ELECTRICAL SITE PLAN

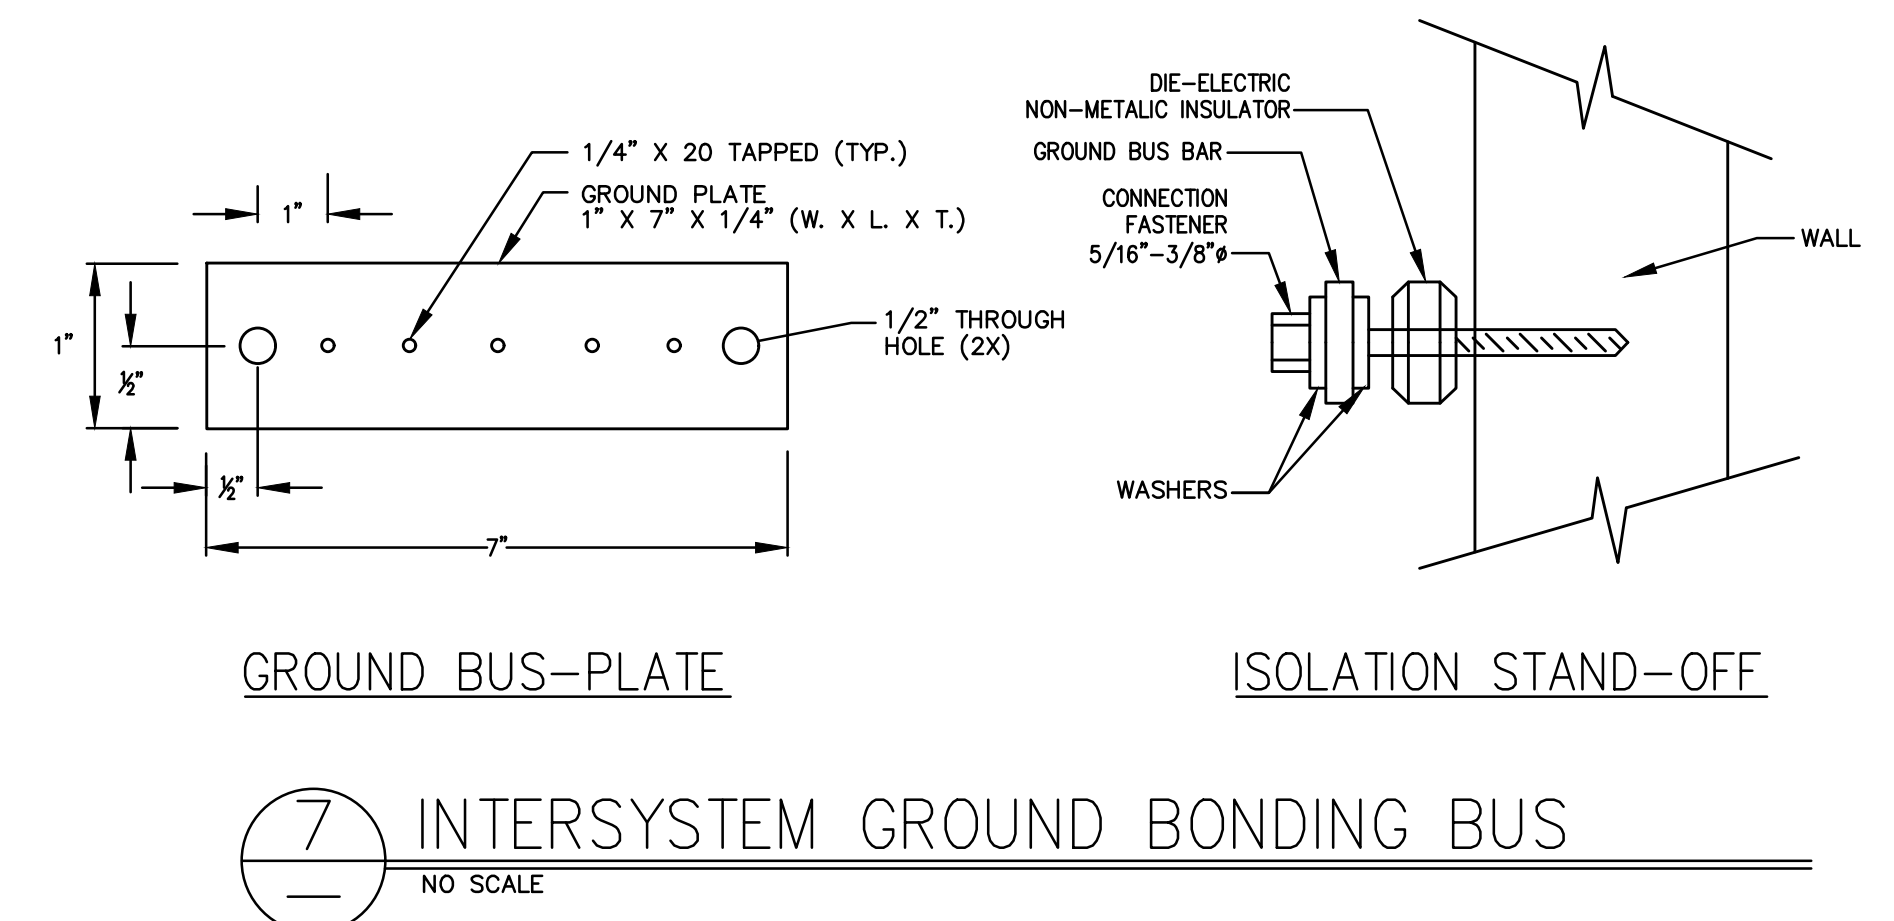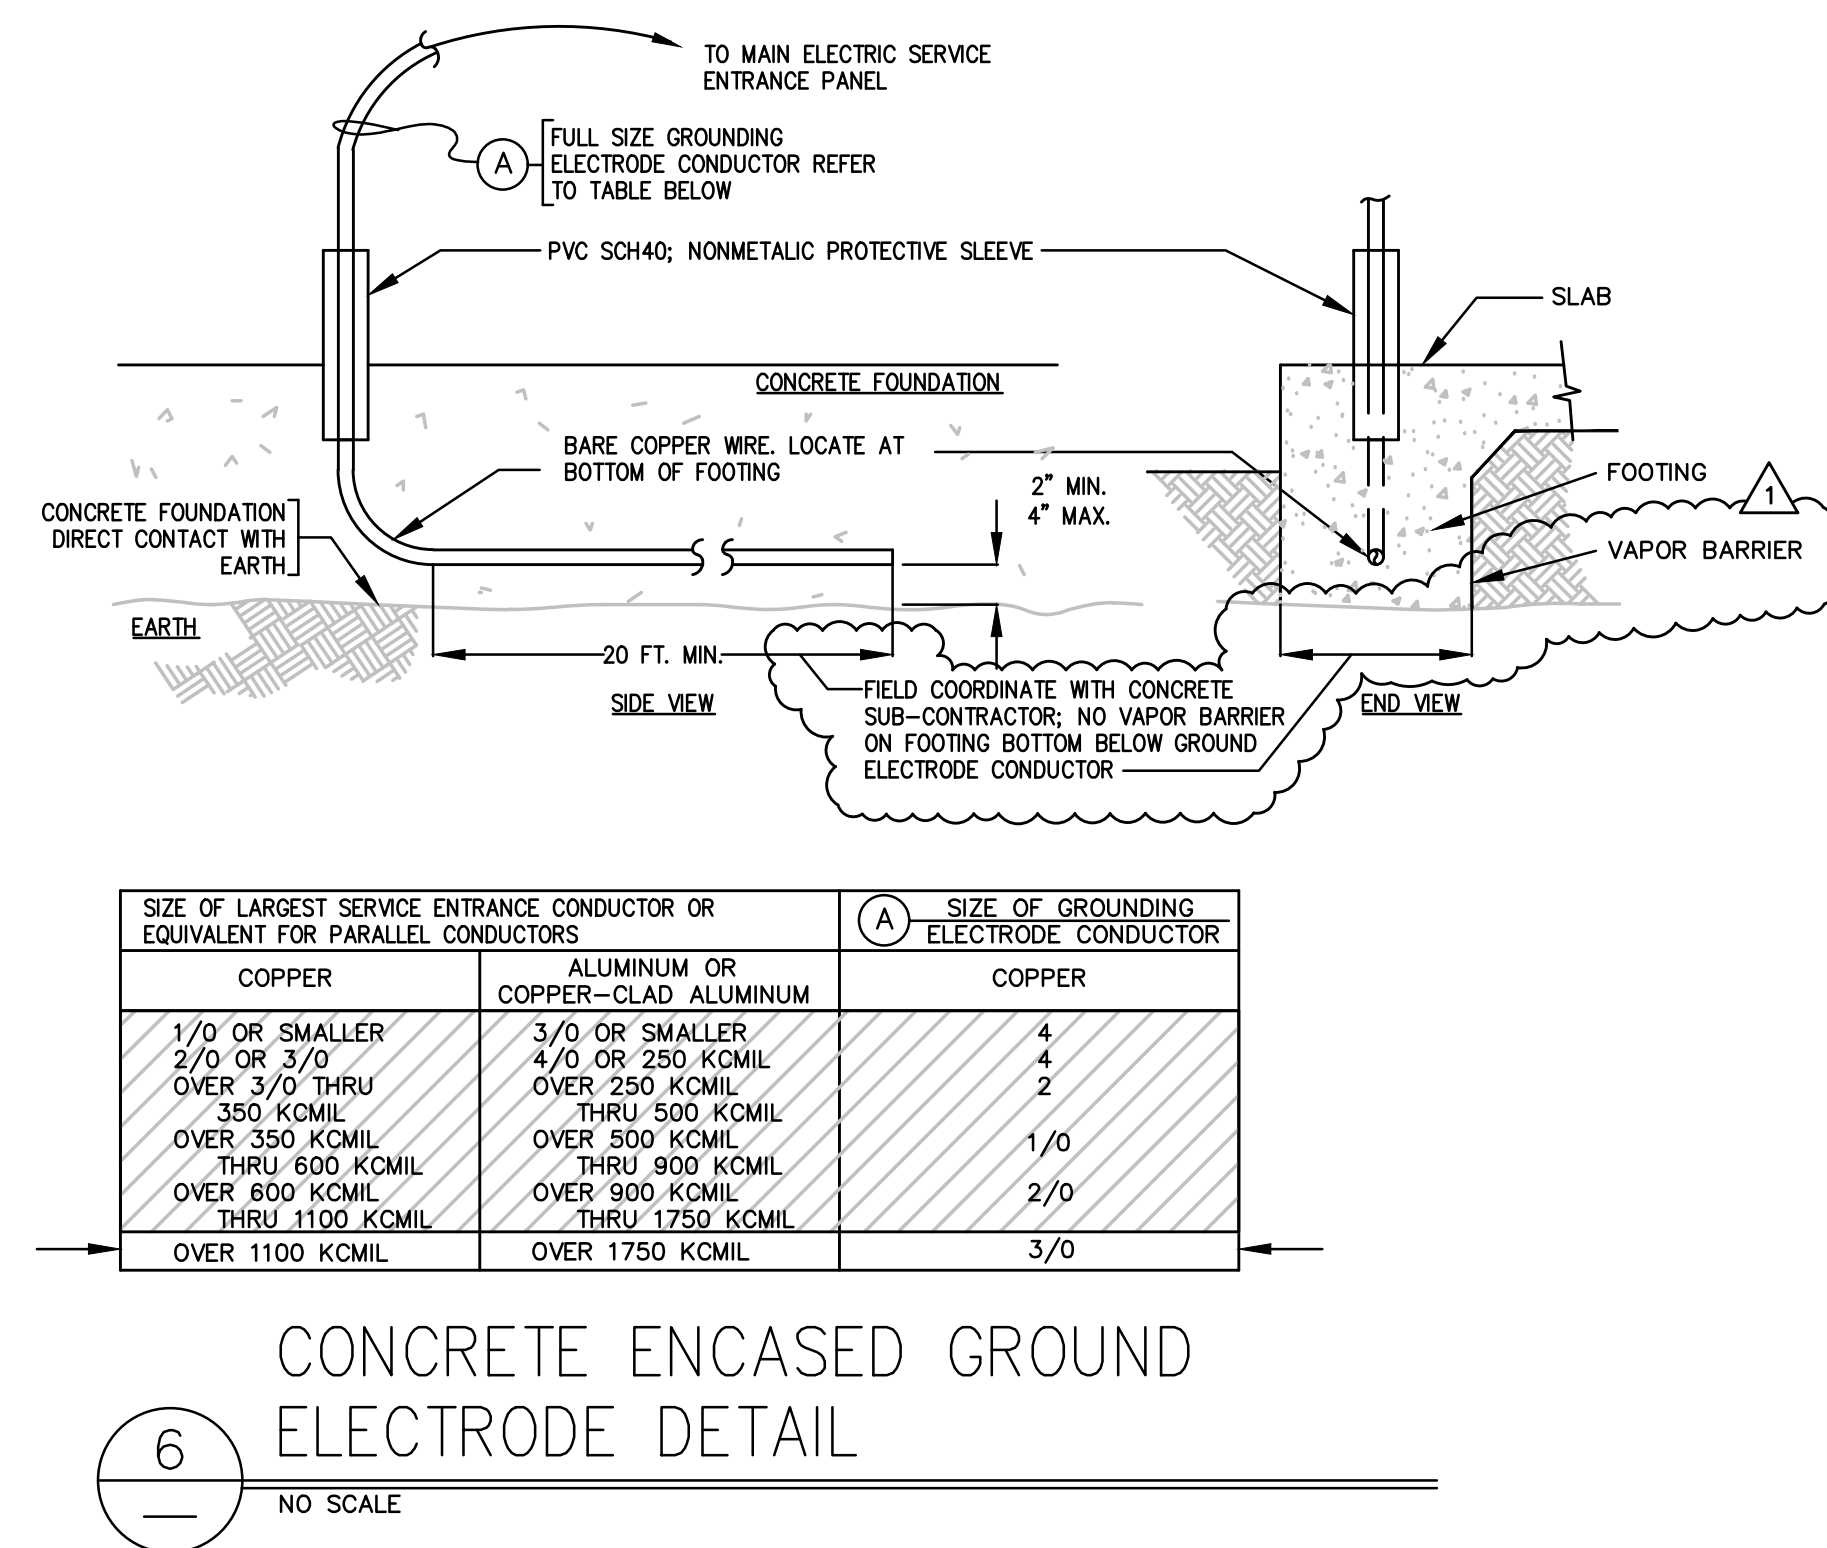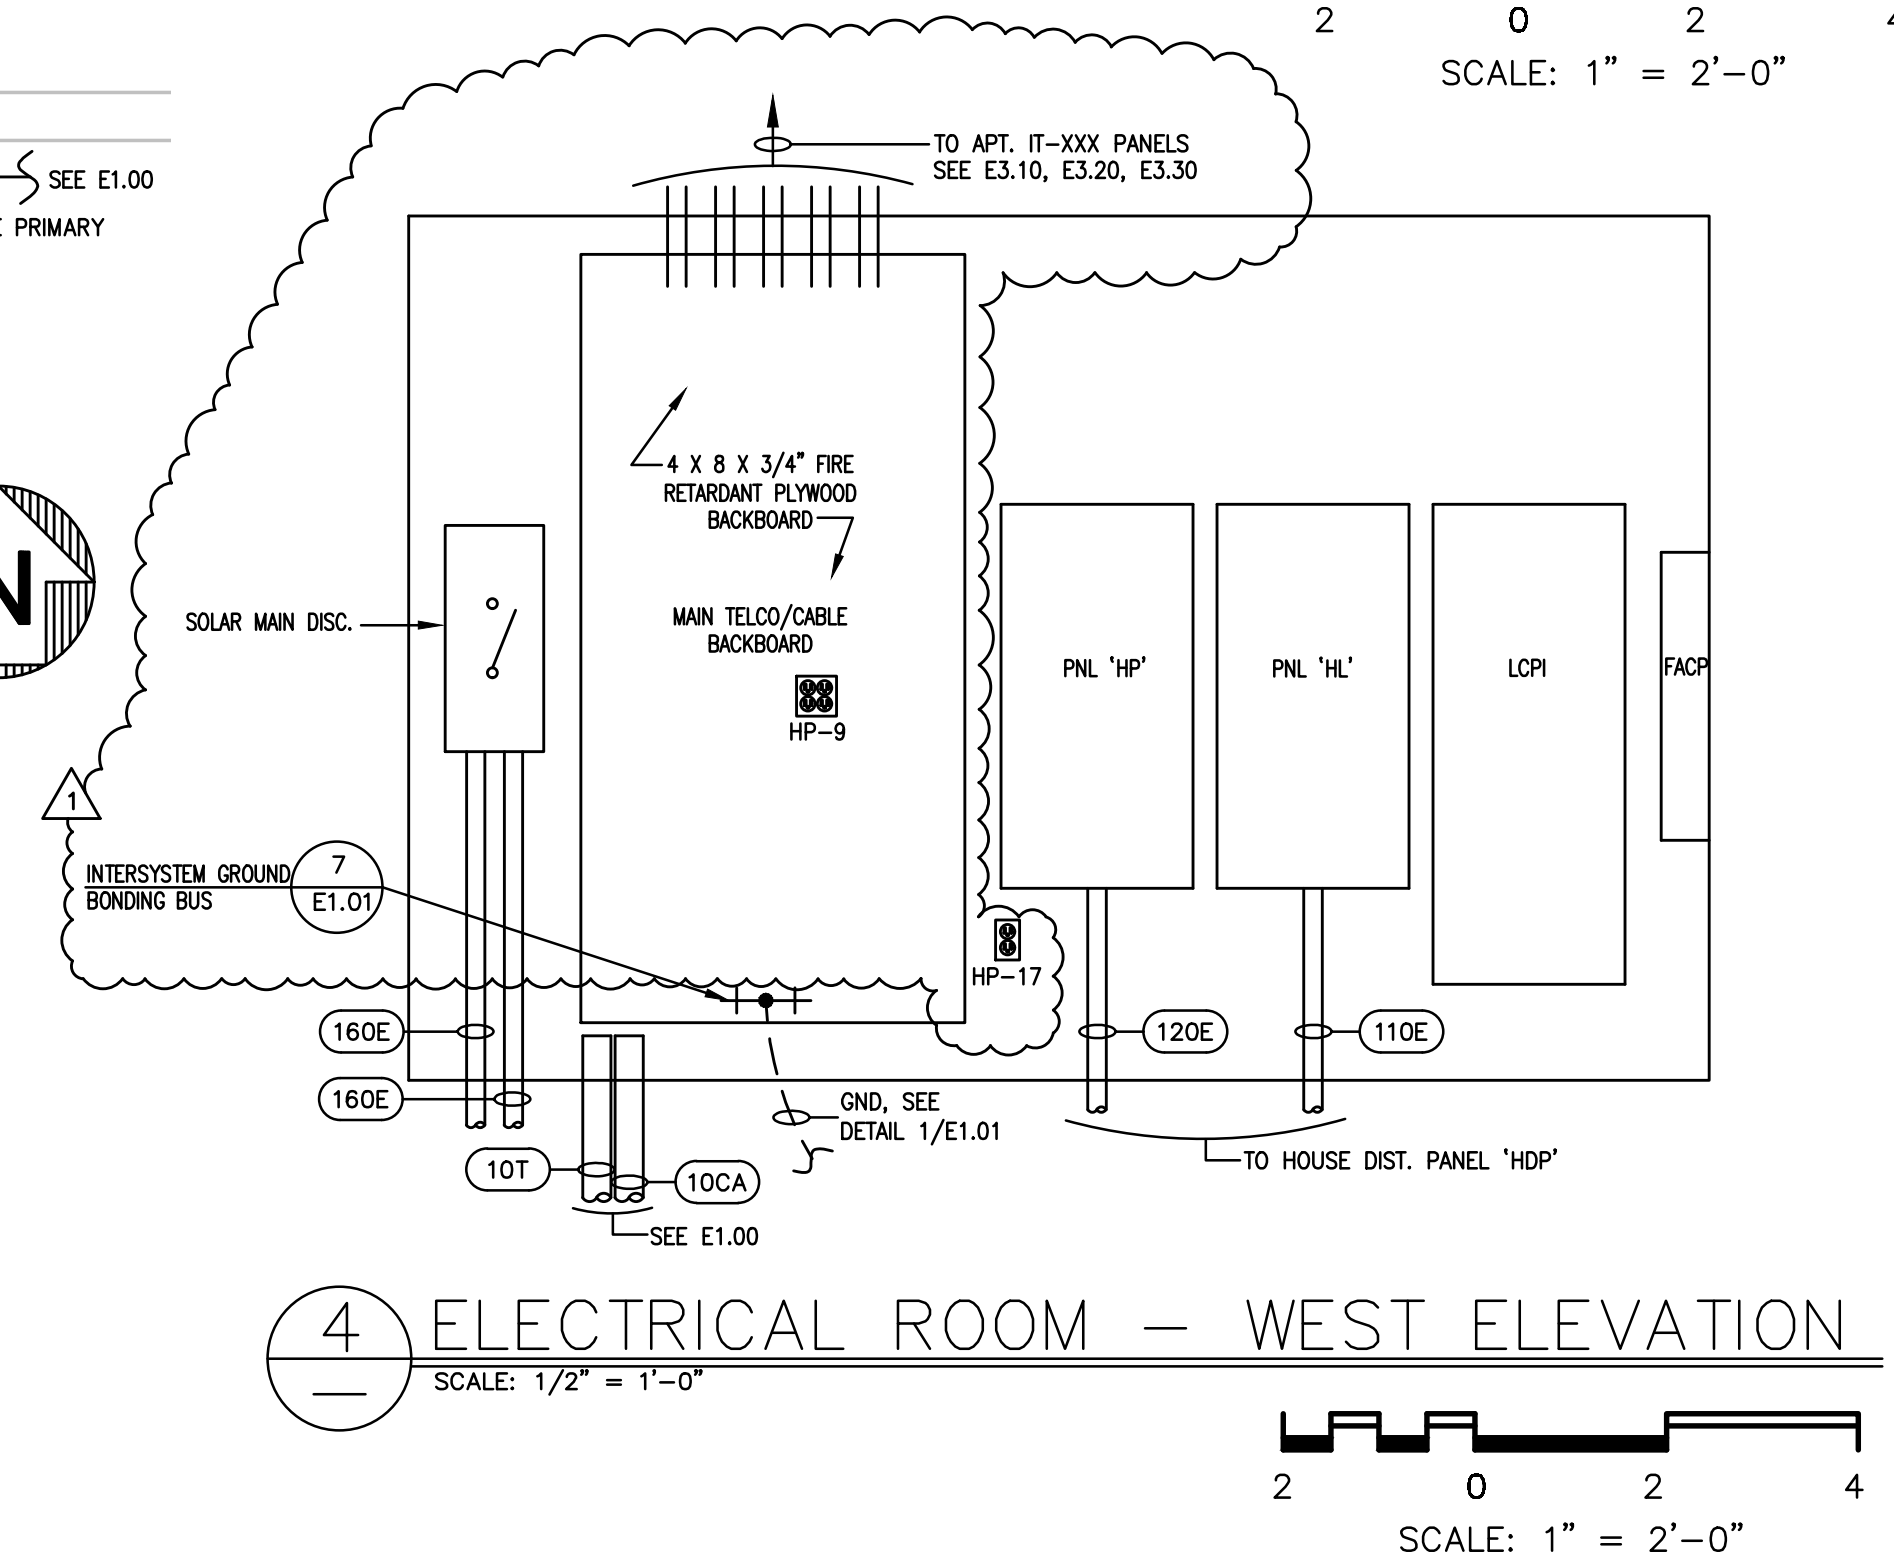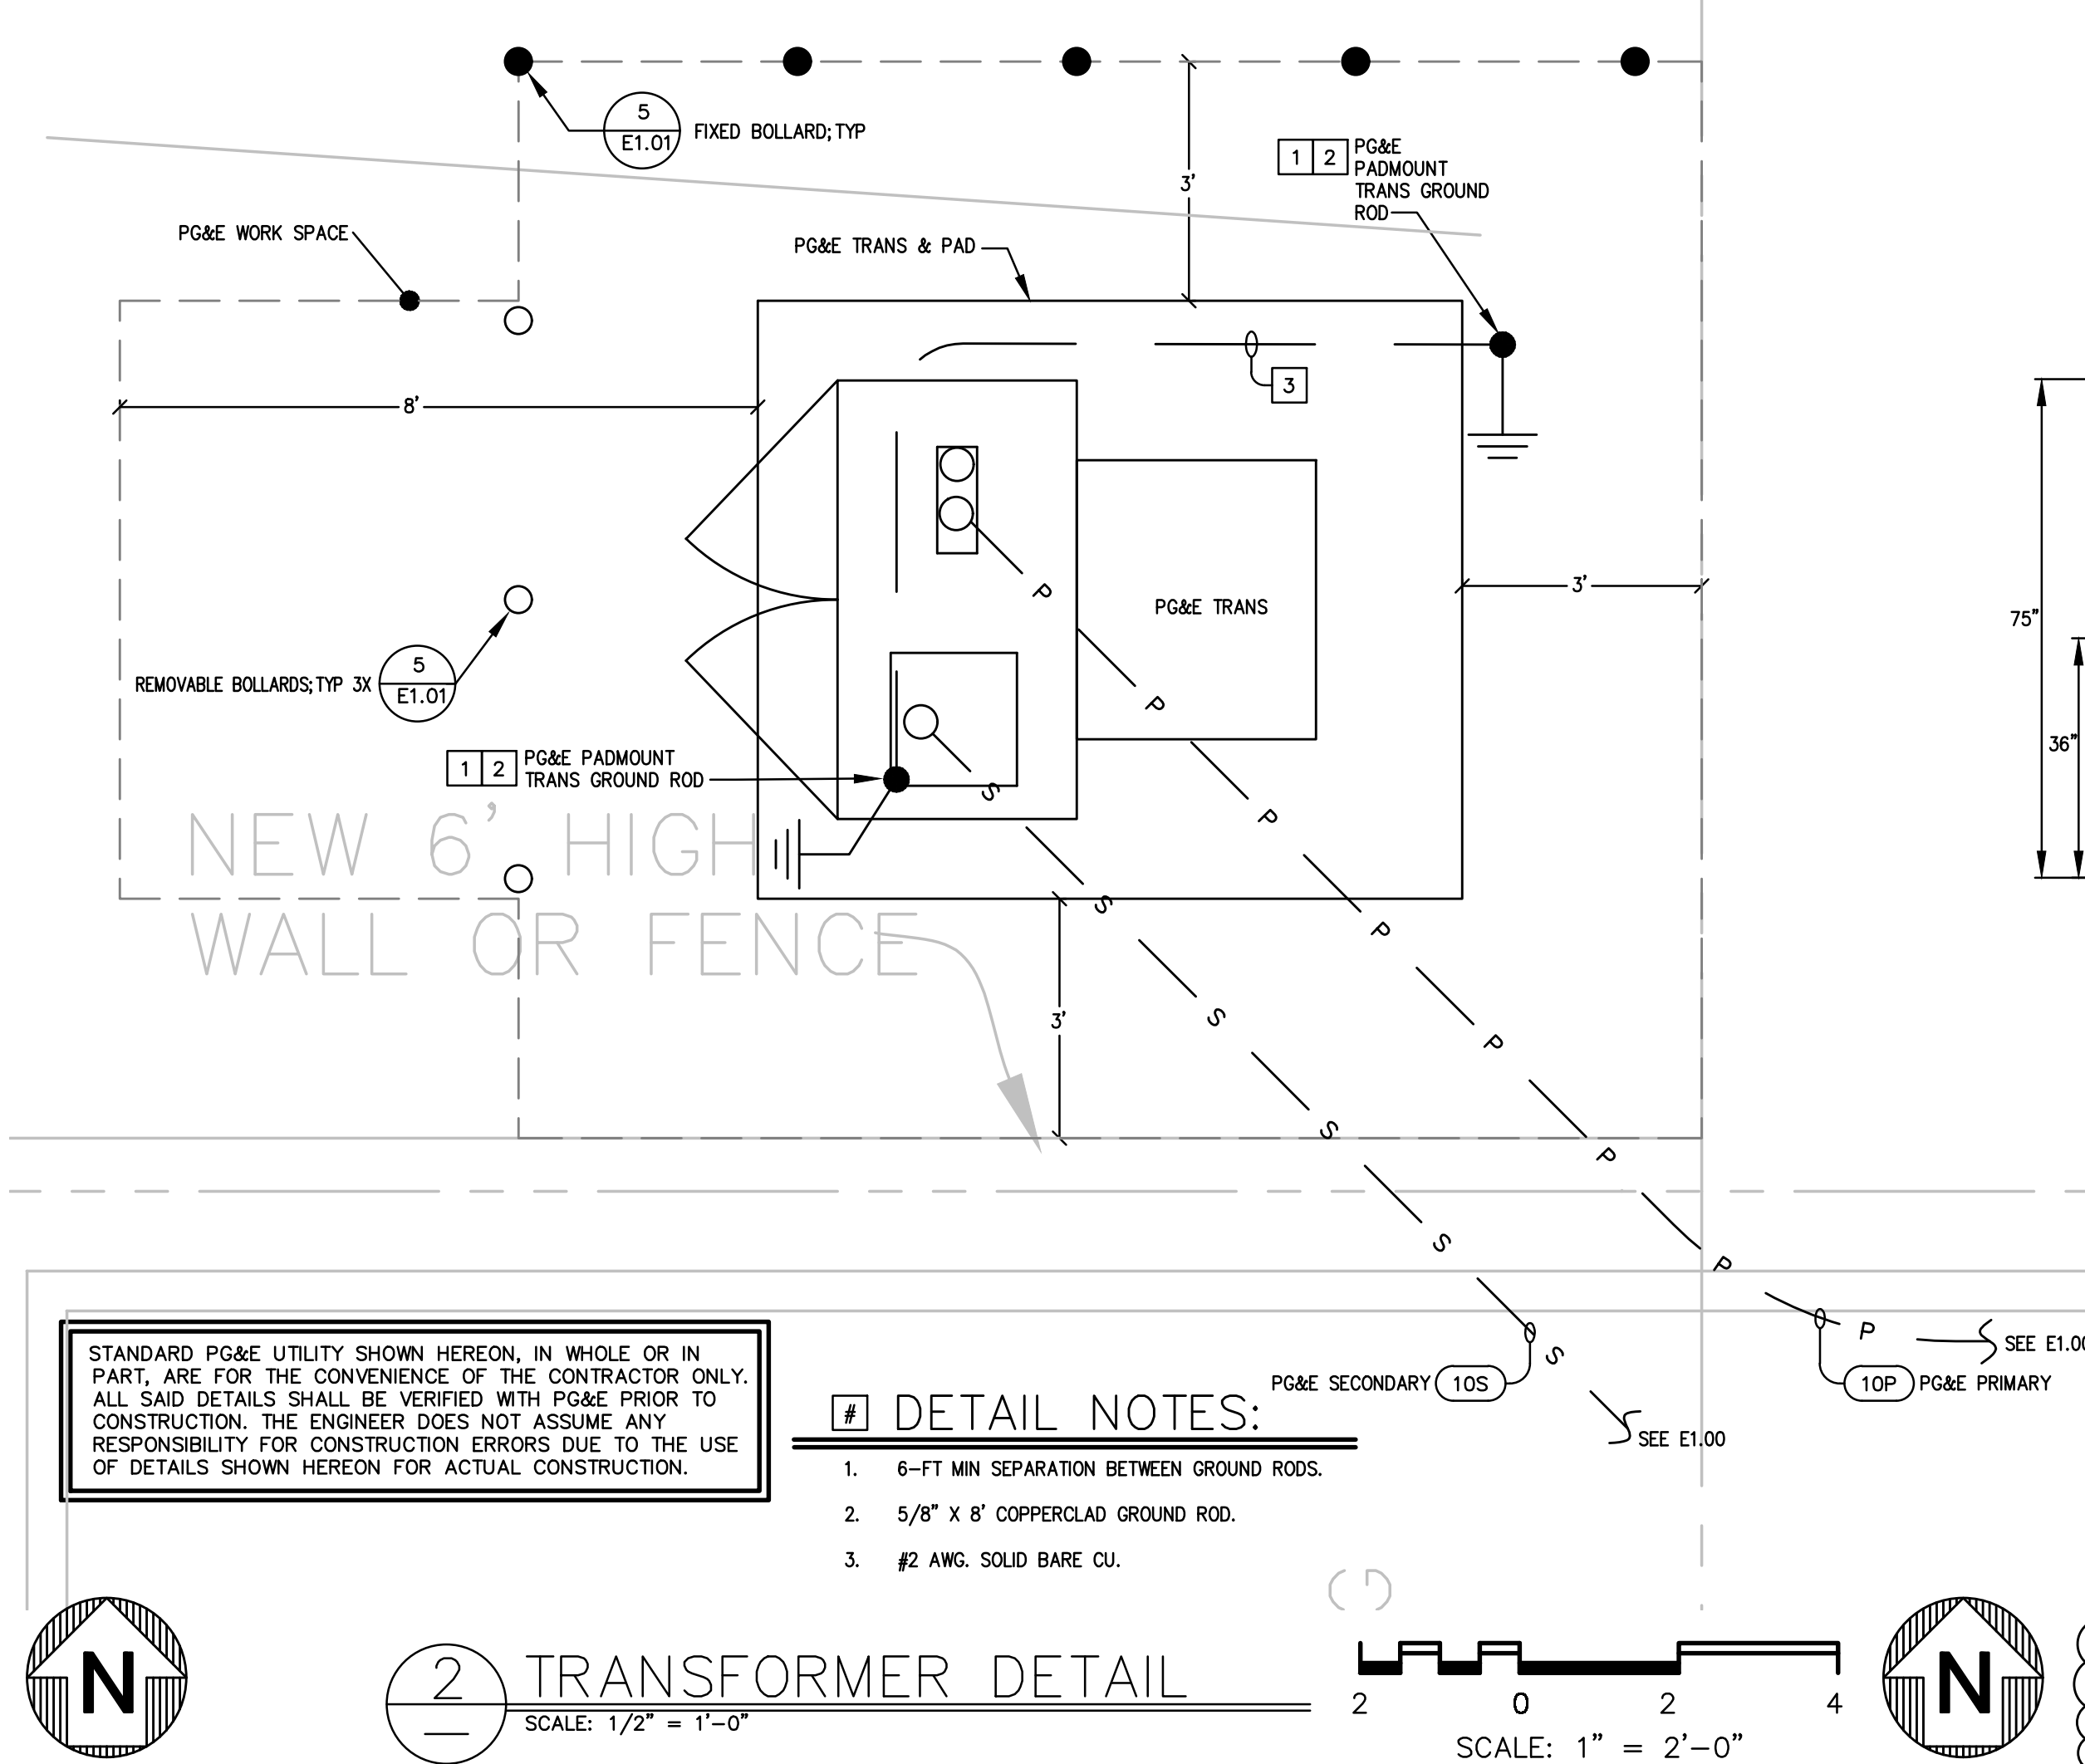

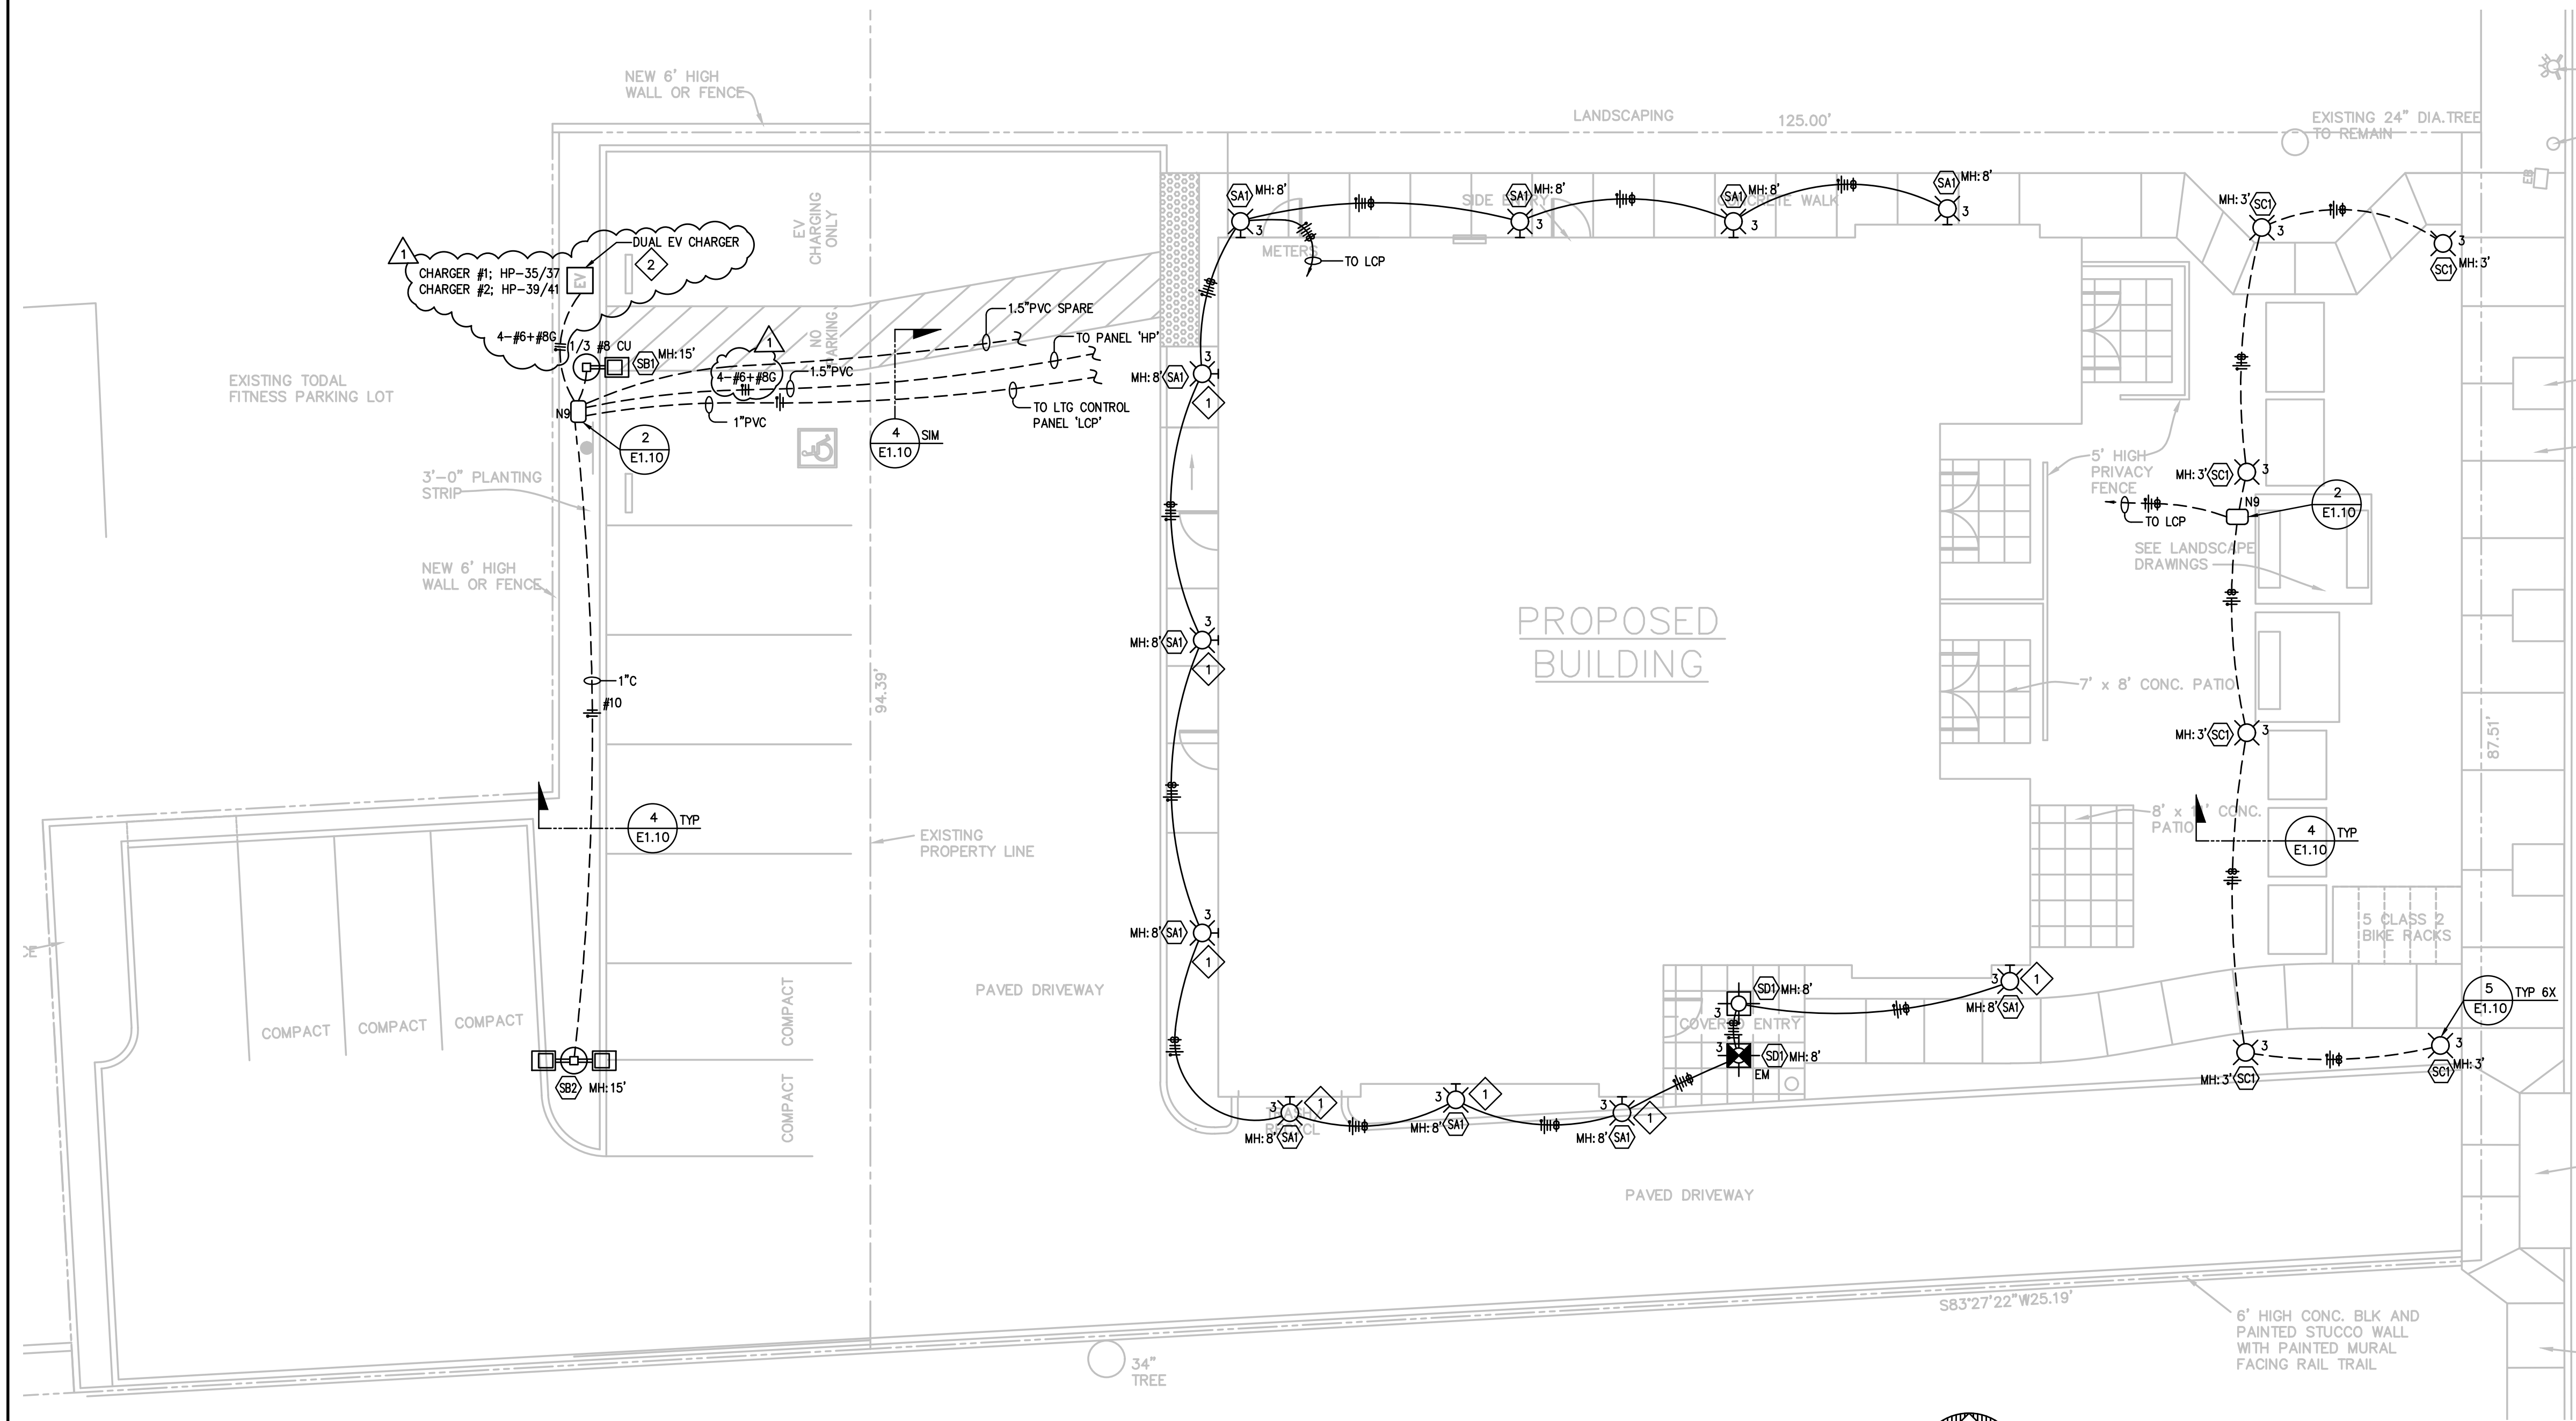


1 SITE LIGHTING PLAN
SCALE: 1/8" = 1'-0"

8 0 8 16
SCALE: 1" = 8'-0"

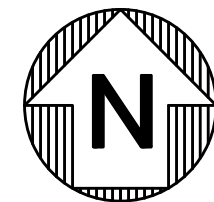


SHEET NOTES:
1. ADJUST FIXTURE WITH 15 DEGREE TILT.
2. DUAL EV CHARGER; MFG: EVBOX; MODEL: IQGN

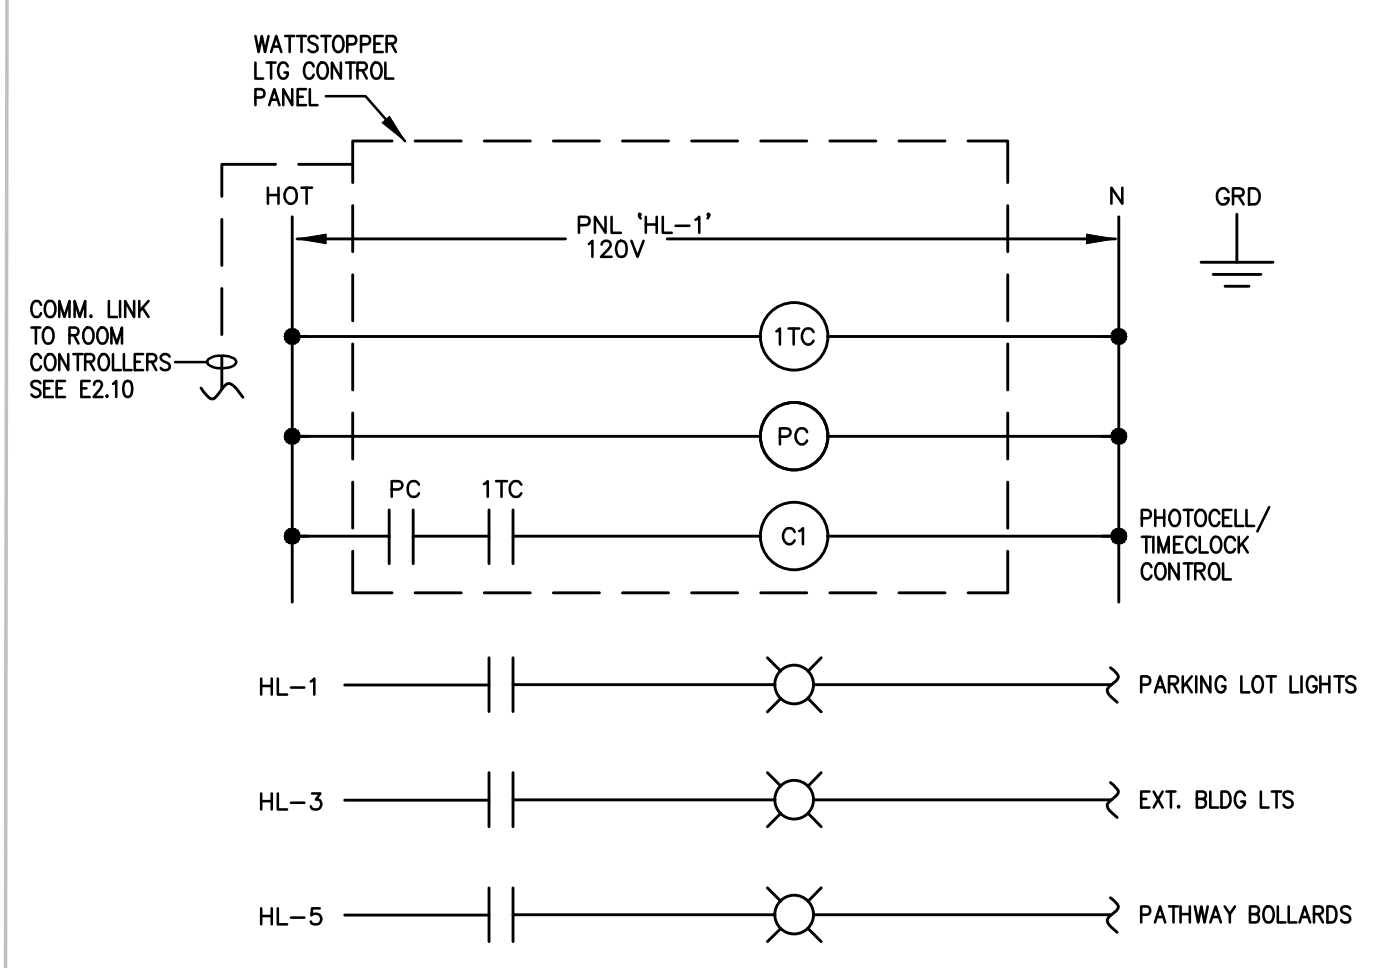


6 EXTERIOR LTG TIMER/ PHOTOCELL LIGHTING CONTROL - 'LCP1
NO SCALE

DETAIL NOTES:


- USE STEEL COVER AND SPECIAL CONCRETE FOOTING AS SHOWN, WHEN BOX IS TO BE INSTALLED WHERE SUBJECT TO VEHICULAR TRAFFIC LOADS. STEEL COVER SHALL HAVE EMBOSSED NON-SKID PATTERN.
- STEEL REINFORCING SHALL BE AS REGULARLY USED IN THE STANDARD PRODUCTS OF THE RESPECTIVE MANUFACTURER.
- TOP OF PULL BOXES SHALL BE FLUSH WITH SURROUNDING GRADE OR TOP OF ADJACENT CURB, EXCEPT THAT IN UNPAVED AREAS WHERE PULL BOX IS NOT IMMEDIATELY ADJACENT TO AND PROTECTED BY A CONCRETE FOUNDATION, POLE OR OTHER PROTECTIVE CONSTRUCTION. THE BOX SHALL BE PLACED WITH ITS TOP 0.10 FOOT ABOVE SURROUNDING GRADE. WHERE PRACTICAL, PULL BOXES SHOWN IN THE VICINITY OF CURBS SHALL BE PLACED ADJACENT TO THE BACK OF NEAREST CURB, AND PULL BOXES SHOWN ADJACENT TO STANDARDS SHALL BE PLACED ON SIDE OF FOUNDATION FACING SERVICE POINT U.O.N.
- PULL BOXES COVERS SHALL BE MARKED AS "SITE LIGHTING"
- THE NOMINAL DIMENSIONS OF THE OPENING IN WHICH THE COVER SETS SHALL BE THE SAME AS THE COVER DIMENSIONS EXCEPT THE LENGTH AND WIDTH DIMENSIONS SHALL BE 1/8" GREATER.
- ALL COVERS AND BOXES SHALL BE INTERCHANGABLE WITH CALIFORNIA STD. MALE OR FEMALE GAUGE. THE TOP SURFACES SHALL BE FLUSH WITHIN 1/8". TOP OUTSIDE EDGE OF ALL CONCRETE COVERS AND PULL BOXES SHALL HAVE A 1/4" MIN. RADIUS.
- WHEN PULL BOX IS INSTALLED IN SIDEWALK AREA ON A STRUCTURE, THE DEPTH OF THE PULL BOX SHALL BE ADJUSTED SO THE TOP OF THE BOX IS FLUSH WITH THE TOP OF SIDEWALK.

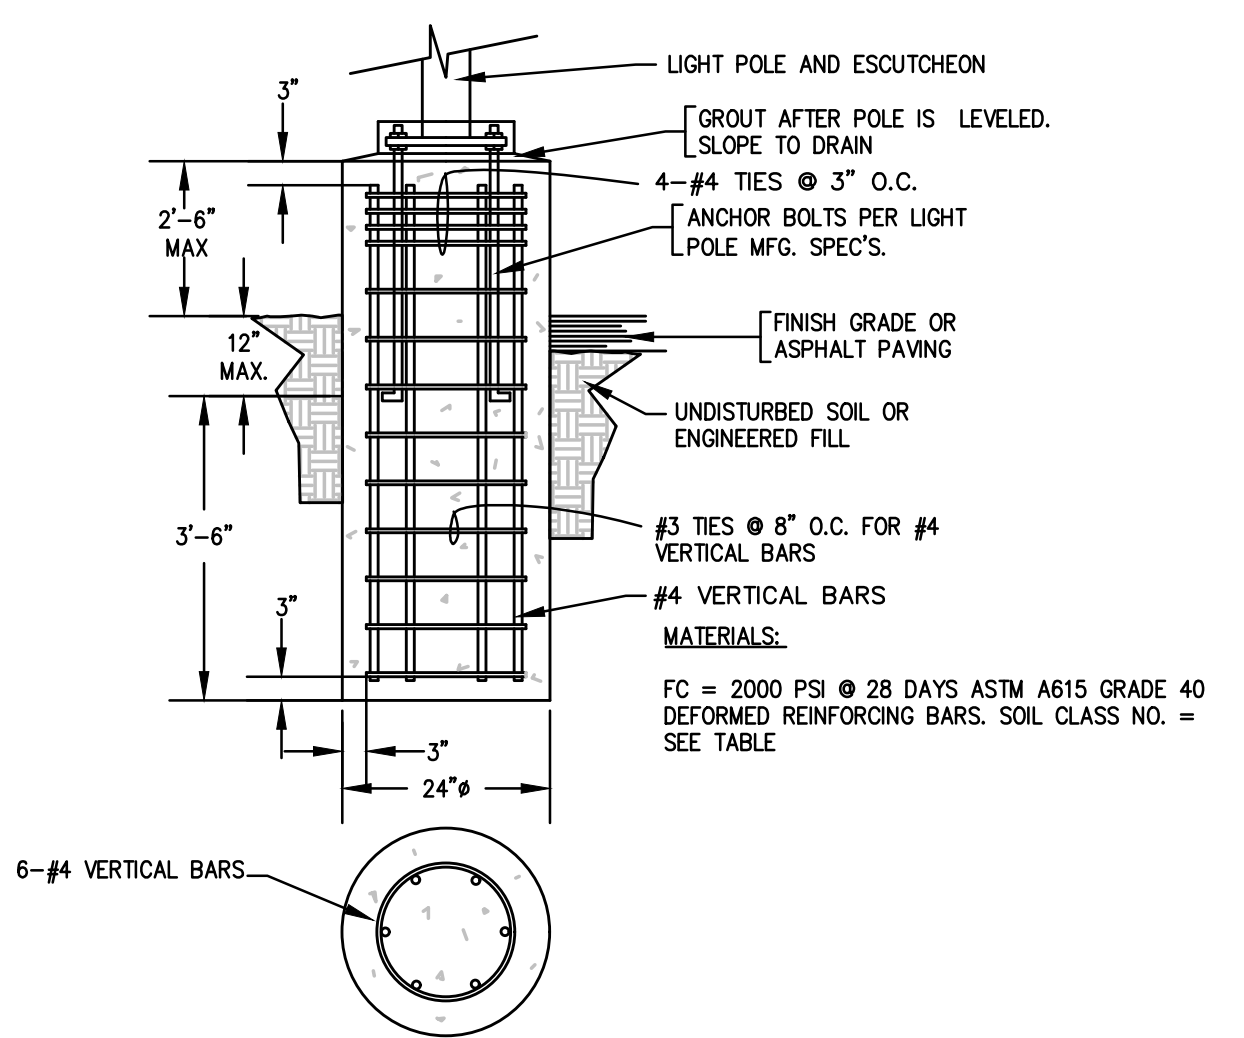


3 LIGHT POLE PEDESTAL
NO SCALE

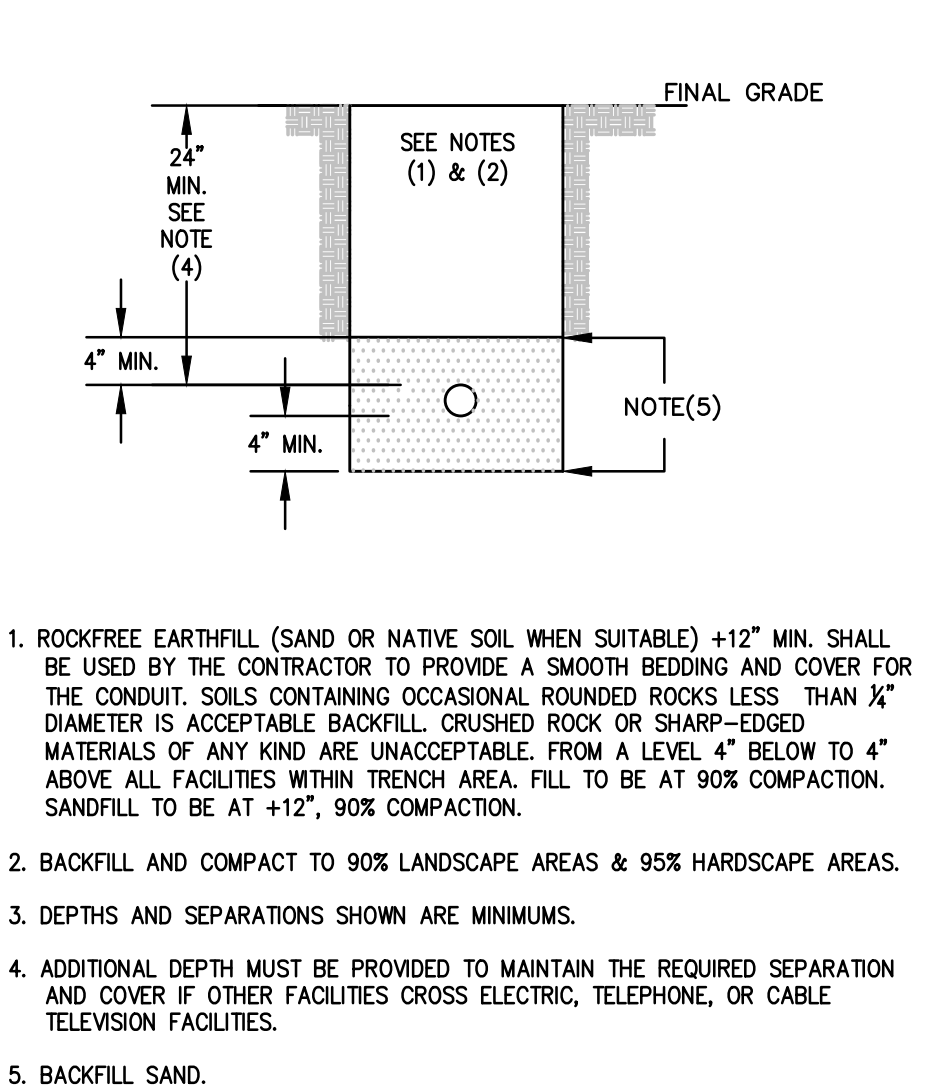

4 TRENCH DETAIL
NO SCALE

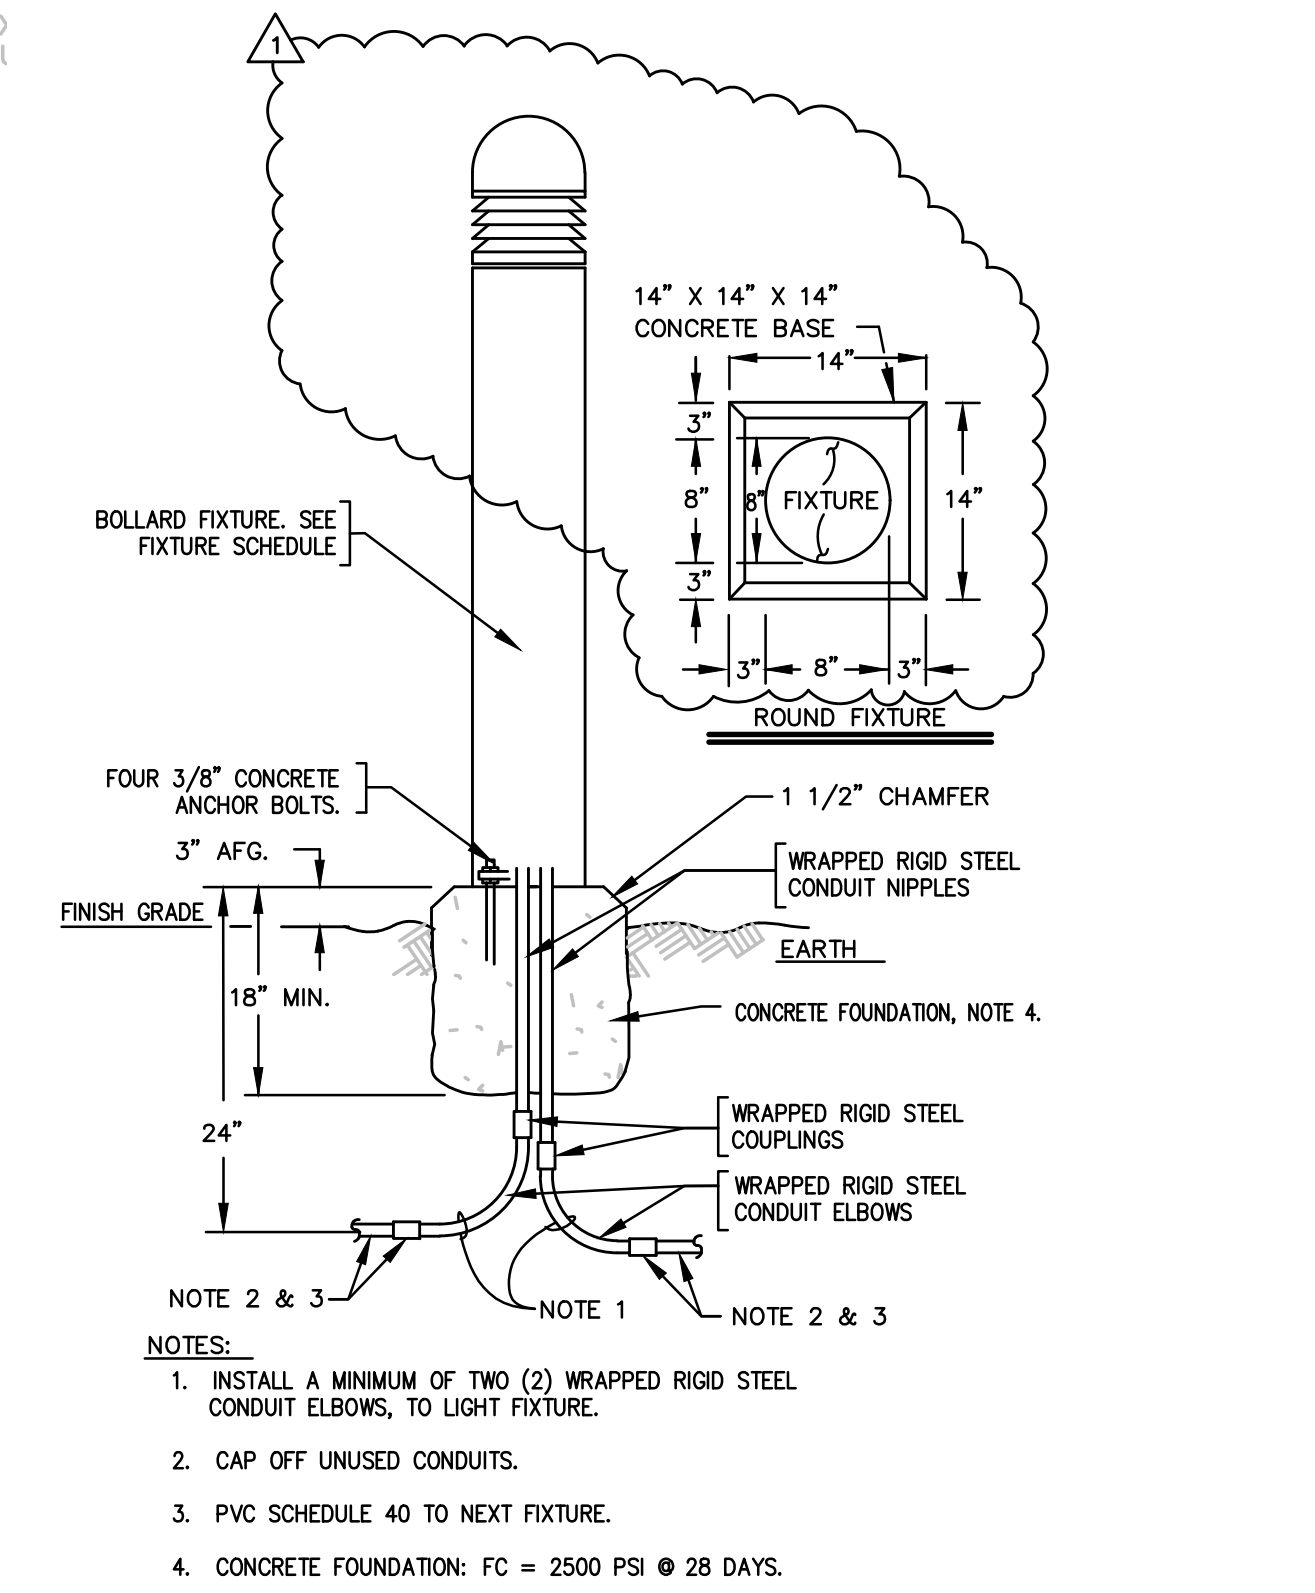

5 BOLLARD MOUNTING DETAIL
NO SCALE

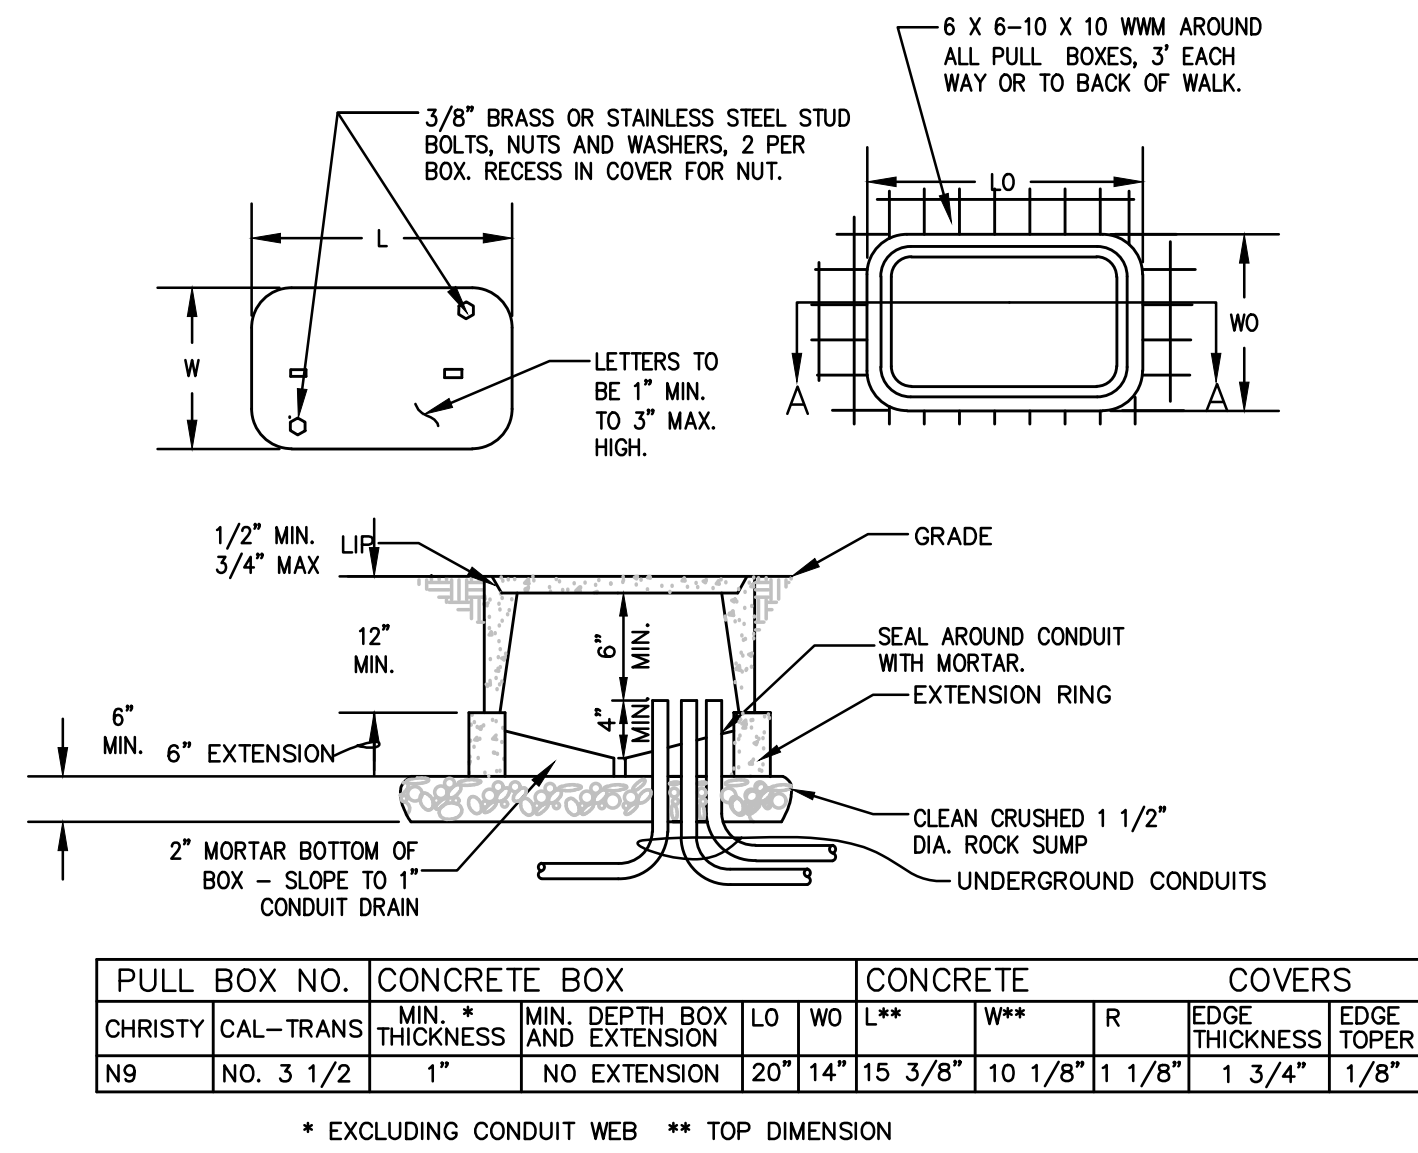

2 PULL BOX DETAIL
NO SCALE

SITE LIGHTING PLAN

PROPRIETARY DATA
THE USE OF THE PLANS AND SPECIFICATIONS IS LIMITED TO THE PROJECT FOR WHICH THEY WERE PREPARED, AND NO PART OF THEM SHALL BE REPRODUCED OR TRANSMITTED IN ANY FORM OR BY ANY MEANS, WITHOUT THE WRITTEN PERMISSION OF THE ENGINEER. THE ENGINEER'S LIABILITY IS LIMITED TO THE PROJECT FOR WHICH THEY WERE PREPARED, AND NO PART OF THEM SHALL BE REPRODUCED OR TRANSMITTED IN ANY FORM OR BY ANY MEANS, WITHOUT THE WRITTEN PERMISSION OF THE ENGINEER. THE ENGINEER'S LIABILITY IS LIMITED TO THE PROJECT FOR WHICH THEY WERE PREPARED, AND NO PART OF THEM SHALL BE REPRODUCED OR TRANSMITTED IN ANY FORM OR BY ANY MEANS, WITHOUT THE WRITTEN PERMISSION OF THE ENGINEER.

REGISTERED PROFESSIONAL ENGINEER
DATE: 11/15/22
EXPIRATION DATE: 08-30-24
ELECTRICAL
STATE OF CALIFORNIA

Central Pacific Engineering, Inc.
Professional Engineers
9035 Soquel Avenue, Suite 205
Santa Cruz, CA 95062
831-478-1525
831-478-1525
CPE JOB 21-044-0

REV.	DESCRIPTION	DATE
1	ISSUED FOR PLAN CHECK	08/27/22
2	PLAN CHECK & OWNER COMMENTS	10/14/22
3		
4		
5		

TITLE: AFFORDABLE HOUSING PROJECT
JOB NO. 21-044-0
DWG. NO. E110
SH 7 OF 32
REV. 1


LOCATION: 415 NATURAL BRIDGES DRIVE
SANTA CRUZ, CALIFORNIA
OWNER: THE HOUSING AUTHORITY OF THE COUNTY OF SANTA CRUZ
DR. SAK
CHK. DGS
APPD. DGS
SCALE AS NOTED
DATE 04/20/22

DETAIL NOTES:

SYSTEM NO. W-L-1222
F RATINGS - 1 AND 2 HR (SEE ITEM 1)
T RATINGS - 1/4 AND 1 HR (SEE ITEM 2)

1. WALL ASSEMBLY - THE 1 OR 2 HR FIRE-RATED GYPSUM BOARD/STUD WALL ASSEMBLY SHALL BE CONSTRUCTED OF THE MATERIALS AND IN THE MANNER SPECIFIED IN THE INDIVIDUAL U300 OR U400 SERIES WALL AND PARTITION DESIGN IN THE UL FIRE RESISTANCE DIRECTORY AND SHALL BE CONSIDERED A NON-FLAME PROPAGATING PRODUCT.
- A. STUDS - WALL FRAMING MAY CONSIST OF EITHER WOOD STUDS OR STEEL CHANNEL STUDS. WOOD STUDS TO CONSIST OF NOM 2 BY 4 IN. LUMBER SPACED 16 IN. OC. STEEL STUDS TO BE MIN 3-5/8 IN. WIDE AND SPACED MAX 24 IN. OC.
- B. GYPSUM BOARD - THICKNESS AND TYPE, NUMBER OF LAYERS AND FASTENERS AS SPECIFIED IN THE INDIVIDUAL WALL AND PARTITION DESIGN. MAX DIM OF OPENING IS 6 IN.
2. THROUGH PENETRANT - THE FIRE ROSTOP SYSTEM IS EQUAL TO THE HOURLY FIRE RATING OF THE WALL ASSEMBLY IN WHICH IT IS INSTALLED.
3. THROUGH PENETRANT - ONE OR MORE METALLIC PIPES, CONDUITS OR TUBING TO BE INSTALLED ECCENTRICALLY OR CONCENTRICALLY WITHIN THE FIRESTOP SYSTEM. THE SPACE BETWEEN THE PIPES CONDUITS OR TUBING SHALL BE A MIN 1/4 IN. TO MAX 2 IN. THE ANNULAR SPACE BETWEEN THE PIPES, CONDUITS OR TUBING SHALL BE RIGIDLY SUPPORTED ON BOTH SIDES OF THE WALL ASSEMBLY. THE FOLLOWING TYPES AND SIZES OF METAL PIPES, CONDUITS OR TUBES MAY BE USED:
- A. STEEL PIPE - NOM 8 IN. DIA (OR SMALLER) SCHEDULE 5 (OR HEAVIER) STEEL PIPE.
- B. IRON PIPE - NOM 8 IN. DIA (OR SMALLER) CAST OR DUCTILE IRON PIPE.
-
- D. COPPER PIPE - NOM 4 IN. DIA (OR SMALLER) REGULAR (OR HEAVIER) COPPER PIPE.
- E. COPPER TUBE - NOM 4 IN. DIA (OR SMALLER) TYPE L (OR HEAVIER) COPPER TUBE.
4. WHEN ITEM 2A, 2B OR 2C IS USED, T RATING IS 1 HR. WHEN ITEM 2D OR 2E IS USED, T RATING IS 1/4 HR.
5. THROUGH PENETRANT - THE FIRE ROSTOP SYSTEM IS EQUAL TO THE HOURLY FIRE RATING OF THE WALL ASSEMBLY IN WHICH IT IS INSTALLED. STEEL FLEXIBLE METAL PIPES TO BE INSTALLED EITHER CONCENTRICALLY OR ECCENTRICALLY WITHIN THE FIRESTOP SYSTEM. THE ANNULAR SPACE BETWEEN THE PIPES AND THE PERIPHERY OF THE OPENING SHALL BE 0 IN. (POINT CONTACT) TO MAX 2 IN. PIPES TO BE RIGIDLY SUPPORTED ON BOTH SIDES OF THE WALL ASSEMBLY.
6. OMEGA FLEX INC
ITEM 2X OR 2Y
A BUNDY CO
WARD MOFG INC
3. FILL, VOID, CAVITY MATERIAL - SEALANT - MIN 5/8 IN. THICKNESS OF FILL MATERIAL APPLIED WITHIN ANNULUS, FLUSH WITH BOTH SURFACES OF WALL ASSEMBLY AT POINT CONTACT LOCATION, MIN 1/4 IN. DIAM BEAD OF FILL MATERIAL APPLIED AT METALLIC PIPE/GYPSUM BOARD INTERFACE ON BOTH SURFACES OF WALL.
4. SPECTACLED TECHNOLOGIES INC
SPECIAL LCI SEALANT
- *BEARING THE UL CLASSIFICATION MARKING


"THROUGH PENETRATOR FIRE STOP SYSTEM" DETAILS ARE FOR REFERENCE ONLY. PENETRATIONS THROUGH FIRE-RATED WALLS SHALL BE PROTECTED IN ACCORDANCE WITH APPROPRIATE CBC SECTIONS. SYSTEMS SHALL BE INSTALLED IN ACCORDANCE WITH MANUFACTURER'S INSTRUCTIONS AND APPROVED LISTING. MANUFACTURER'S INSTRUCTIONS AND APPROVED LISTING SHALL BE PROVIDED FOR REVIEW BY INSPECTION AUTHORITIES. SUBSTITUTIONS OF OR REVISIONS OR ADDITIONS TO APPROVED SYSTEMS SHALL BE SUBMITTED TO THE INSPECTOR OF RECORD AND OSHPD FIRE MARSHAL FOR FIELD REVIEW AND APPROVAL.

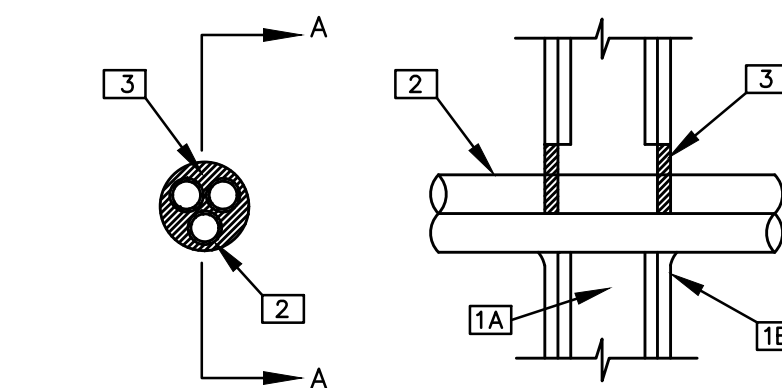

SECTION A-A

1 FIRE PENETRATION DETAIL

NO SCALE

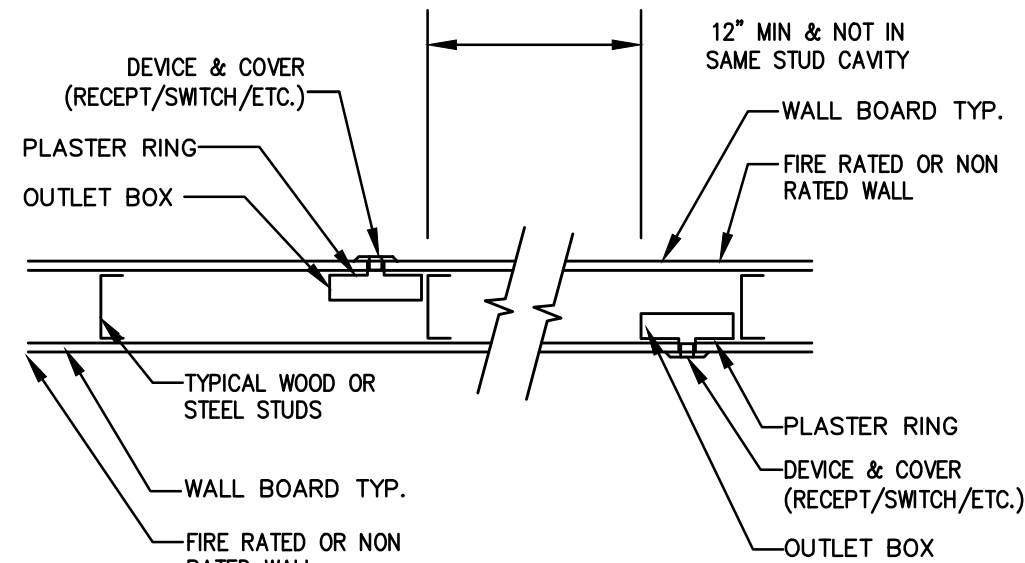

2 TYPICAL OUTLET BOX MOUNTING
NO SCALE

TITLE: AFF	LOCATI	OWNER	D	S
	JOB NO. 21-044-0			
	DWG. NO. E1.11			
	SH 8 OF 32	REV. 1		

TITLE: AFFORDABLE HOUSING PROJECT

LOCATION: 415 NATURAL BRIDGES DRIVE SANTA CRUZ, CALIFORNIA					
OWNER: THE HOUSING AUTHORITY OF THE COUNTY OF SANTA CRUZ					
DR.	DATE	CHK.	APPD.	SCA	
SAK	04/20//22	DGS	DGS	AS N	

REV.	DESCRIPTION	DATE
1/A	ISSUED FOR PLAIN CHECK	08/27/22
1/A	PLAN CHECK & OWNER COMMENTS	10/14/22
2/A		
3/A		
4/A		
5/A		

Central Pacific Engineering, Inc.
Professional Engineers
9035 Soquel Avenue, Suite 205
Santa Cruz, CA 95062
831-476-1525
CPE DBE 21-044-0




PROPRIETARY DATA


THE USE OF THE PLANS AND SPECIFICATIONS IS RESTRICTED TO THE ORIGINAL SITE FOR WHICH THEY WERE PREPARED, AND PUBLICATION THEREOF IS EXPRESSLY LIMITED TO SUCH USE. REUSE OF THESE PLANS AND SPECIFICATIONS FOR ANY OTHER PROJECT IS PROHIBITED. TITLE TO THE PLANS AND SPECIFICATIONS REMAINS WITH CENTRAL PACIFIC ENGINEERING. WHETHER THE PROJECT FOR WHICH THE PLANS AND SPECIFICATIONS IS EXECUTED OR NOT, AND WITHOUT CONTACT WITH THEM CONSTITUTES PRIMA FACIE EVIDENCE OF THE ACCEPTANCE OF THESE RESTRICTIONS.

CENTRAL PACIFIC ENGINEERING, INC.
COPY RIGHT 2006


DETAILS

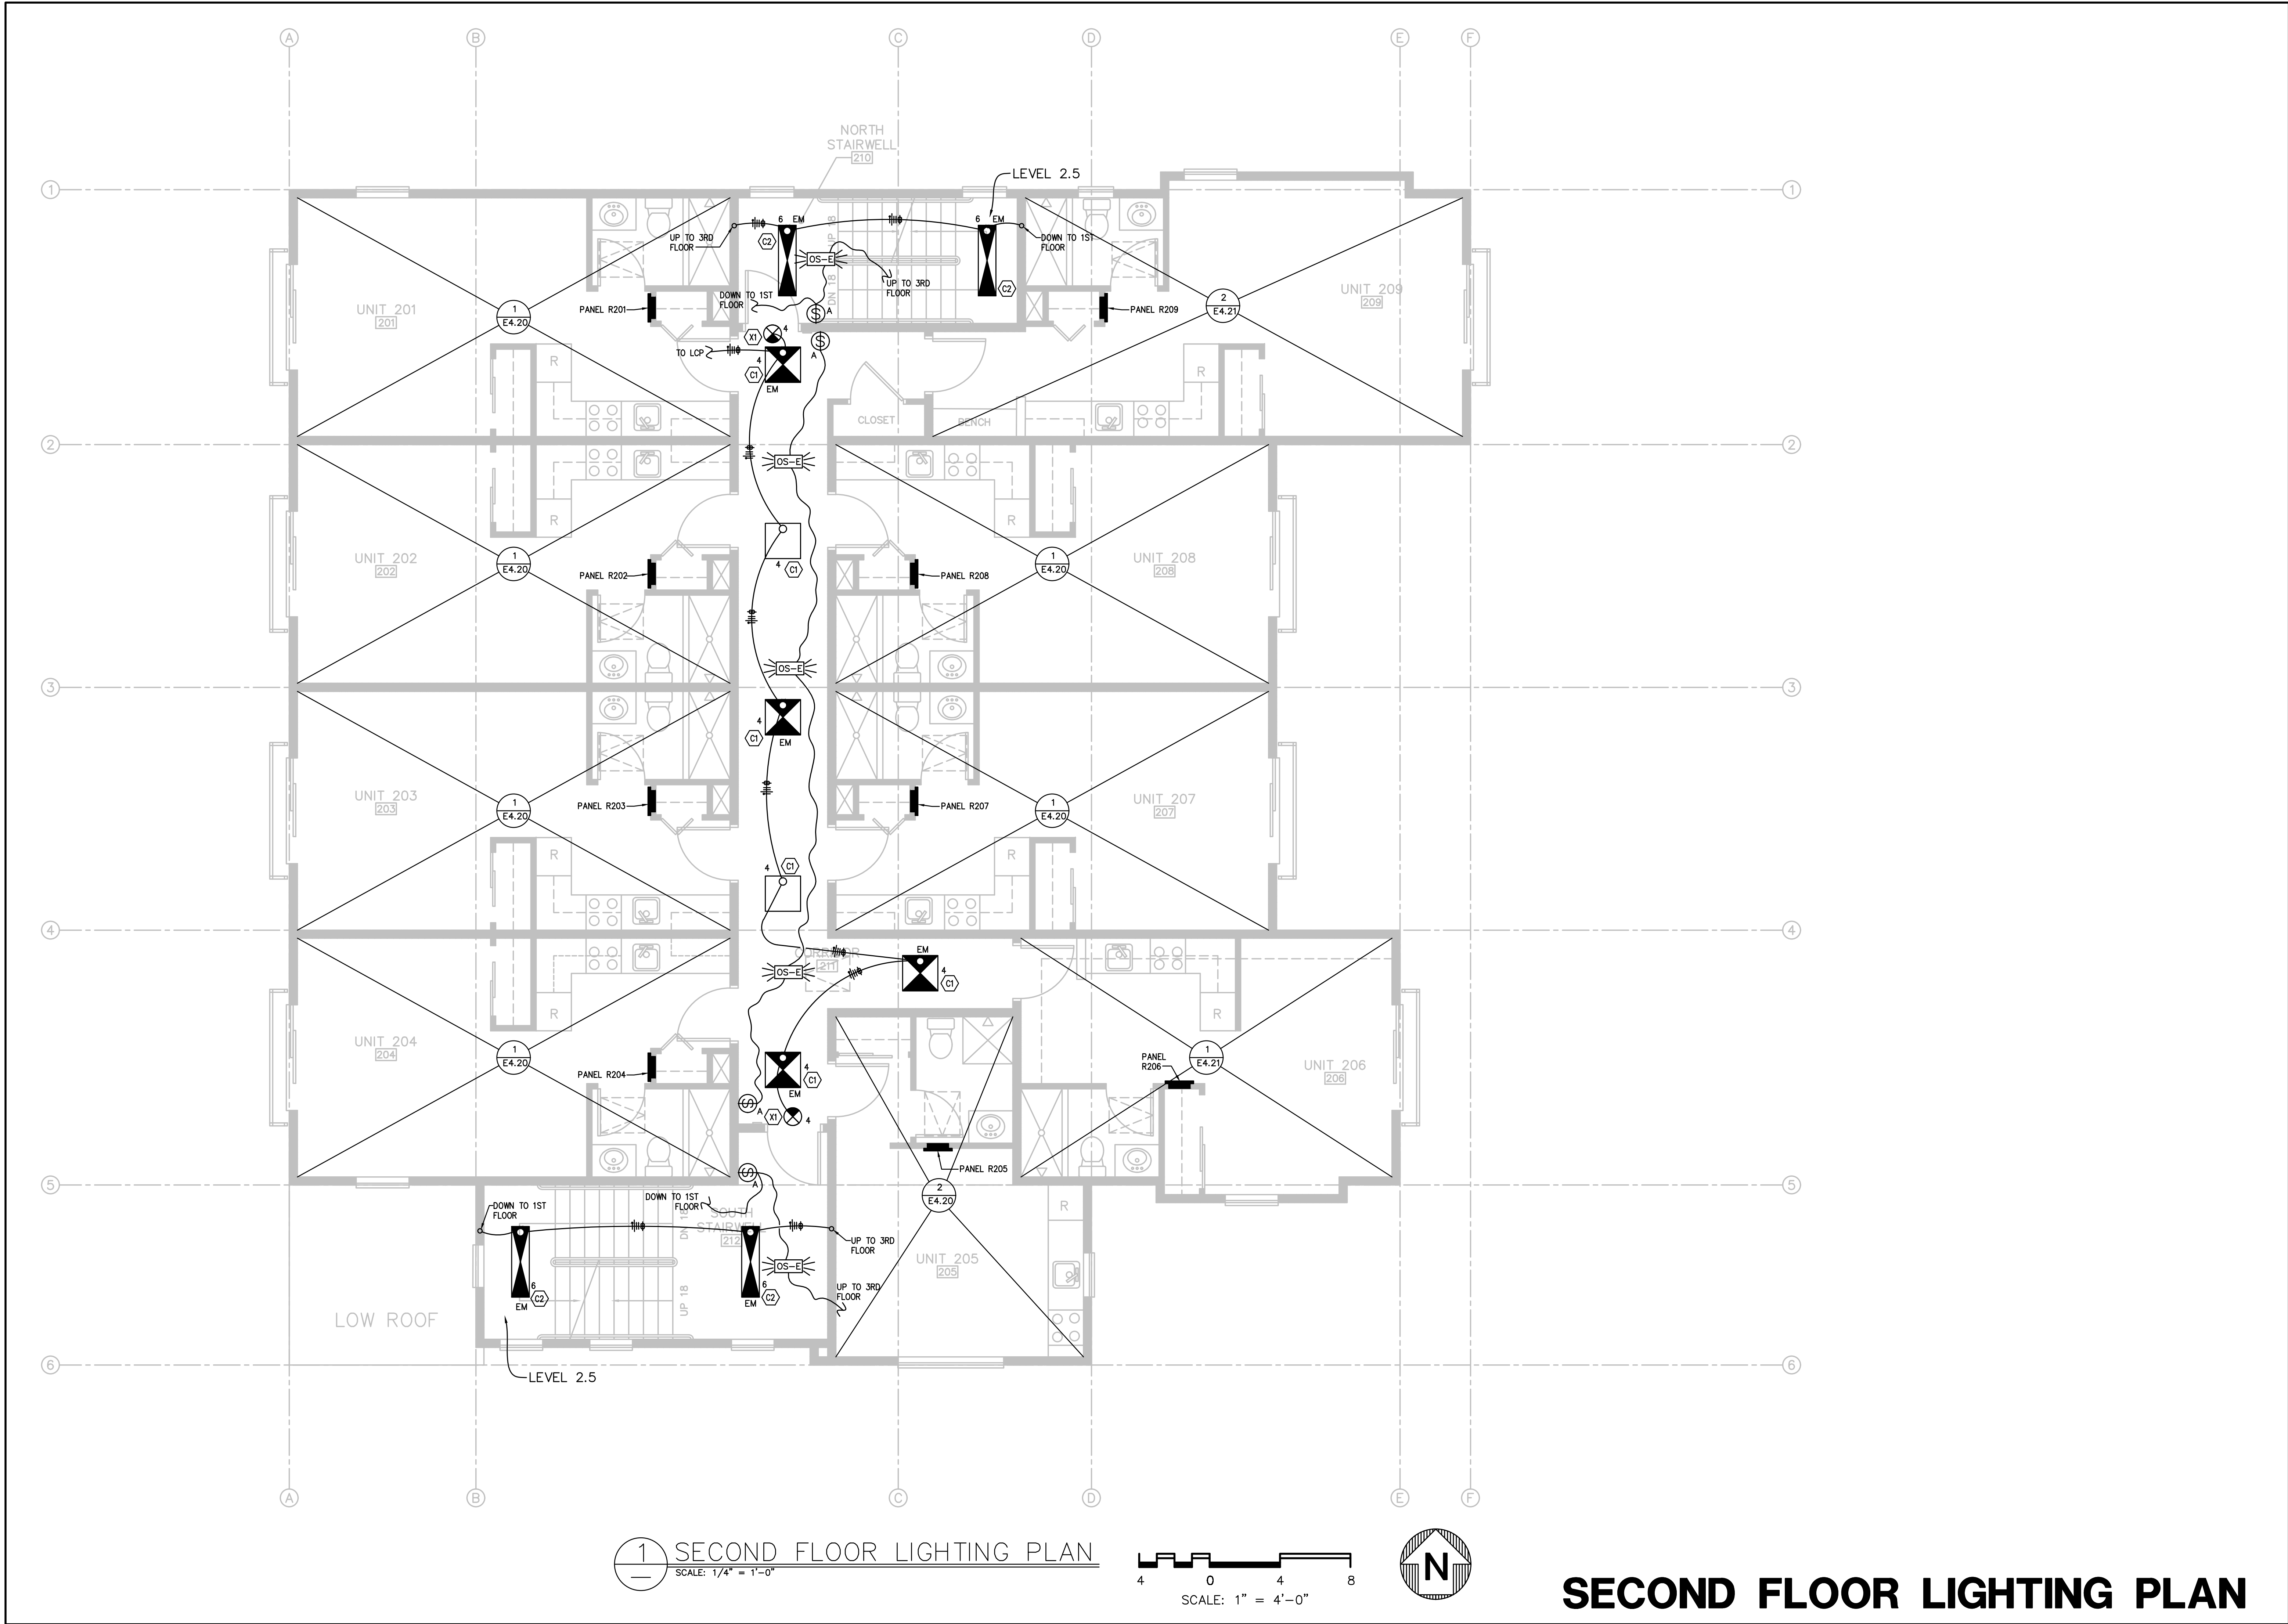

TITLE: AFFORDABLE HOUSING PROJECT		REV.	
JOB NO. 21-044-0		REV. 1	
DWG. NO. E220			
LOCATION: 415 NATURAL BRIDGES DRIVE SANTA CRUZ, CALIFORNIA			
OWNER: THE HOUSING AUTHORITY OF THE COUNTY OF SANTA CRUZ			
DR. SAK	DATE 04/20/22	CHK. DGS	SCALE AS NOTED
		APPD. DGS	

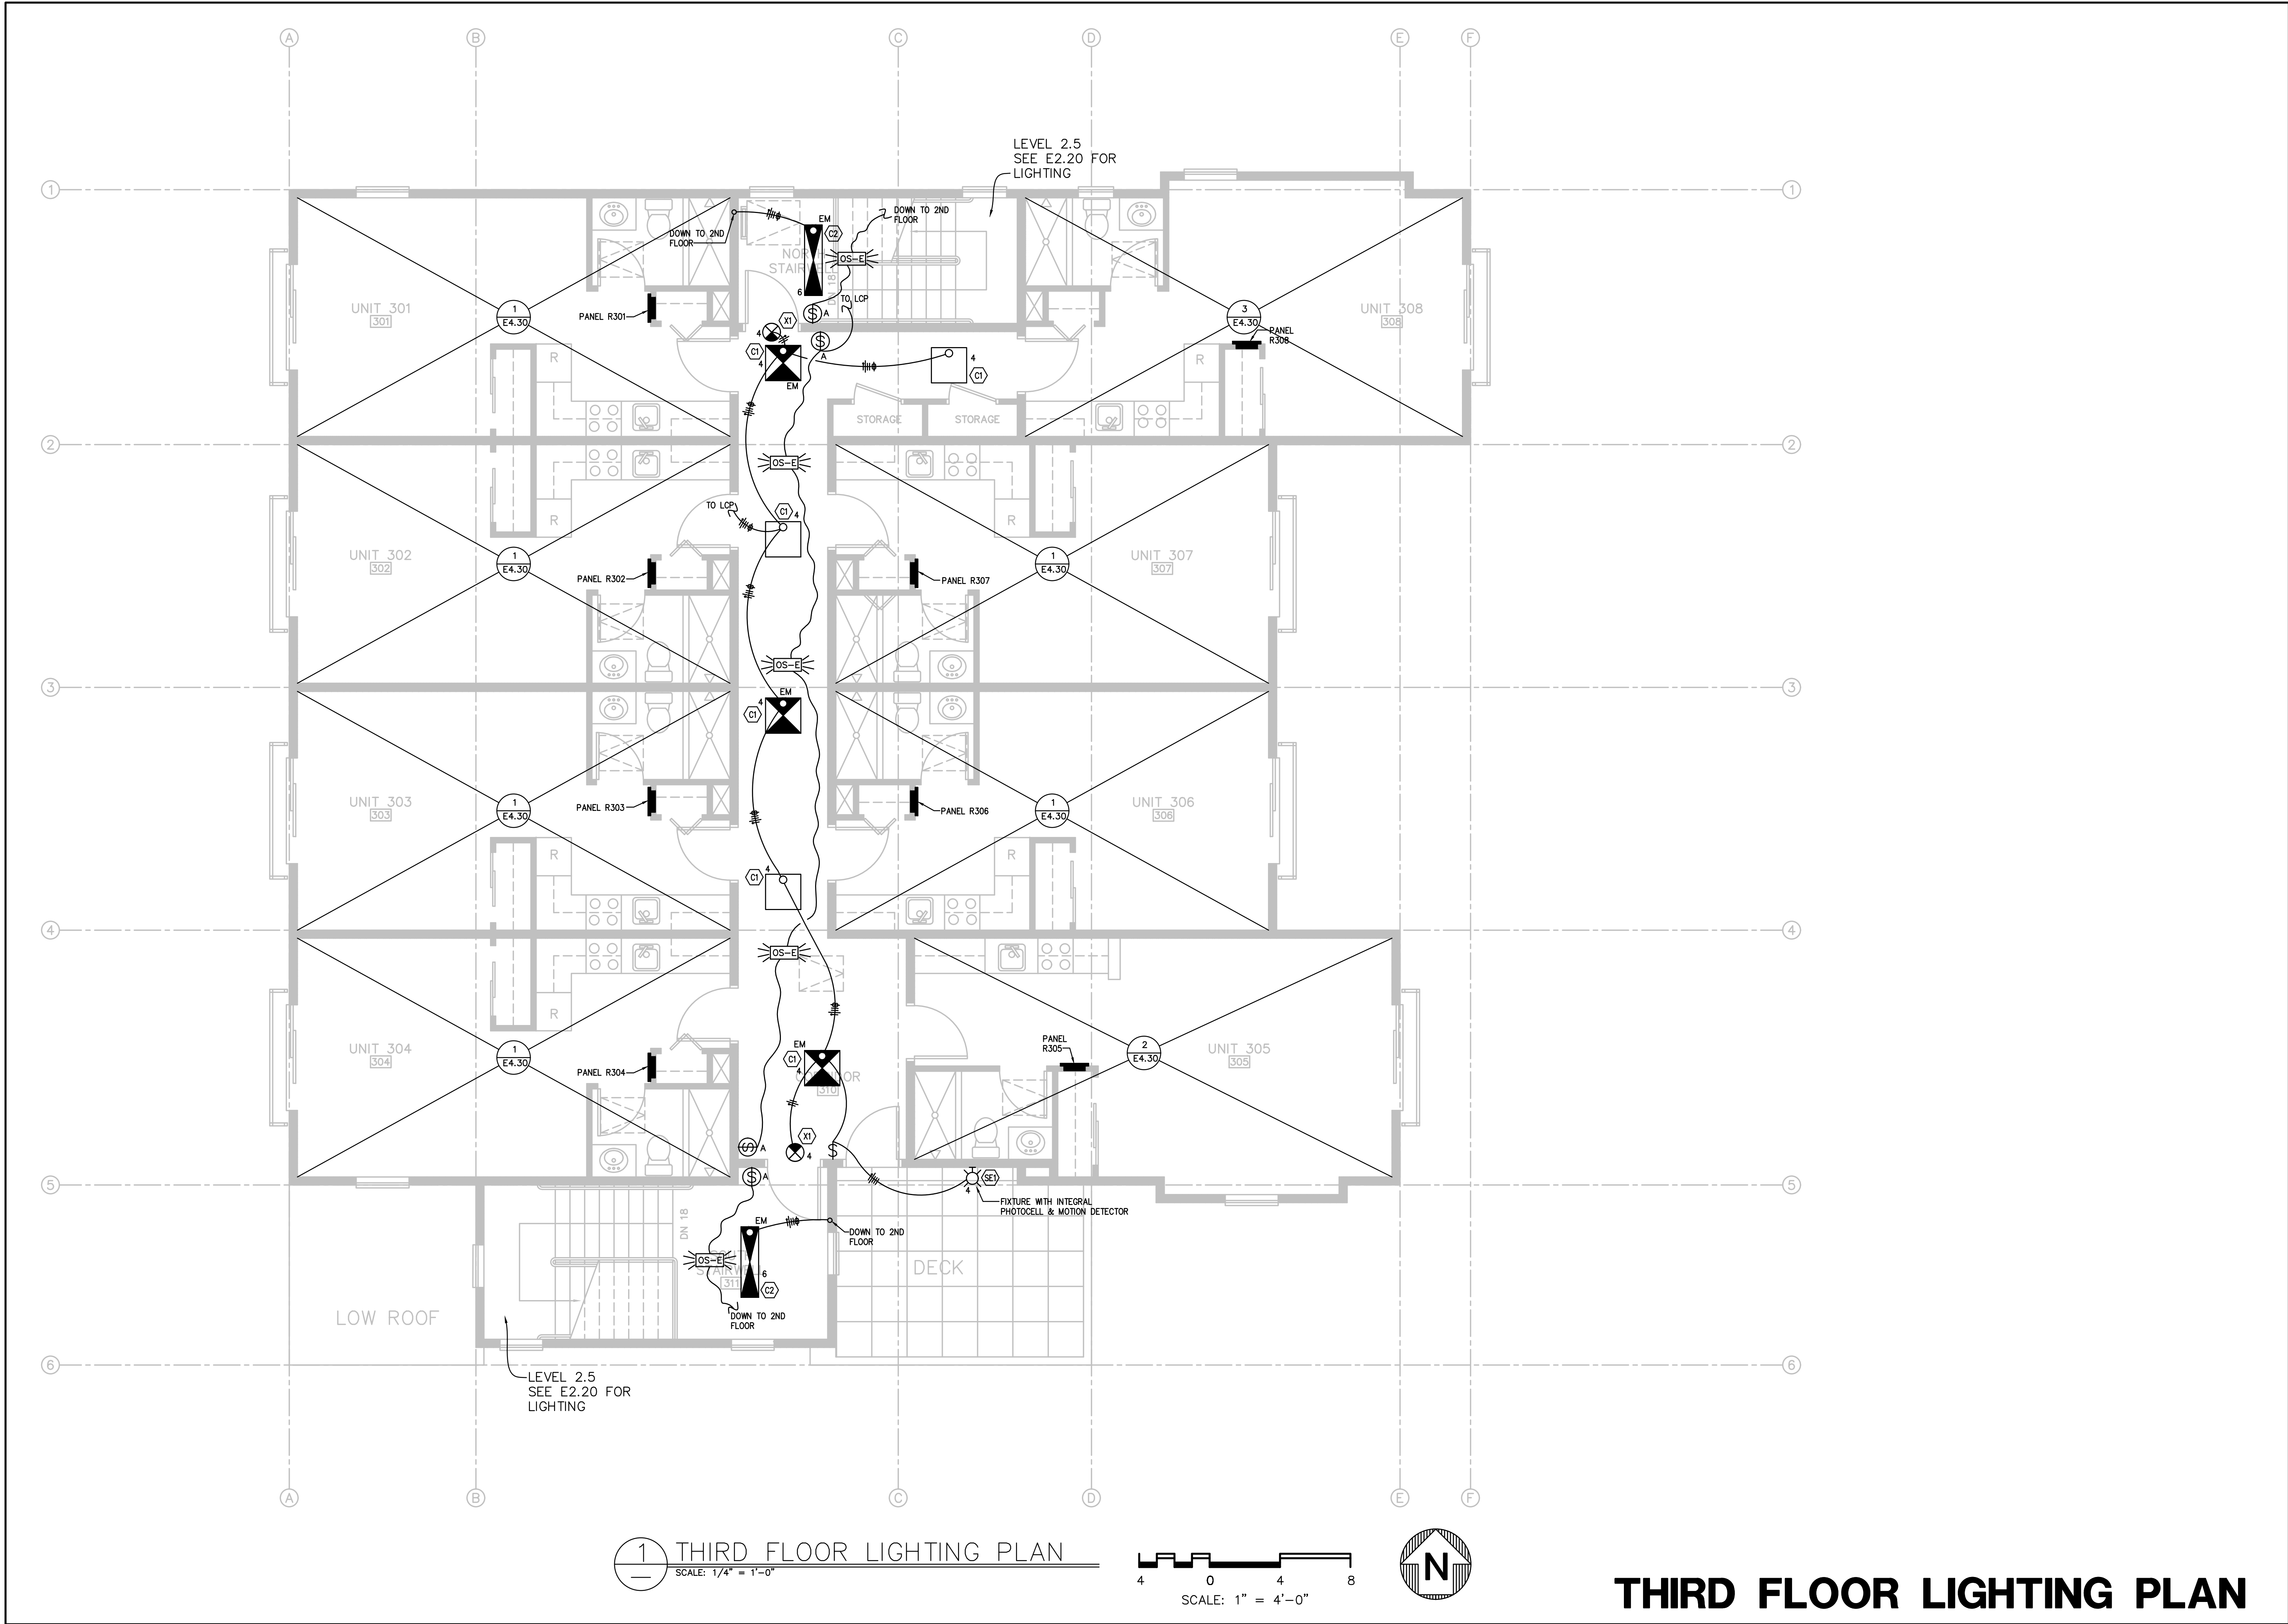

PROPRIETARY DATA		REGISTERED PROFESSIONAL ENGINEER	
THE USE OF THE PLANS AND SPECIFICATIONS IS LIMITED TO THE PROJECT AND SITE SPECIFICALLY IDENTIFIED HEREON. ANY OTHER USE OF THESE PLANS OR SPECIFICATIONS WITHOUT THE WRITTEN CONSENT OF CENTRAL PACIFIC ENGINEERING, INC. IS PROHIBITED. THE USER AGREES TO HOLD CENTRAL PACIFIC ENGINEERING, INC. HARMLESS FROM ANY AND ALL CLAIMS, DAMAGES, LOSSES AND EXPENSES, INCLUDING REASONABLE ATTORNEY'S FEES, THAT MAY BE ASSERTED AGAINST CENTRAL PACIFIC ENGINEERING, INC. BY ANY THIRD PARTY AS A RESULT OF THE USER'S USE OF THESE PLANS OR SPECIFICATIONS.		DATE GRANTED: 08-30-24	
E 15492		EXPIRATION DATE: 08-30-24	
ELECTRICAL		STATE OF CALIFORNIA	
CENTRAL PACIFIC ENGINEERING, INC.		Professional Engineers	
9035 Soquel Avenue, Suite 205		Santa Cruz, CA 95062	
831-478-1525		CPE JOB 21-044-0	
COPYRIGHT 2024		SHEET	
AFFORDABLE HOUSING PROJECT		REV.	
LOCATION: 415 NATURAL BRIDGES DRIVE		DESCRIPTION	
SANTA CRUZ, CALIFORNIA		ISSUED FOR PLAN CHECK	
OWNER: THE HOUSING AUTHORITY OF THE COUNTY OF SANTA CRUZ		PLAN CHECK & OWNER COMMENTS	
DR. SAK		DATE	
DATE		08/27/22	
CHK. DGS		10/14/22	
APPD. DGS		SCALE	
04/20/22		AS NOTED	
JOB NO. 21-044-0		DWG. NO. E2.30	
SH 11 OF 32		REV. 1	

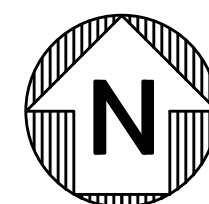


TITLE: AFFORDABLE HOUSING PROJECT		REV.	DATE
JOB NO. 21-044-0		<input checked="" type="checkbox"/>	08/27/22
DWG. NO. E3.10		<input checked="" type="checkbox"/>	10/14/22
SH OF	REV.		
12	1		
LOCATION: 415 NATURAL BRIDGES DRIVE SANTA CRUZ, CALIFORNIA		DESCRIPTION PLAN CHECK & OWNER COMMENTS	
OWNER: THE HOUSING AUTHORITY OF THE COUNTY OF SANTA CRUZ		<input checked="" type="checkbox"/>	
DR.	DATE	CHK.	SCALE
SAK	04/20/1722	DGS	AS NOTED
		<input checked="" type="checkbox"/>	
		<input checked="" type="checkbox"/>	
		<input checked="" type="checkbox"/>	
		<input checked="" type="checkbox"/>	

Central Pacific Engineering, Inc.

Professional Engineers
9035 Soquel Avenue, Suite 205
Santa Cruz, CA 95062


CPE-008-21-044-0

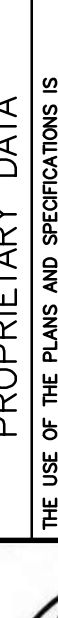



THE USE OF THE PLANS AND SPECIFICATIONS IS LIMITED TO THE PROJECT AND SITE INDICATED HEREON. ANY OTHER USE OF THESE PLANS OR SPECIFICATIONS WITHOUT THE WRITTEN CONSENT OF CENTRAL PACIFIC ENGINEERING, INC. IS PROHIBITED. NO LIABILITY WILL BE ASSUMED FOR ANY DAMAGE OR INJURY TO PERSONS OR PROPERTY ARISING OUT OF THE USE OF THESE PLANS OR SPECIFICATIONS. THE ACCEPTANCE OF THESE RESTRICTIONS IS A CONDITION OF THE USE OF THESE PLANS AND SPECIFICATIONS.

CENTRAL PACIFIC ENGINEERING, INC.
1492
03-24-24

PROPRIETARY DATA

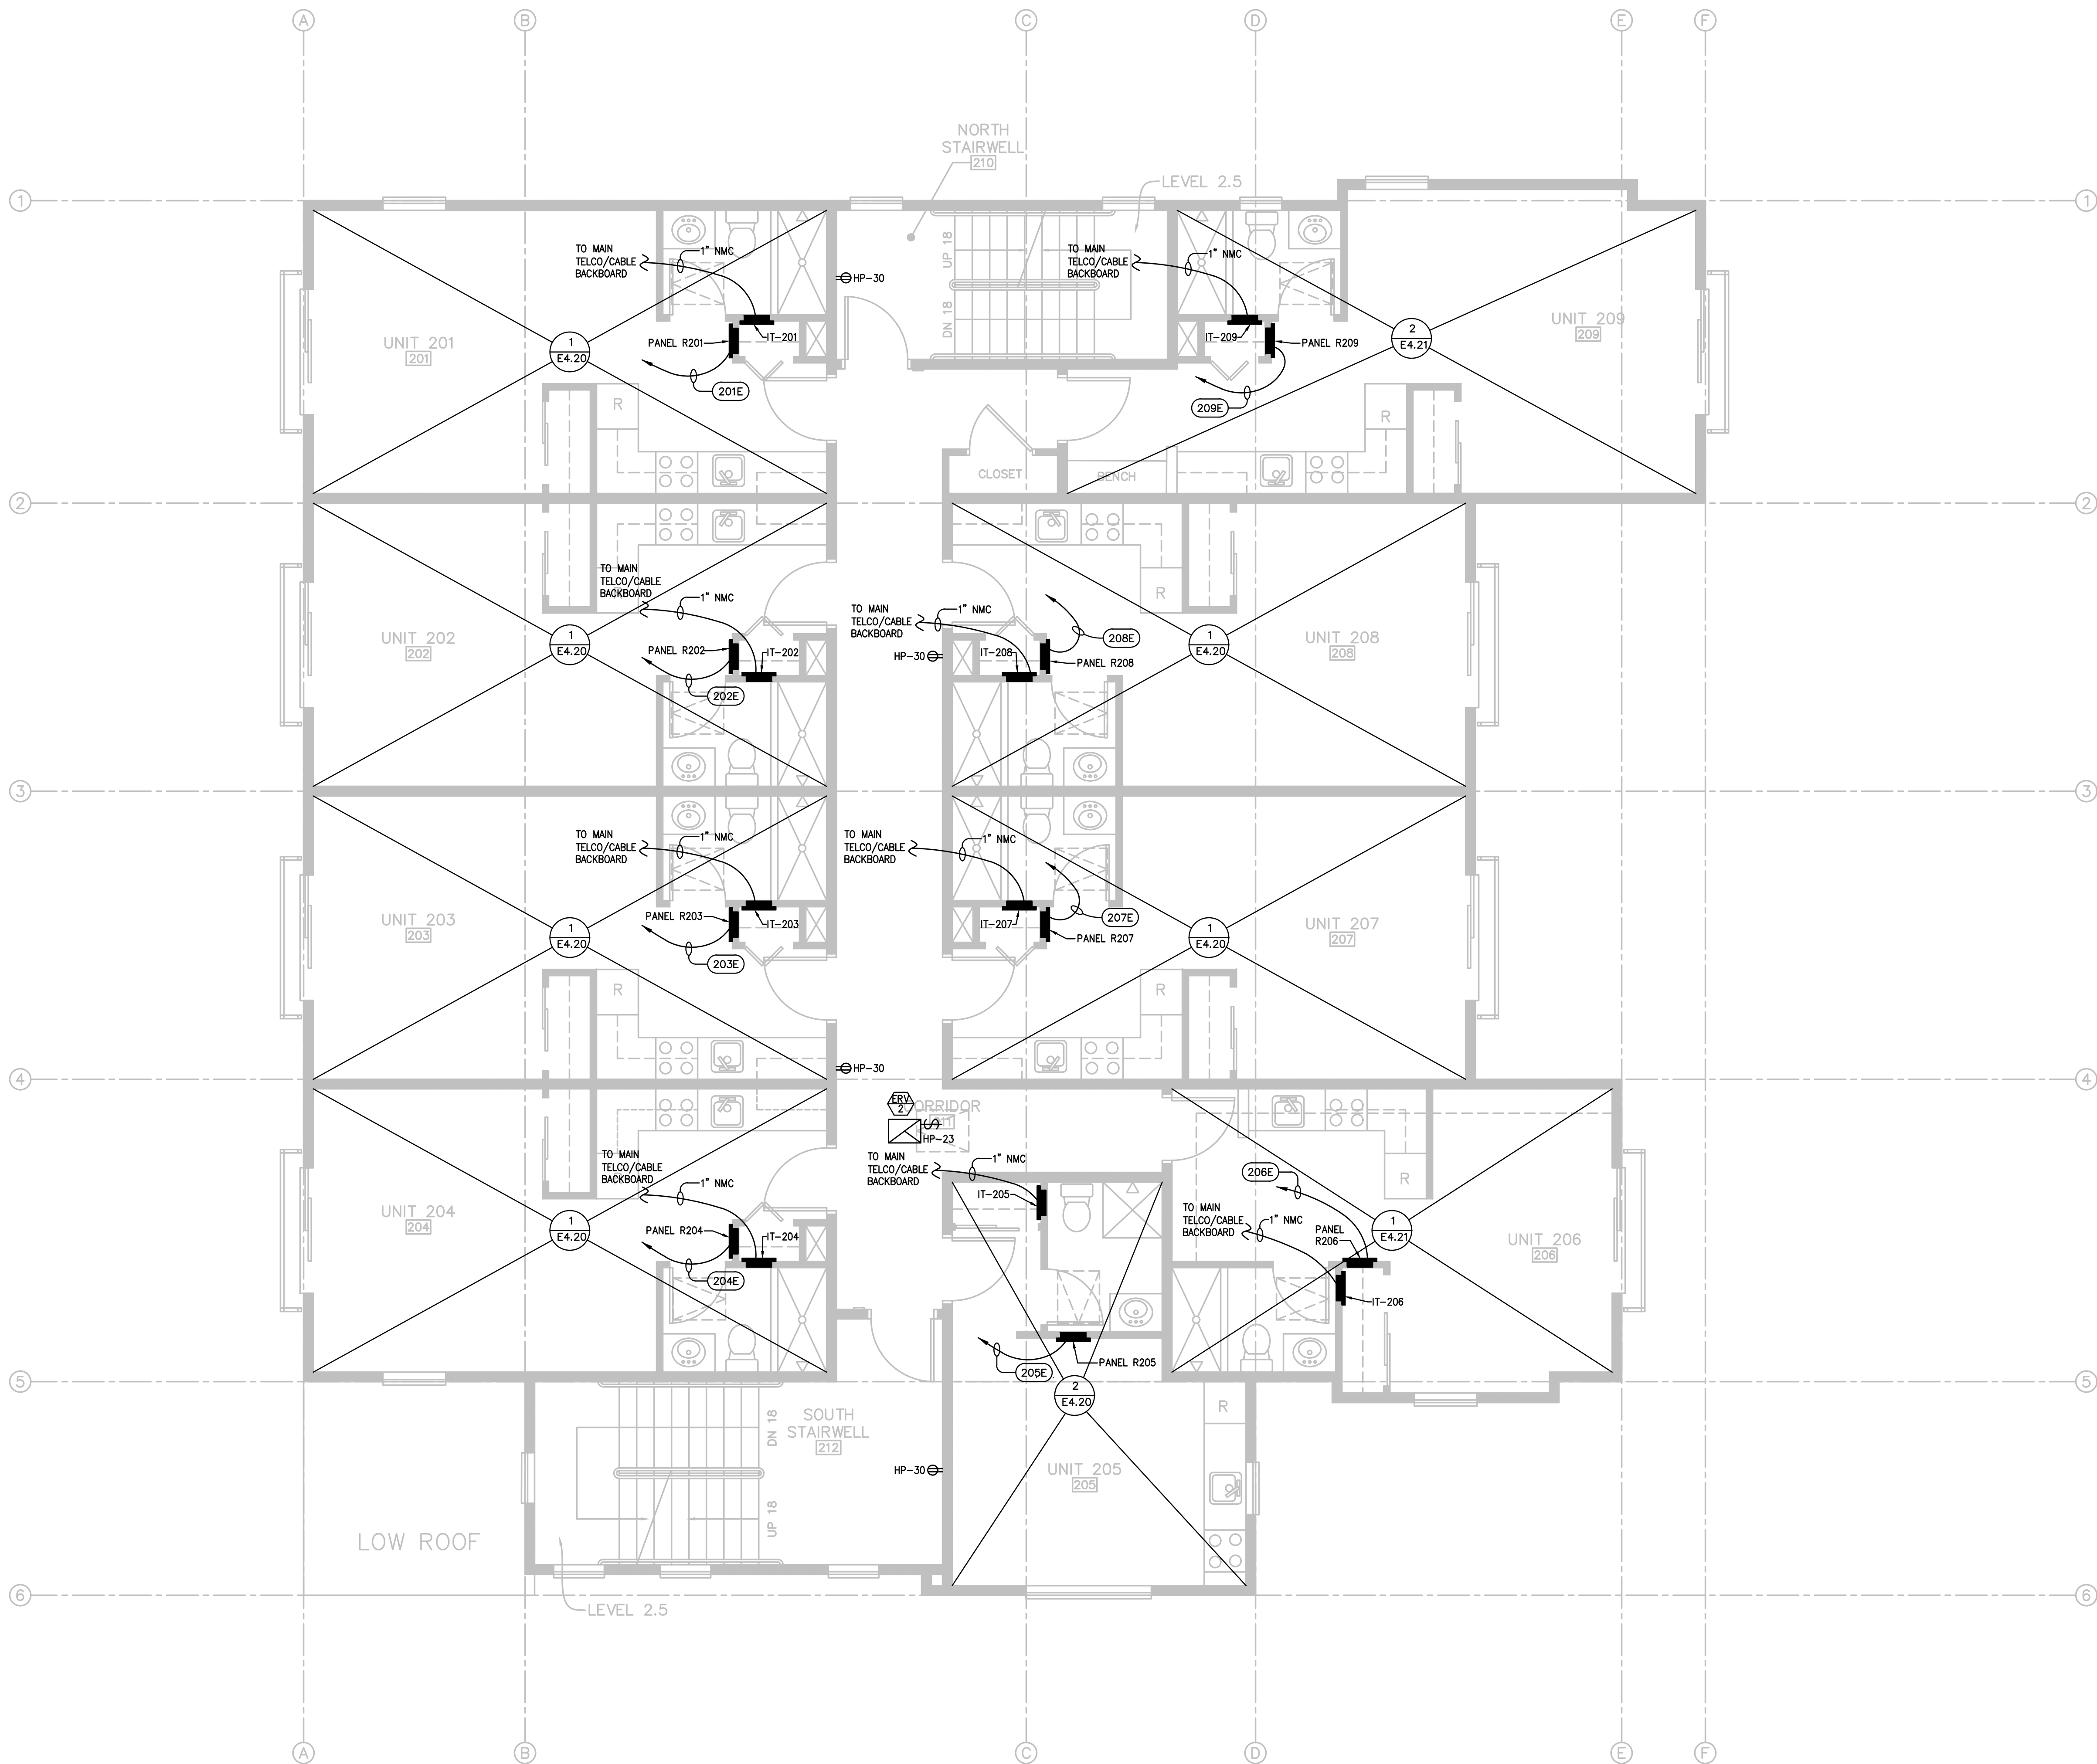


1 SECOND FLOOR POWER PLAN
SCALE: 1/4" = 1'-0"

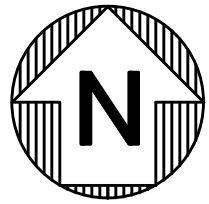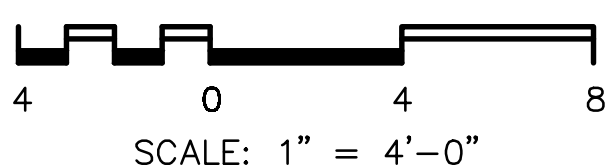

SECOND FLOOR POWER PLAN

PROPRIETARY DATA THE USE OF THE PLANS AND SPECIFICATIONS IS LIMITED TO THE PROJECT AND SITE SPECIFICALLY IDENTIFIED HEREON. ANY REUSE OR MODIFICATION OF THESE PLANS WITHOUT THE WRITTEN CONSENT OF CENTRAL PACIFIC ENGINEERING, INC. IS PROHIBITED. THE USER SHALL BE RESPONSIBLE FOR OBTAINING ALL NECESSARY PERMITS AND FOR VERIFYING THE ACCURACY OF ALL INFORMATION PROVIDED. THE USER SHALL RELEASE CENTRAL PACIFIC ENGINEERING, INC. FROM ALL LIABILITY AND DAMAGES, INCLUDING REASONABLE ATTORNEY'S FEES, ARISING OUT OF OR FROM THE USE OF THESE PLANS AND SPECIFICATIONS. COPYRIGHT © 2006 CENTRAL PACIFIC ENGINEERING, INC.	
Central Pacific Engineering, Inc. Professional Engineers 9035 Soquel Avenue, Suite 205 Santa Cruz, CA 95062 831-478-1525 CPE JOB 21-044-0	
TITLE: AFFORDABLE HOUSING PROJECT	DATE: 08/27/22
LOCATION: 415 NATURAL BRIDGES DRIVE SANTA CRUZ, CALIFORNIA	ISSUED FOR PLAN CHECK
OWNER: THE HOUSING AUTHORITY OF THE COUNTY OF SANTA CRUZ	PLAN CHECK & OWNER COMMENTS
DR: SAK	CHK: DGS
DATE: 04/20/22	APPD: DGS
SCALE: AS NOTED	REV: 1
JOB NO.: 21-044-0	REV.: 1
DWG. NO.: E3.20	SH OF: 13 OF 32

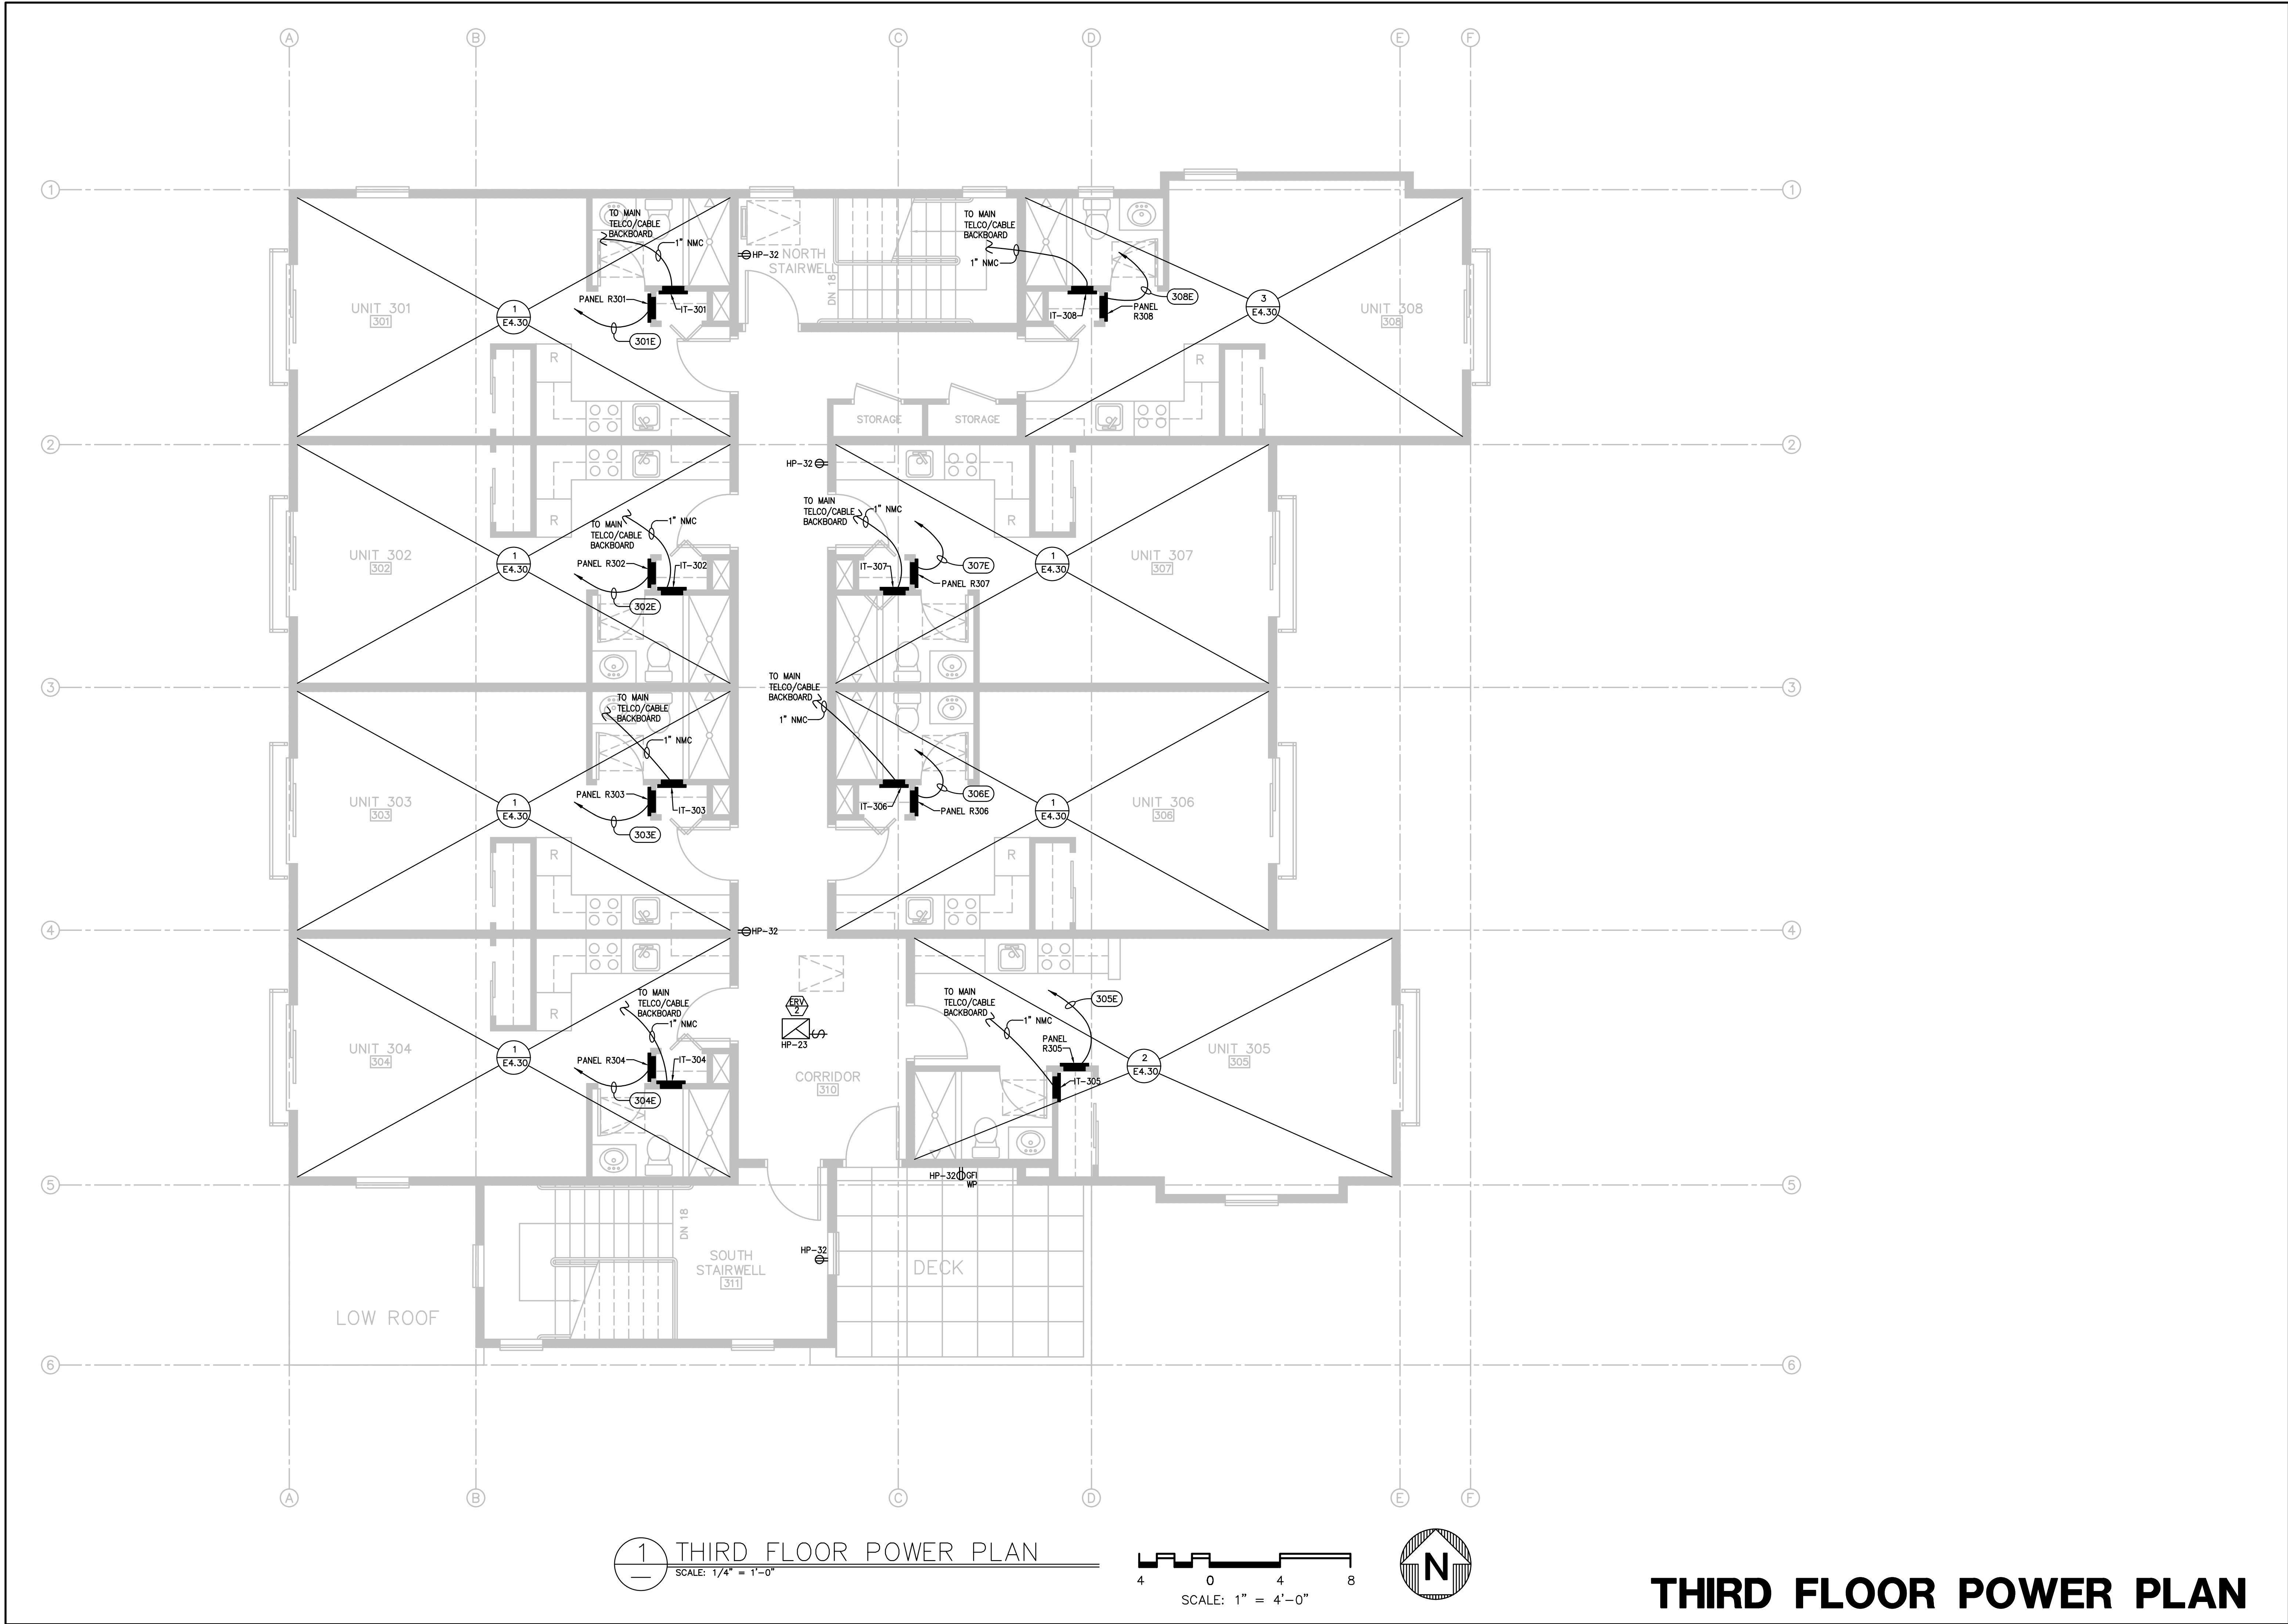

TITLE: AFFORDABLE HOUSING PROJECT		REV.	DESCRIPTION	DATE
JOB NO. 21-044-0		1	ISSUED FOR PLAN CHECK	08/27/22
DWG. NO. E3.30		2	PLAN CHECK & OWNER COMMENTS	10/14/22
SH 14 OF 32		3		
REV. 1		4		

DR.	DATE	CHK.	APPD.	SCALE
SAK	04/20/22	DGS	DGS	AS NOTED

LOCATION: 415 NATURAL BRIDGES DRIVE
SANTA CRUZ, CALIFORNIA
OWNER: THE HOUSING AUTHORITY OF THE COUNTY OF SANTA CRUZ

PROFESSIONAL ENGINEER
Central Pacific Engineering, Inc.
9035 Soquel Avenue, Suite 205
Santa Cruz, CA 95062
831-478-1525
CPE JOB 21-044-0

REGISTERED PROFESSIONAL ENGINEER
DATE GRANT: 11/15/92
EXPIRATION DATE: 09-30-24
ELECTRICAL
STATE OF CALIFORNIA

THE USE OF THE PLANS AND SPECIFICATIONS IS LIMITED TO THE PROJECT AND SITE FOR WHICH THEY WERE PREPARED, AND PUBLICATION THEREOF IS FOR INFORMATION ONLY. NO WARRANTIES, EXPRESS OR IMPLIED, ARE MADE BY THE ENGINEER OR ARCHITECT FOR THE PROJECT OR FOR THE PLANS AND SPECIFICATIONS. THE USER OF THESE PLANS AND SPECIFICATIONS SHALL BE RESPONSIBLE FOR OBTAINING ALL NECESSARY PERMITS AND FOR THE PROTECTION OF THE PROJECT FROM ANY DAMAGE OR LOSS OF EVIDENCE. THE USER SHALL BE RESPONSIBLE FOR THE PROTECTION OF THE PROJECT FROM ANY DAMAGE OR LOSS OF EVIDENCE. THE USER SHALL BE RESPONSIBLE FOR THE PROTECTION OF THE PROJECT FROM ANY DAMAGE OR LOSS OF EVIDENCE.

SHEET NOTES:

- TITLE 24 COMPLIANT VACUANCY SWITCH FOR BATH LIGHTS AND ERV CONTROL SWITCH, SUPPLIED BY MECHANICAL AND INSTALLED BY ELECTRICAL.
- FC-1 LINE VOLTAGE T-STAT SUPPLIED BY MECHANICAL AND INSTALLED BY ELECTRICAL. FIELD COORDINATE WITH MECHANICAL WORK. COORDINATE IN FIELD EXACT LOCATION OF T-STAT WITH ARCHITECT.
- USE MAX LENGTH OF UNDER LIGHT TO FIT AVAILABLE CABINET SPACE.
- SMOKE DETECTORS AND COMBO SMOKE/CO SHALL BE HARDWIRED AND INTERCONNECTED IF MORE THAN ONE PER UNIT.
- FIRE SMOKE DAMPER(S) FIELD COORDINATE WITH ARCH, MECH AND FIRE ALARM WORK. SEE ARCH, MECH AND FIRE ALARM DWGS.

SHEET LEGEND


- 1 - 3/4" NMT WITH 1 - CAT 6 DATA CABLE AND 1-RG11 COAX CABLE TO APT TELCO/CATV ENCLOSURE '1T-XXX'
-2-PORT QUICKPORT WALLPLATE, PART # 41080-2WP
-QUICKPORT F-CONNECTOR COUPLER, PART # 41084-FWF
-HOME SE QUICKPORT JACK, PART # 5EHOM-RWS

- PANEL IT-XXX; LEVITON
-14" WIRELESS ENCLOSURE WITH VENTED COVER, PART # 49605-140
-COMBO PANEL WITH 1X4 PHONE, DATA AND 1X6 VIDEO PANEL, PART # 47603-DP6
-NON-SURGE J-BOX KIT, PART # 47605-ACN
-UNIVERSAL SHELF BRACKET, PART # 49605-AUB
-SADDLE TIE KIT, PART # 49605-AST




GENERAL NOTES:

- ALL RECEPTACLES IN THE BEDROOM, THE DINING ROOM, HALLWAY, DEN, LIBRARIES, CLOSET, THE FAMILY ROOM AND SIMILAR ROOMS SHALL BE ARC-FAULT CIRCUIT INTERRUPTER PER CEC ARTICLE 210.12.
- ALL RECEPTACLES IN UNITS SHALL BE TAMPER-RESISTANT RECEPTACLES PER CEC ARTICLE 406.14.
- ALL BUILDING EXTERIOR WEATHER PROOF RECEPTACLE COVERS SHALL BE IN-USE TYPE.

PANEL NAME: 'R101', 'R102'				LOCATION: RESIDENTIAL UNIT				PANEL TYPE: <input type="checkbox"/> PANEL BOARD <input checked="" type="checkbox"/> LOAD CENTER														
VOLTAGE: 120/208		BUS RATING: 125		1		PHASE 3		WIRE + GND.		ENCLOSURE TYPE: NEMA 1		MOUNTING: <input type="checkbox"/> SURFACE <input checked="" type="checkbox"/> FLUSH										
SHORT CIR RATING: 10 KAIC		BUS TYPE: <input checked="" type="checkbox"/> COPPER		<input type="checkbox"/> ALUMINUM						INTERIOR: <input type="checkbox"/> MAIN LUGS		<input checked="" type="checkbox"/> MAIN CIRCUIT BREAKER										
O.C. DEVICES: <input type="checkbox"/> BOLT-ON		<input checked="" type="checkbox"/> PLUG-ON		DEVICE FAMILY:						<input type="checkbox"/> SUB-FEED CIRCUIT BREAKER												
DESCRIPTION		CT	L	P	N	VOLT	AMPS	BRK.	CT	NO.	BUS	CONN.	CT	NO.	BRK.	VOLT	AMPS	BRK.	CT	NO.	DESCRIPTION	
MAIN		X	X						100	1	●	●	2	20	1000		X					GARBAGE DISP
MAIN		X	X						—	3	●	●	4	20	1500	X						KIT APPLIANCE
OVEN COOKTOP		X				4000	50	5			●	●	6	20	1500	X						KIT APPLIANCE
OVEN COOKTOP		X					4000	—	7		●	●	8	20	600	X						REFER
BATH GFI		X				1500		20	9		●	●	10	20	1440		X					PLUGS
HEATER		X					2000	30	11		●	●	12	20	400	X	X					LIGHTS
LOW VOLTAGE CABNET		X				200		20	13		●	●	14	20	210	X						ERV & FSD
SPACE								15	15		●	●	16									SPACE
SPACE								17	17		●	●	18									SPACE
SPACE								19	19		●	●	20									SPACE
SPACE								21	21		●	●	22									SPACE
SPACE								23	23		●	●	24									SPACE
								25	25		●	●	25									
								26	26		●	●	26									
								27	27		●	●	27									
								28	28		●	●	28									
								29	29		●	●	29									
								30	30		●	●	30									
								31	31		●	●	31									
								32	32		●	●	32									
								33	33		●	●	33									
								34	34		●	●	34									
TOTALS								5700	6000							4150	2500					
BUS A		9.9 KVA		ACCESSORIES:		COLOR		COVER		NAME PLATES		OTHER										
BUS B		8.5 KVA		EITHER		<input checked="" type="checkbox"/> ANSI 61 LT GRAY <input type="checkbox"/> ANSI 49 DK GRAY <input type="checkbox"/> OTHER:		<input type="checkbox"/> DOOR-IN-DOOR <input type="checkbox"/> KEYED LATCH <input type="checkbox"/> OTHER:		<input checked="" type="checkbox"/> 1/4" LETTERS <input checked="" type="checkbox"/> WHITE LETTERS ON BLACK <input checked="" type="checkbox"/> SCREW MOUNTED		<input checked="" type="checkbox"/> GROUND BAR <input type="checkbox"/> PNL DIRECTORY <input type="checkbox"/> ISO GROUND BAR										
TOTAL		18.4 KVA																				

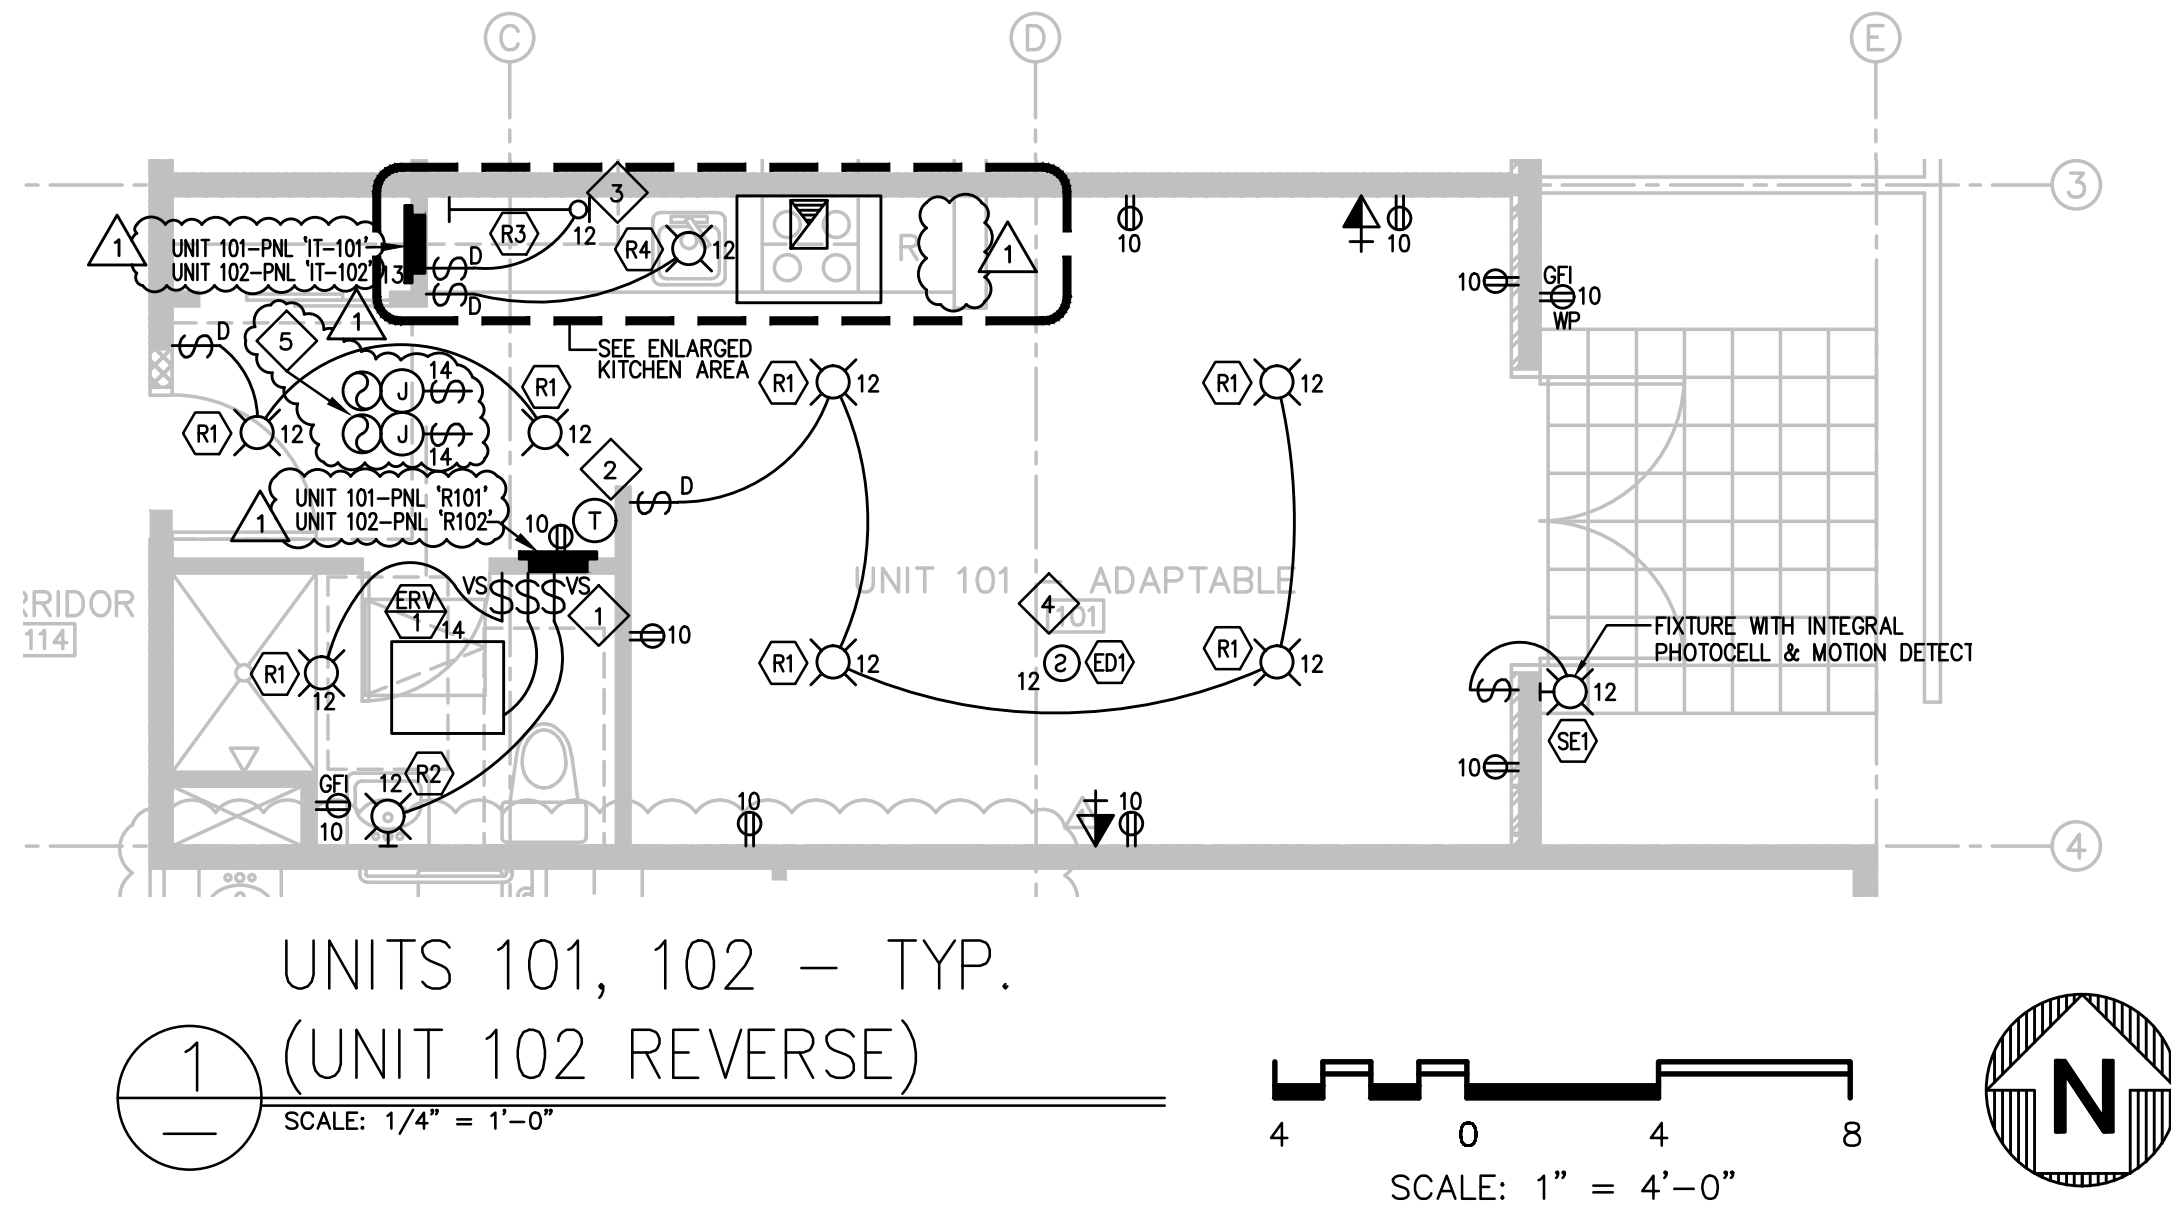

PANEL NAME: "R103"				LOCATION: RESIDENTIAL UNIT				PANEL TYPE: <input type="checkbox"/> PANEL BOARD <input checked="" type="checkbox"/> LOAD CENTER									
VOLTAGE: 120/208		BUS RATING: 125		1		PHASE 3		WIRE + GND.		ENCLOSURE TYPE: NEMA 1				MOUNTING: <input type="checkbox"/> SURFACE <input checked="" type="checkbox"/> FLUSH			
SHORT CIR RATING: 10 KAIC				BUS TYPE: <input checked="" type="checkbox"/> COPPER <input type="checkbox"/> ALUMINUM				INTERIOR: <input type="checkbox"/> MAIN LUGS <input checked="" type="checkbox"/> MAIN CIRCUIT BREAKER									
O.C. DEVICES: <input type="checkbox"/> BOLT-ON <input checked="" type="checkbox"/> PLUG-ON				DEVICE FAMILY:				<input type="checkbox"/> SUB-FEED CIRCUIT BREAKER									
DESCRIPTION		LTG	PWR	VOLT ΦA	AMPS ΦB	BRK.	CKT NO.	BUS A	CONN. B	CKT NO.	BRK.	VOLT ΦA	AMPS ΦB	PWR	LTG	DESCRIPTION	
MAIN		X	X			100	1	●		2	20	1000		X		GARBAGE DISP	
MAIN		X	X			—	3	●		4	20	1500		X		KIT APPLIANCE	
OVEN COOKTOP		X		4000		50	5	●		6	20	1500		X		KIT APPLIANCE	
OVEN COOKTOP		X		4000		—	7	●		8	20	600		X		REFER	
BATH GFI		X		1500		20	9	●		10	20	1440		X		PLUGS	
HEATER		X			2000	30	11	●		12	20	400		X		LIGHTS	
LOW VOLTAGE CABNET		X		200		20	13	●		14	20	210		X		ERV & FSD	
SPACE							15	●		16						SPACE	
SPACE							17	●		18						SPACE	
SPACE							19	●		20						SPACE	
SPACE							21	●		22						SPACE	
SPACE							23	●		24						SPACE	
							25	●		26							
							27	●		28							
							29	●		30							
							31	●		32							
							33	●		34							
							35	●		36							
							37	●		38							
							39	●		40							
TOTALS						5700	6000					4150	2500				
BUS A 9.9 KVA		ACCESSORIES:				COLOR		COVER				NAME PLATES				OTHER	
BUS B 8.5 KVA		EITHER {				<input checked="" type="checkbox"/> ANSI 61 LT GRAY		<input type="checkbox"/> DOOR-IN-DOOR				<input checked="" type="checkbox"/> 1/4" LETTERS				<input checked="" type="checkbox"/> GROUND BAR	
						<input type="checkbox"/> ANSI 49 DK GRAY		<input type="checkbox"/> KEYED LATCH				<input checked="" type="checkbox"/> WHITE LETTERS ON BLACK				<input checked="" type="checkbox"/> PNL DIRECTORY	
						<input type="checkbox"/> OTHER:		<input type="checkbox"/> OTHER:				<input checked="" type="checkbox"/> SCREW MOUNTED				<input type="checkbox"/> ISO GROUND BAR	
TOTAL 18.4 KVA																	

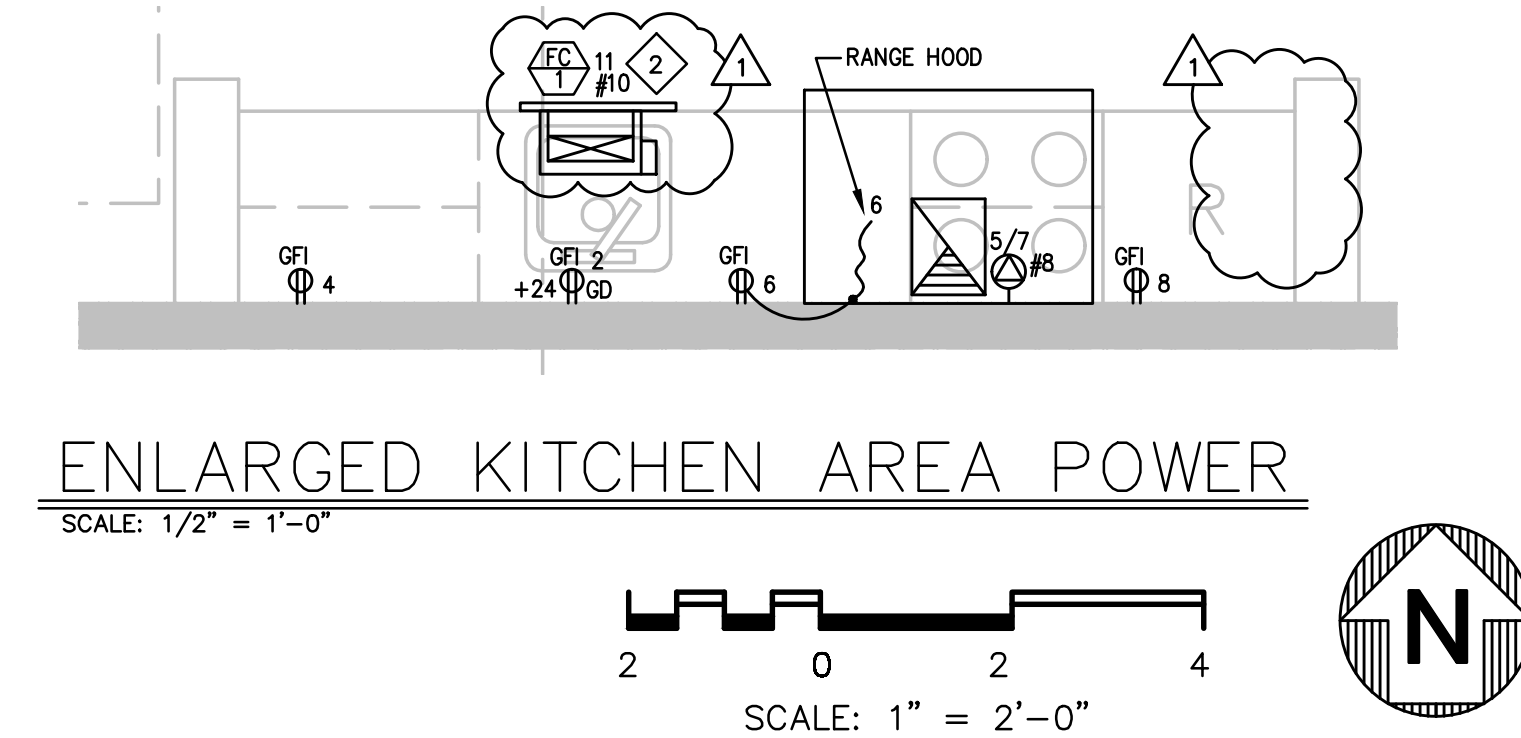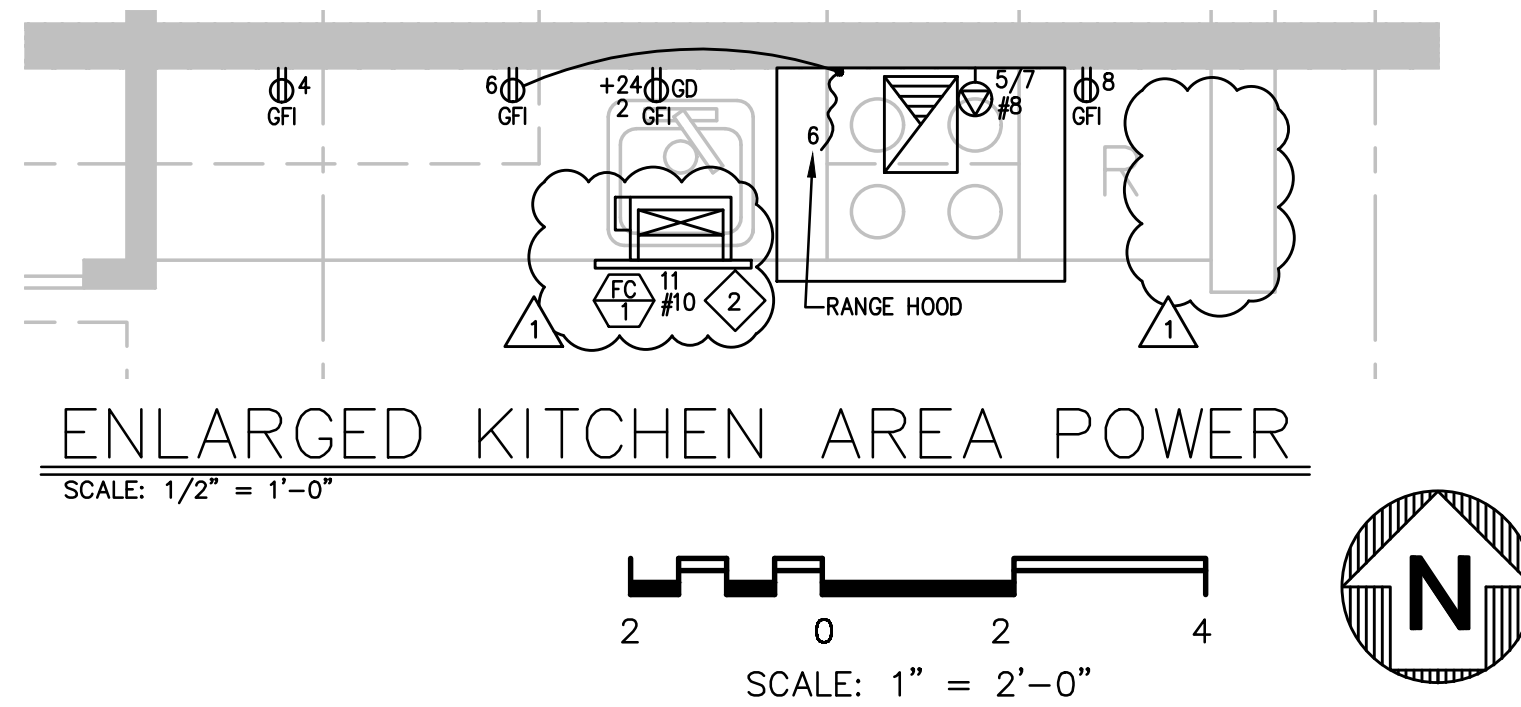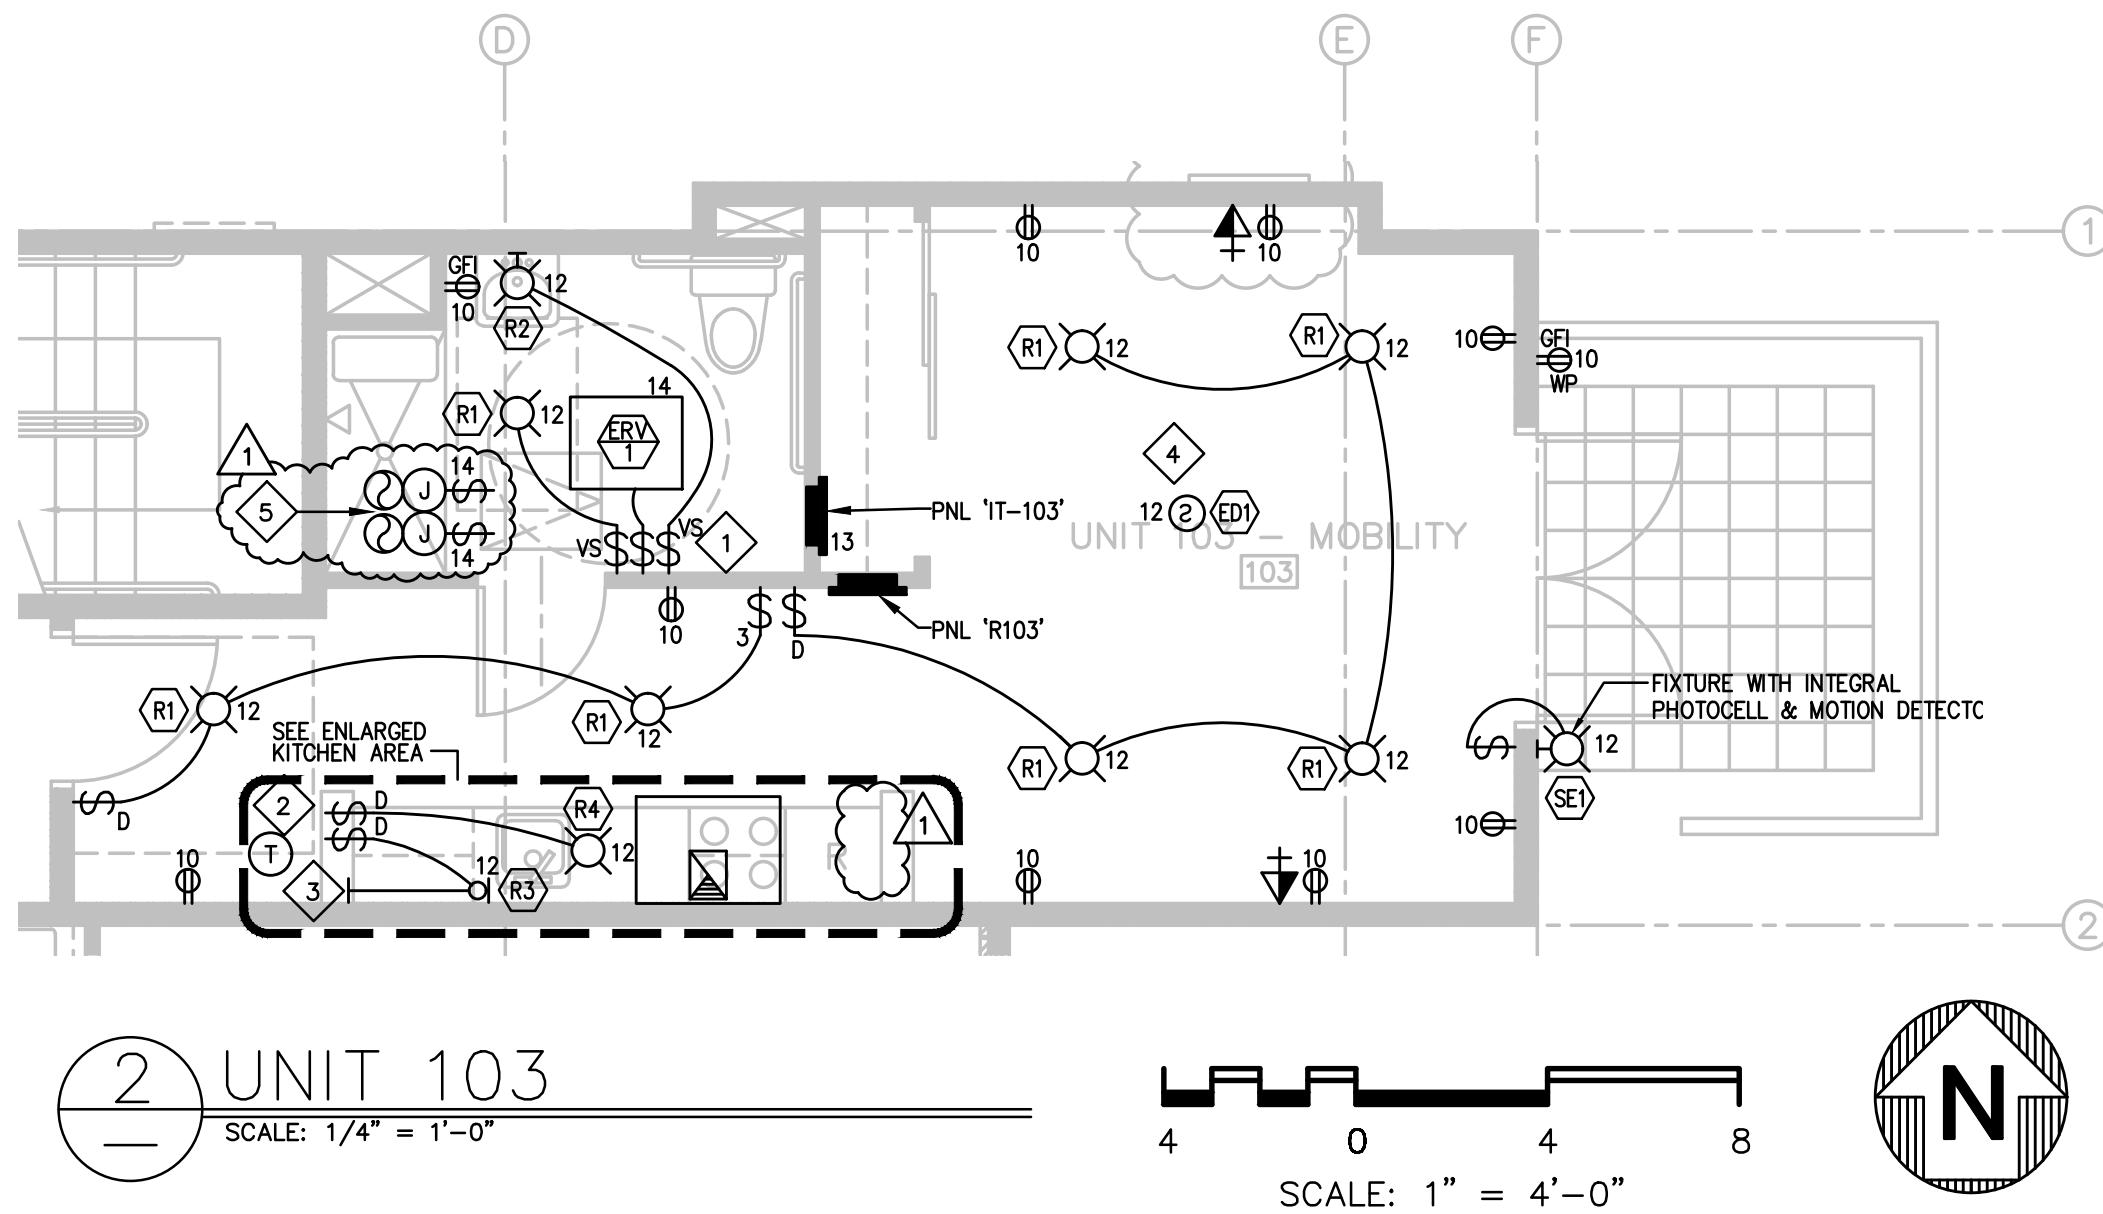

LIGHTING & POWER PLANS - UNITS 101, 102, 103

PROPRIETARY DATA

THE USE OF THE PLANS AND SPECIFICATIONS IS LIMITED TO THE PROJECT FOR WHICH THEY WERE PREPARED, AND PUBLICATION THEREOF IN ANY FORM OR BY ANY MEANS WITHOUT THE WRITTEN CONSENT OF CENTRAL PACIFIC ENGINEERING, INC. IS PROHIBITED. THE PROJECT FOR WHICH THE PLANS AND SPECIFICATIONS WERE PREPARED IS NOT TO BE USED FOR ANY OTHER PROJECT WITHOUT THE WRITTEN CONSENT OF CENTRAL PACIFIC ENGINEERING, INC. THE ACCEPTANCE OF THESE PLANS AND SPECIFICATIONS BY ANY OTHER PARTY DOES NOT CONSTITUTE A WARRANTY OR ENDORSEMENT OF THE QUALITY OF THE WORK OR THE RESULTS THEREOF. THE USER OF THESE PLANS AND SPECIFICATIONS SHALL BE RESPONSIBLE FOR OBTAINING ALL NECESSARY PERMITS AND FOR COMPLYING WITH ALL APPLICABLE CODES AND REGULATIONS. THE USER SHALL BE RESPONSIBLE FOR OBTAINING ALL NECESSARY INFORMATION REGARDING THE PROJECT AND THE SITE CONDITIONS. THE USER SHALL BE RESPONSIBLE FOR OBTAINING ALL NECESSARY INFORMATION REGARDING THE PROJECT AND THE SITE CONDITIONS. THE USER SHALL BE RESPONSIBLE FOR OBTAINING ALL NECESSARY INFORMATION REGARDING THE PROJECT AND THE SITE CONDITIONS.

REGISTERED PROFESSIONAL ENGINEER
DATE GRANTED: 11/15/2011
EXPIRATION DATE: 08-30-24
E 15492
ELECTRICAL
STATE OF CALIFORNIA

Central Pacific Engineering, Inc.
Professional Engineers
9035 Soquel Avenue, Suite 205
Santa Cruz, CA 95062
831-478-1525
CPE JOB 21-044-0

REV.	DESCRIPTION	DATE
1	ISSUED FOR PLAN CHECK	08/27/22
2	PLAN CHECK & OWNER COMMENTS	10/14/22
3		
4		
5		

TITLE: **AFFORDABLE HOUSING PROJECT**

LOCATION: 415 NATURAL BRIDGES DRIVE
SANTA CRUZ, CALIFORNIA

OWNER: THE HOUSING AUTHORITY OF THE COUNTY OF SANTA CRUZ

DR. DATE CHK. APPD. SCALE

SAK 04/20/22 DGS DGS AS NOTED

JOB NO. 21-044-0

DWG. NO. **E4.10**

SH 16 OF 32 REV. 1

SHEET LEGEND

- 1 - 3/4" NMT WITH 1 - CAT 6 DATA CABLE AND 1-RG11 COAX CABLE TO APT TELCO/CATV ENCLOSURE 'IT-XXX'
-2-PORT QUICKPORT WALLPLATE, PART # 41080-2WP
-QUICKPORT F-CONNECTOR COUPLER, PART # 41084-FWF
-HOME SE QUICKPORT JACK, PART # SEHOM-RWS
- PANEL IT-XXX; LEVITON
-14" WIRELESS ENCLOSURE WITH VENTED COVER, PART # 49605-140
-COMBO PANEL WITH 1X4 PHONE, DATA AND 1X6 VIDEO PANEL, PART # 47603-DP6
-NON-SURGE J-BOX KIT, PART # 47605-ACN
-UNIVERSAL SHELF BRACKET, PART # 49605-AUB
-SADDLE TIE KIT, PART # 49605-AST

GENERAL NOTES:

- ALL RECEPTACLES IN THE BEDROOM, THE DINING ROOM, HALLWAY, DEN, LIBRARIES, CLOSET, THE FAMILY ROOM AND SIMILAR ROOMS SHALL BE ARC-FAULT CIRCUIT INTERRUPTER PER CEC ARTICLE 210.12.
- ALL RECEPTACLES IN UNITS SHALL BE TAMPER-RESISTANT RECEPTACLES PER CEC ARTICLE 406.14.
- ALL BUILDING EXTERIOR WEATHER PROOF RECEPTACLE COVERS SHALL BE IN-USE TYPE.

SHEET NOTES:

- TITLE 24 COMPLIANT VACANCY SWITCH FOR BATH LIGHTS AND ERV CONTROL SWITCH, SUPPLIED BY MECHANICAL AND INSTALLED BY ELECTRICAL.
- FC-1 LINE VOLTAGE T-STAT SUPPLIED BY MECHANICAL AND INSTALLED BY ELECTRICAL. FIELD COORDINATE WITH MECHANICAL WORK. COORDINATE IN FIELD EXACT LOCATION OF T-STAT WITH ARCHITECT.
- USE MAX LENGTH OF UNDER LIGHT TO FIT AVAILABLE CABINET SPACE
- SMOKE DETECTORS AND COMBO SMOKE/CO SHALL BE HARDWIRED AND INTERCONNECTED IF MORE THAN ONE PER UNIT.
- FIRE SMOKE DAMPER(S) FIELD COORDINATE WITH ARCH, MECH AND FIRE ALARM WORK. SEE ARCH, MECH AND FIRE ALARM DWGS.
- UNIT 201 - PNL 'R201'
UNIT 202 - PNL 'R202'
UNIT 203 - PNL 'R203'
UNIT 204 - PNL 'R204'
UNIT 207 - PNL 'R207'
UNIT 208 - PNL 'R208'

SHEET LEGEND

- 1 - 3/4" NMT WITH 1 - CAT 6 DATA CABLE AND 1-RG11 COAX CABLE TO APT TELCO/CATV ENCLOSURE 'IT-XXX'
-2-PORT QUICKPORT WALLPLATE, PART # 41080-2WP
-QUICKPORT F-CONNECTOR COUPLER, PART # 41084-FWF
-HOME SE QUICKPORT JACK, PART # SEHOM-RWS
- PANEL IT-XXX; LEVITON
-14" WIRELESS ENCLOSURE WITH VENTED COVER, PART # 49605-140
-COMBO PANEL WITH 1X4 PHONE, DATA AND 1X6 VIDEO PANEL, PART # 47603-DP6
-NON-SURGE J-BOX KIT, PART # 47605-ACN
-UNIVERSAL SHELF BRACKET, PART # 49605-AUB
-SADDLE TIE KIT, PART # 49605-AST

1

6

PANEL NAME: LOCATION: RESIDENTIAL UNIT

VOLTAGE: 120/208 BUS RATING: 125 1 PHASE 3 WIRE + GND.

SHORT CIR RATING: 10 KAIC BUS TYPE: COPPER ALUMINUM

O.C. DEVICES: BOLT-ON PLUG-ON DEVICE FAMILY:

PANEL TYPE: PANEL BOARD LOAD CENTER

ENCLOSURE TYPE: NEMA 1 MOUNTING: SURFACE FLUSH

INTERIOR: MAIN LUGS MAIN CIRCUIT BREAKER

SUB-FEED CIRCUIT BREAKER



DESCRIPTION	TO	FROM	VOLT	AMPS	BRK.	CKT NO.	BUS	CONN.	CT	NO.	BRK.	VOLT	AMPS	BRK.	CT	NO.	DESCRIPTION
MAIN	X	X				100	1			2	20	1000		X		2	GARBAGE DISP
MAIN	X	X				-	3			4	20		1500	X		4	KIT APPLIANCE
OVEN COOKTOP		X	4000			50	5			6	20	1500		X		6	KIT APPLIANCE
OVEN COOKTOP		X		4000		-	7			8	20		600	X		8	REFER
BATH GFI		X	1500			20	9			10	20	1440		X		10	PLUGS
HEATER		X		2000		30	11			12	20		400	X		12	LIGHTS
LOW VOLTAGE CABNET		X	200			20	13			14	20	210		X		14	ERV & FSD
SPACE							15			16						16	SPACE
SPACE							17			18						18	SPACE
SPACE							19			20						20	SPACE
SPACE							21			22						22	SPACE
SPACE							23			24						24	SPACE
							25			26						26	
							27			28						28	
							29			30						30	
							271			272						272	
							273			274							

1 - 3/4" NMT WITH 1 - CAT 6 DATA CABLE AND 1-RS11 COAX CABLE TO APT TELCO/CATV ENCLOSURE 1T-XXX"
 2-PORT QUICKPORT WALLPLATE, PART # 4T850-D30
 -QUICKPORT F-CONNECTOR COUPLER, PART # 41084-FWF
 -HOME SE QUICKPORT JACK, PART # 5E0HM-RWS
 PANEL ITX-XXX; LEVITON
 -14" WIRELESS ENCLOSURE WITH VENTER COVER, PART # 49605-140
 -COMBO PANEL WITH 1X4 PHONE, DATA AND 1X6 VIDEO PANEL, PART # 47603-DP6
 -NON-SURGE J-BOX KIT, PART # 47605-ACN
 -UNIVERSAL SHEET BRACKET, PART # 49605-AUB
 -SADDLE THE KIT, PART # 49605-AST

1. ALL RECEPTACLES IN THE BEDROOM, THE DINING ROOM, HALLWAY, DEN, LIBRARIES, CLOSET, THE FAMILY ROOM AND SIMILAR ROOMS SHALL BE ARC-FAULT CIRCUIT INTERRUPTER PER CEC ARTICLE 210.12.
2. ALL RECEPTACLES IN UNITS SHALL BE TAMPER-RESISTANT RECEPTACLES PER CEC ARTICLE 406.14.
3. ALL BUILDING EXTERIOR WEATHER PROOF RECEPTACLE COVERS SHALL BE IN-USE TYPE.

1. TITLE 24 COMPLIANT VACANCY SWITCH FOR BATH LIGHTS AND ERV CONTROL SWITCH, SUPPLIED BY MECHANICAL AND INSTALLED BY ELECTRICAL.
2. FC-1 LINE VOLTAGE T-SWITCH SUPPLIED BY MECHANICAL AND INSTALLED BY ELECTRICAL. FIELD COORDINATE WITH MECHANICAL WORK. COORDINATE IN FIELD EXACT LOCATION OF T-SWITCH WITH ARCHITECT.
3. USE MAX LENGTH OF UNDER LIGHT TO FIT AVAILABLE CABINET SPACE.
4. SMOKE DETECTORS AND COMBO SMOKE/CO SHALL BE HARDWIRED AND INTERCONNECTED IF MORE THAN ONE PER UNIT.
5. FIRE SMOKE DAMPER(S) FIELD COORDINATE WITH ARCH, MECH AND FIRE ALARM WORK. SEE ARCH, MECH AND FIRE ALARM DWGS.

PANEL NAME: "R209"				LOCATION: RESIDENTIAL UNIT				PANEL TYPE: <input type="checkbox"/> PANEL BOARD <input checked="" type="checkbox"/> LOAD CENTER							
VOLTAGE: 120/208 BUS RATING: 125 1 PHASE 3 WIRE + GND.				ENCLOSURE TYPE: NEMA 1 MOUNTING: <input type="checkbox"/> SURFACE <input checked="" type="checkbox"/> FLUSH											
SHORT CIR RATING: 10 KAIC BUS TYPE: <input checked="" type="checkbox"/> COPPER <input type="checkbox"/> ALUMINUM				INTERIOR: <input type="checkbox"/> MAIN LUGS <input checked="" type="checkbox"/> MAIN CIRCUIT BREAKER											
O.C. DEVICES: <input type="checkbox"/> BOLT-ON <input checked="" type="checkbox"/> PLUG-ON				DEVICE FAMILY: <input type="checkbox"/> SUB-FEED CIRCUIT BREAKER											
DESCRIPTION		LG	NG	VOLT ΦA	AMPS ΦB	BRK.	CKT NO.	BUS CONN. A B	CKT NO.	BRK.	VOLT ΦA	AMPS ΦB	BRK.	LG	DESCRIPTION
MAIN		X	X			100	1	●	2	20	1000		X		GARBAGE DISP
MAIN		X	X			—	3	●	4	20		1500	X		KIT APPLIANCE
OVEN COOKTOP		X		4000		50	5	●	6	20	1500		X		KIT APPLIANCE
OVEN COOKTOP		X			4000	—	7	●	8	20		600	X		REFER
BATH GFI		X		1500		20	9	●	10	20	1440		X		PLUGS
HEATER		X			2000	30	11	●	12	20		400	X		LIGHTS
LOW VOLTAGE CABINET		X		200		20	13	●	14	20	210		X		ERV & FSD
SPACE							15	●	16						SPACE
SPACE							17	●	18						SPACE
SPACE							19	●	20						SPACE
SPACE							21	●	22						SPACE
SPACE							23	●	24						SPACE
							25	●	26						
							27	●	28						
							29	●	30						
							31	●	32						
							33	●	34						
							35	●	36						
							37	●	38						
							39	●	40						
TOTALS				5700 6000								4150 2500			
BUS A 9.9 KVA		ACCESSORIES:		COLOR		COVER		NAME PLATES		OTHER					
BUS B 8.5 KVA		EITHER		<input checked="" type="checkbox"/> ANSI 61 LT GRAY <input type="checkbox"/> ANSI 49 DK GRAY		<input type="checkbox"/> DOOR-IN-DOOR <input type="checkbox"/> KEYED LATCH <input type="checkbox"/> OTHER:		<input checked="" type="checkbox"/> 1/4" LETTERS <input checked="" type="checkbox"/> WHITE LETTERS ON BLACK <input checked="" type="checkbox"/> SCREW MOUNTED		<input type="checkbox"/> GROUND BAR <input type="checkbox"/> PNL DIRECTORY <input type="checkbox"/> ISO GROUND BAR					
TOTAL 18.4 KVA															

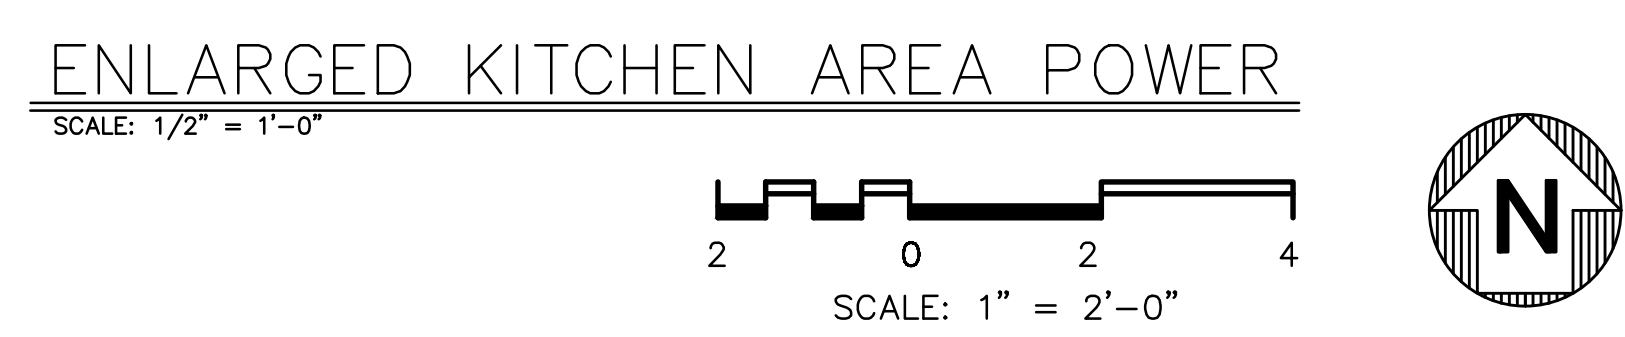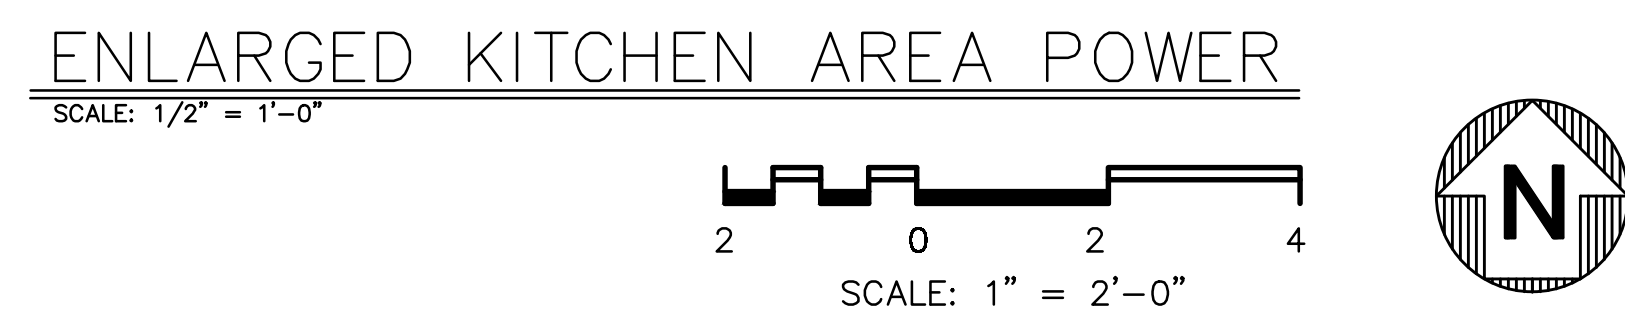


LIGHTING & POWER PLANS - UNITS 206, 209

PROPRIETARY DATA

THE USE OF THE PLANS AND SPECIFICATIONS IS LIMITED TO THE PROJECT AND SITE FOR WHICH THEY WERE PREPARED. NO REUSE OR PUBLIC RELEASE IS EXPRESSLY LIMITED TO SUCH USE. REUSE, REPRODUCTION OR PUBLICATION BY ANY METHOD IN WHOLE OR IN PART IS PROHIBITED. TITLE TO THE PLANS AND SPECIFICATIONS REMAINS WITH CENTRAL PACIFIC ENGINEERING, INC. NO PART OF THE PLANS OR SPECIFICATIONS SHALL BE IN CONTACT WITH THEM CONSTITUTES PRIMA FACIE EVIDENCE OF THE ACCEPTANCE OF THESE RESTRICTION.



CENTRAL PACIFIC ENGINEERING, INC.
COPY RIGHT 2006

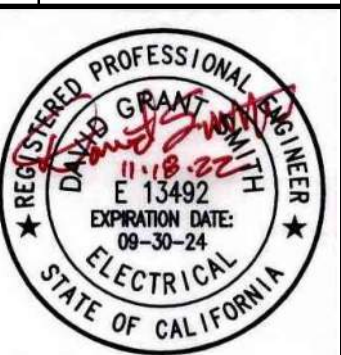


Central Pacific Engineering, Inc.
Professional Engineers
9035 Soquel Avenue, Suite 205
Santa Cruz, CA 95062
831-476-1525
CPE JOB 21-044-0

REV.	DESCRIPTION	DATE
1	ISSUED FOR PLAN CHECK	08/27/22
1	PLAN CHECK & OWNER COMMENTS	10/14/22
2		
3		
4		
5		

SH	18	REV.	1
OF			
32			
21-044-0			
E4.21			
JOB NO.			
LOCATION: 415 NATURAL BRIDGES DRIVE SANTA CRUZ, CALIFORNIA			
OWNER: THE HOUSING AUTHORITY OF THE COUNTY OF SANTA CRUZ			
DR.	DATE	CHK.	APPD.
SAK	04/20/02	DGS	DGS
		SCALE	
		AS NOTED	

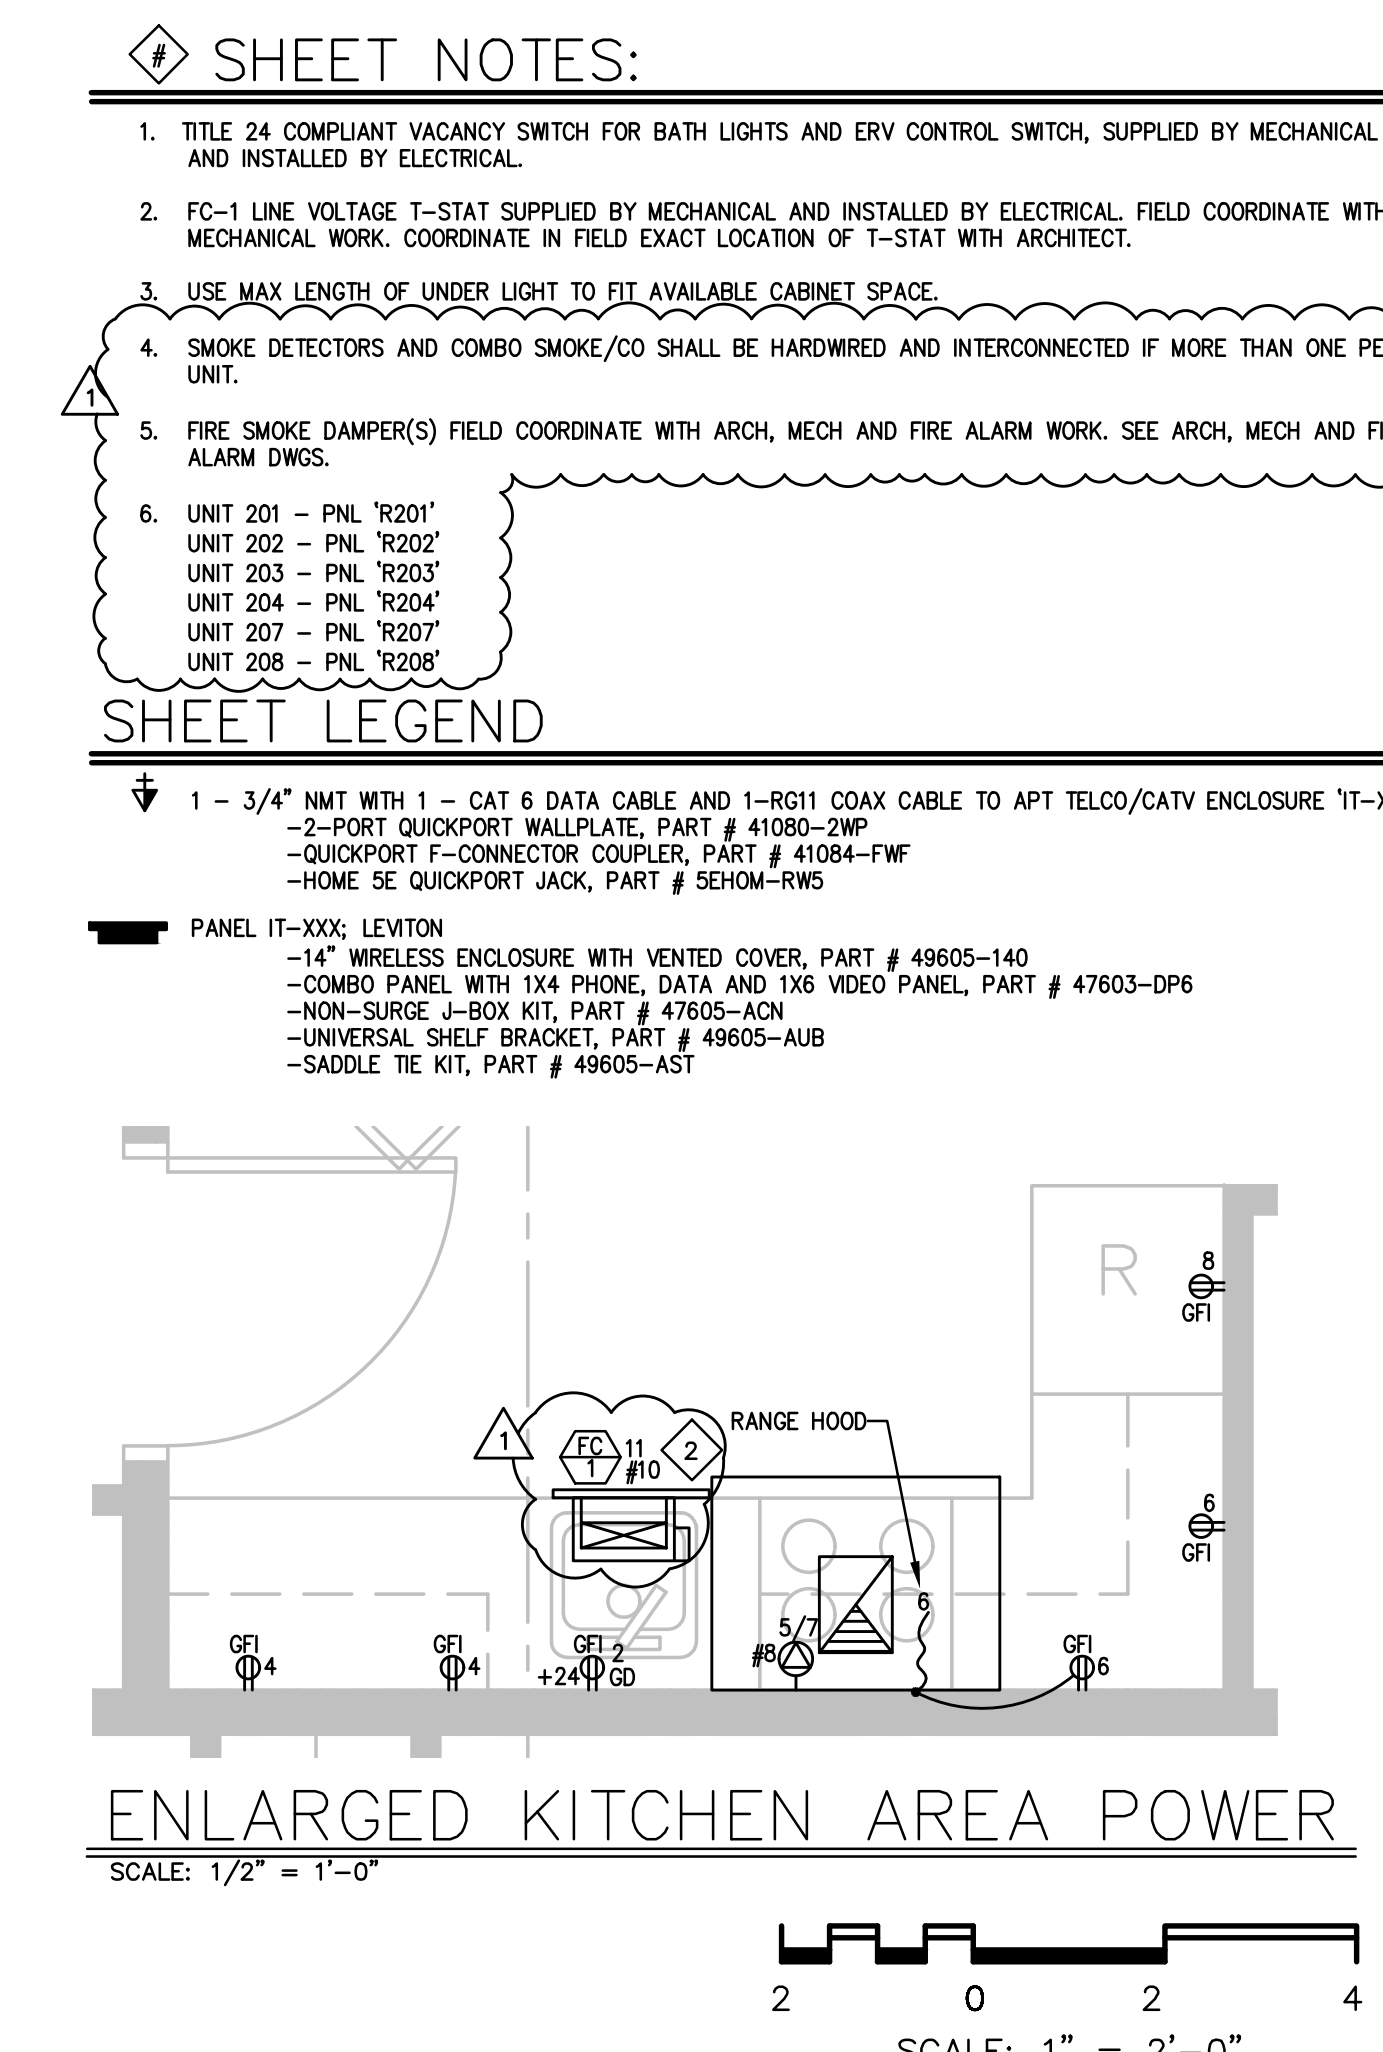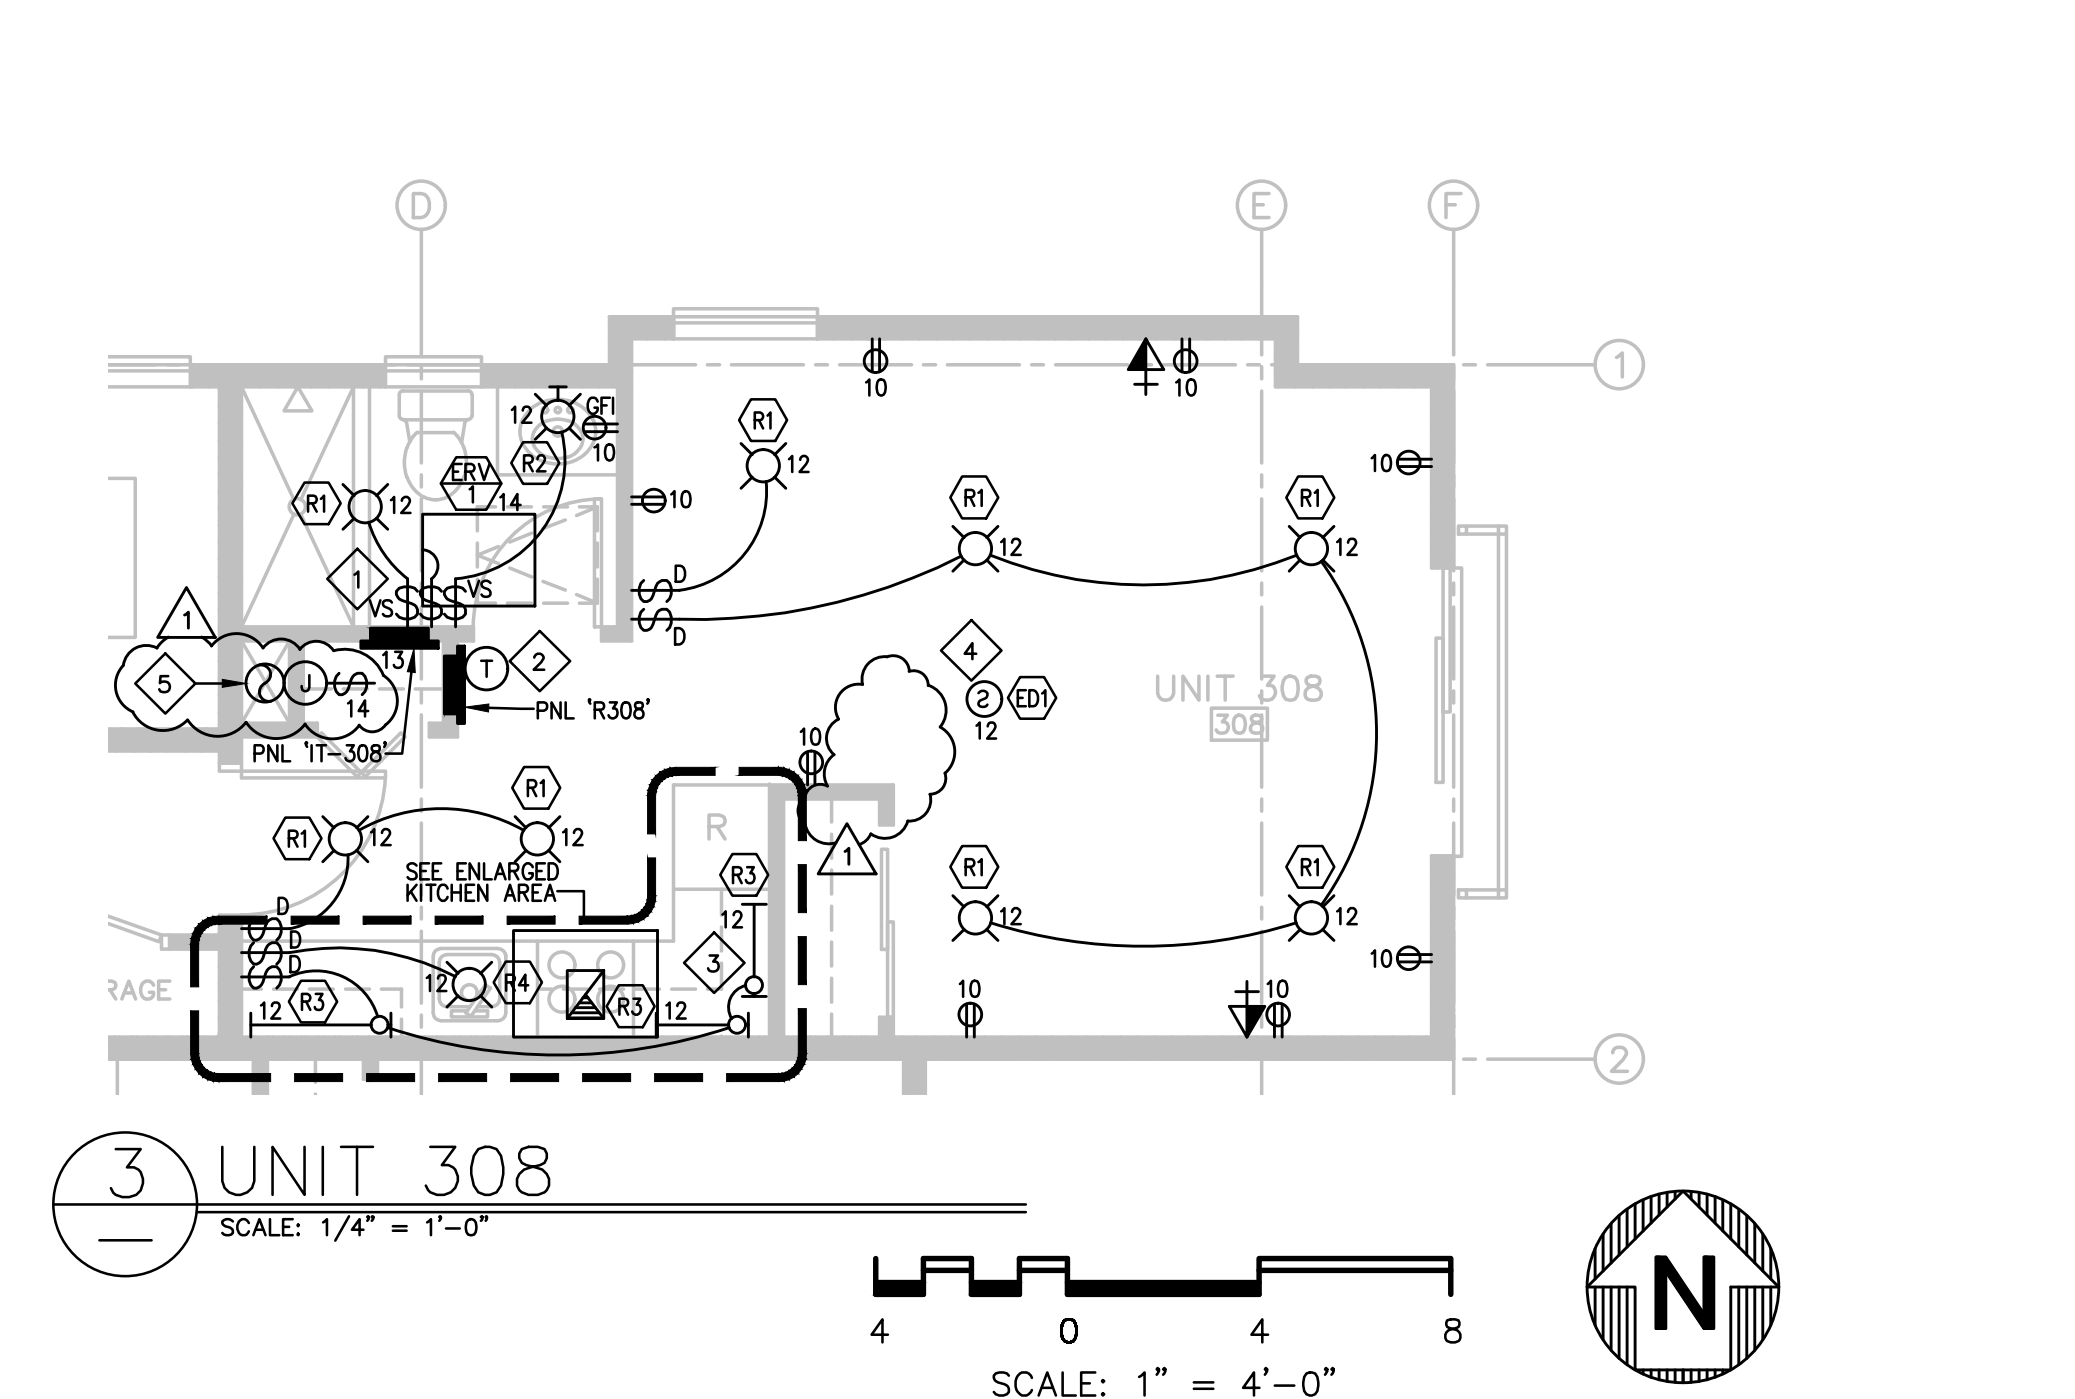

LIGHTING & POWER PLANS - UNITS 301, 302, 303, 304, 305, 306, 307, 308

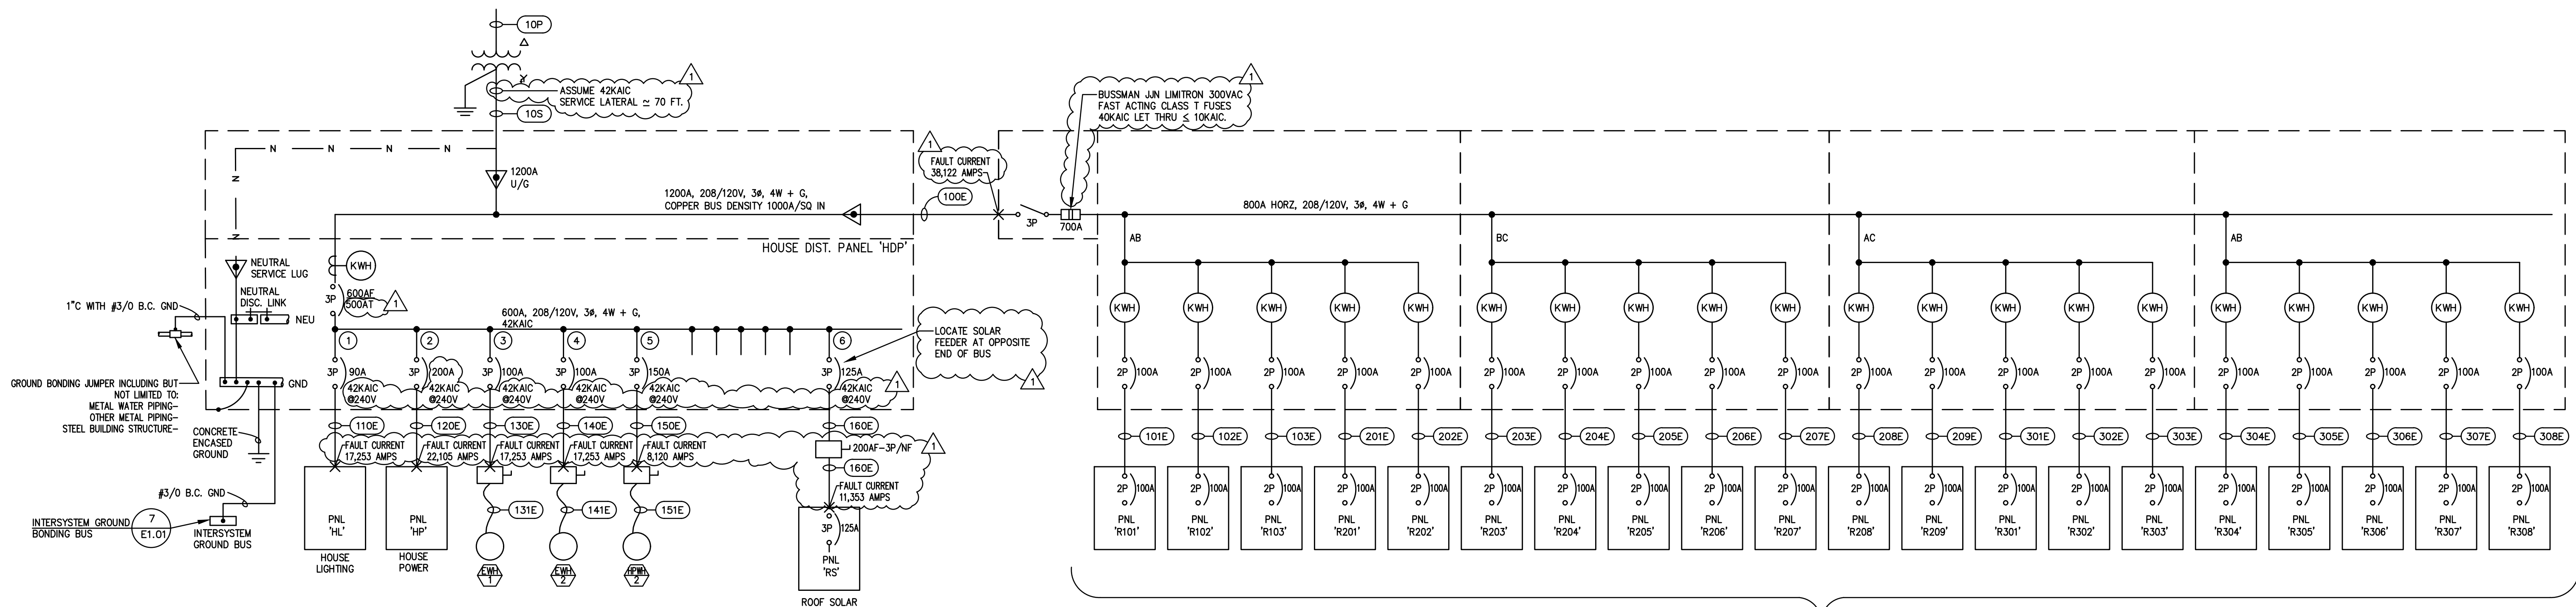

1 ONE-LINE DIAGRAM
NO SCALE

SEE INDIVIDUAL APT PLANS
FOR PANEL SCHEDULES

FEEDER SCHEDULE						
(MARK)	WIRE		CONDUIT		ESTIMATED FEEDER SEGMENT VOLTAGE DROP (V)	FEEDER SEGMENT VOLTAGE DROP (%)
	SIZE	TYPE	SIZE	TYPE		
10P	BY PG&E	BY PG&E	1-4"	PVCSCH40	-	-
10S	BY PG&E	BY PG&E	4-5"	PVCSCH40	-	-
10T	BY AT&T	BY AT&T	1-3"	PVCSCH40	-	-
10CA	BY COMCAST	BY COMCAST	1-3"	PVCSCH40	-	-
10GE	2-(4-#600MCM CU + 1-#3/0CU GND)	THHN/THWN	2-4"	RGS/GUTTER	15	0.13
110E	4-#2CU + 1-#6 CU GND	THHN/THWN	1-2"	EMT/PVCSCH40	30	0.16
120E	4-#3/0CU + 1-#6 CU GND	THHN/THWN	1-3"	EMT/PVCSCH40	30	0.80
130E	3-#2CU + 1-#6 CU GND	THHN/THWN	1-1.5"	EMT/PVCSCH40	30	0.73
131E	3-#2CU + 1-#6 CU GND	THHN/THWN	1-1.5"	WP FLEX	10	0.25
140E	3-#2CU + 1-#6 CU GND	THHN/THWN	1-1.5"	EMT/PVCSCH40	30	0.73
141E	3-#2CU + 1-#6 CU GND	THHN/THWN	1-1.5"	WP FLEX	10	0.25
150E	3-#1/0CU + 1-#6 CU GND	THHN/THWN	1-2"	EMT/PVCSCH40	75	1.74
151E	3-#1/0CU + 1-#6 CU GND	THHN/THWN	1-1.5"	WP FLEX	10	0.30
160E	4-#1/0CU + 1-#6 CU GND	THHN/THWN	1-2"	EMT/PVCSCH40	75	1.24
101E	3-#2CU + #4 CU GND	THHN/THWN	-	SER	75	1.36
102E	3-#2CU + #4 CU GND	THHN/THWN	-	SER	60	1.09
103E	3-#2CU + #4 CU GND	THHN/THWN	-	SER	65	1.18
201E	3-#2CU + #4 CU GND	THHN/THWN	-	SER	50	0.91
202E	3-#2CU + #4 CU GND	THHN/THWN	-	SER	65	1.18
203E	3-#2CU + #4 CU GND	THHN/THWN	-	SER	85	1.54
204E	3-#2CU + #4 CU GND	THHN/THWN	-	SER	105	1.90
205E	3-#2CU + #4 CU GND	THHN/THWN	-	SER	115	2.08
206E	3-#2CU + #4 CU GND	THHN/THWN	-	SER	125	2.27
207E	3-#2CU + #4 CU GND	THHN/THWN	-	SER	95	1.72
208E	3-#2CU + #4 CU GND	THHN/THWN	-	SER	75	1.36
209E	3-#2CU + #4 CU GND	THHN/THWN	-	SER	80	1.45
301E	3-#2CU + #4 CU GND	THHN/THWN	-	SER	65	1.18
302E	3-#2CU + #4 CU GND	THHN/THWN	-	SER	100	1.81
303E	3-#2CU + #4 CU GND	THHN/THWN	-	SER	115	2.08
304E	3-#2CU + #4 CU GND	THHN/THWN	-	SER	135	2.45
305E	3-#2CU + #4 CU GND	THHN/THWN	-	SER	145	2.63
306E	3-#2CU + #4 CU GND	THHN/THWN	-	SER	120	2.17
307E	3-#2CU + #4 CU GND	THHN/THWN	-	SER	105	1.90
308E	3-#2CU + #4 CU GND	THHN/THWN	-	SER	105	1.90

PANEL NAME: RS				LOCATION: ROOF SOLAR				PANEL TYPE: <input checked="" type="checkbox"/> PANEL BOARD <input type="checkbox"/> LOAD CENTER							
VOLTAGE: 208/120				BUS RATING: 200				ENCLOSURE TYPE: NEMA 3R				MOUNTING: <input checked="" type="checkbox"/> SURFACE <input type="checkbox"/> FLUSH			
SHORT CIR RATING: 25 KAIC				BUS TYPE: <input checked="" type="checkbox"/> COPPER <input type="checkbox"/> ALUMINUM				INTERIOR: <input type="checkbox"/> MAIN LUGS <input checked="" type="checkbox"/> MAIN CIRCUIT BREAKER - SEE ONE LINE				<input type="checkbox"/> SUB-FEED CIRCUIT BREAKER - SEE ONE LINE			
O.C. DEVICES: <input checked="" type="checkbox"/> BOLT-ON <input type="checkbox"/> PLUG-ON				DEVICE FAMILY:											
DESCRIPTION		W	V	VOLT • AMPS		BRK.	CKT NO.	BUS CONN.		CKT NO.	BRK.	VOLT • AMPS		W	DESCRIPTION
		12	12	0A	0B	0C		A	B	C		12	12	0A	
SOLAR PANEL CKT		X		1275		20	1	•			2	20	1488	X	SOLAR PANEL CKT
SOLAR PANEL CKT		X			1275		3	•			4	-		1488	X
SOLAR PANEL CKT		X				1063	5	•			6	20		1275	X
SOLAR PANEL CKT		X		1063			7	•			8	-	1275		X
SOLAR PANEL CKT		X			1275		9	•			10	20		1488	X
SOLAR PANEL CKT		X				1275	11	•			12	-		1488	X
SOLAR PANEL CKT		X		1063		20	13	•			14	20	1275		X
SOLAR PANEL CKT		X			1063		15	•			16	-		1275	X
SOLAR PANEL CKT		X				1275	17	•			18	20		1275	X
SOLAR PANEL CKT		X		1275			19	•			20	-	1275		X
SPACE							21	•			22				SPACE
SPACE							23	•			24				SPACE
SPACE							25	•			26				SPACE
SPACE							27	•			28				SPACE
SPACE							29	•			30				SPACE
SPACE							31	•			32				SPACE
SPACE							33	•			34				SPACE
SPACE							35	•			36				SPACE
SPACE							37	•			38				SPACE
SPACE							39	•			40				SPACE
SPACE							41	•			42				SPACE
TOTALS				4676	3613	3613						5313	4251	4038	
BUS A		10.0 KVA		ACCESSORIES:		COLOR		COVER		NAME PLATES		OTHER			
BUS B		7.9 KVA		EITHER		<input checked="" type="checkbox"/> ANSI 61 LT GRAY		<input checked="" type="checkbox"/> DOOR-IN-DOOR		<input checked="" type="checkbox"/> 1/4" LETTERS		<input checked="" type="checkbox"/> GROUND BAR			
BUS C		7.7 KVA				<input checked="" type="checkbox"/> ANSI 49 DK GRAY		<input type="checkbox"/> KEYS LATCH		<input checked="" type="checkbox"/> WHITE LETTERS ON BLACK		<input type="checkbox"/> PNL DIRECTORY			
TOTAL		25.6 KVA				OTHER:		<input type="checkbox"/> OTHER:		<input checked="" type="checkbox"/> SCREW MOUNTED		<input type="checkbox"/> ISO GROUND BAR			

PANEL NAME: HL		LOCATION: ELECT. ROOM		PANEL TYPE: <input checked="" type="checkbox"/> PANEL BOARD <input type="checkbox"/> LOAD CENTER						
VOLTAGE: 208/120		BUS RATING: 100		ENCLOSURE TYPE: NEMA 1						
SHORT CIR RATING: (25 KAIC)		BUS TYPE: <input checked="" type="checkbox"/> COPPER <input type="checkbox"/> ALUMINUM		MOUNTING: <input checked="" type="checkbox"/> SURFACE <input type="checkbox"/> FLUSH						
O.C. DEVICES: <input checked="" type="checkbox"/> BOLT-ON <input type="checkbox"/> PLUG-ON		DEVICE FAMILY:		INTERIOR: <input type="checkbox"/> MAIN LUGS <input type="checkbox"/> MAIN CIRCUIT BREAKER - SEE ONE LINE						
				<input type="checkbox"/> SUB-FEED CIRCUIT BREAKER - SEE ONE LINE						
DESCRIPTION	WIRE	VOLT • AMPS	BRK.	CKT NO.	BUS CONN.	CKT NO.	BRK.	VOLT • AMPS	DESCRIPTION	
PARKING LOT POLE LTS	X	160		20	1	2	20	405	X HALLWAY LAUNDRY	
EXT BLDG SCONCE LTS	X			20	3	4	20	540	X 2ND 3RD FLOOR HALLWAY LIGHTING	
BOLLARD LTS	X			20	5	6	20		X STAIRWELLS	
SPACE				20	7	8	20	370	X STORAGE / TRASH	
SPACE				20	9	10	20		X (TOILET X COMMON RM	
SPACE				20	11	12	20		SPACE	
SPACE				20	13	14	20	0	SPACE	
SPACE				20	15	16	20	0	SPACE	
SPACE				20	17	18	20		SPACE	
SPACE				20	19	20			SPACE	
SPACE				20	21	22			SPACE	
SPACE				20	23	24			SPACE	
SPACE				20	25	26			SPACE	
SPACE				20	27	28			SPACE	
SPACE				20	29	30			SPACE	
SPACE				20	31	32			SPACE	
SPACE				20	33	34			SPACE	
SPACE				20	35	36			SPACE	
SPACE				20	37	38			SPACE	
SPACE				20	39	40			SPACE	
SPACE				20	41	42			SPACE	
TOTALS		160	270	150				775	835	475
BUS A	1.0 KVA	ACCESSORIES: COLOR		COVER		NAME PLATES		OTHER		
BUS B	1.2 KVA	EITHER: <input checked="" type="checkbox"/> ANSI 61 LT GRAY <input type="checkbox"/> ANSI 49 DK GRAY		<input checked="" type="checkbox"/> DOOR-IN-DOOR <input type="checkbox"/> KEYS LATCH		<input checked="" type="checkbox"/> 1/4" LETTERS <input type="checkbox"/> WHITE LETTERS ON BLACK		<input checked="" type="checkbox"/> GROUND BAR <input type="checkbox"/> PNL DIRECTORY		
BUS C	0.7 KVA							<input type="checkbox"/> ISO GROUND BAR		
TOTAL	2.9 KVA									

PANEL NAME: HP		LOCATION: ELECT. ROOM		PANEL TYPE: <input checked="" type="checkbox"/> PANEL BOARD <input type="checkbox"/> LOAD CENTER						
VOLTAGE: 208/120		BUS RATING: 200		ENCLOSURE TYPE: NEMA 1						
SHORT CIR RATING: (25 KAIC)		BUS TYPE: <input checked="" type="checkbox"/> COPPER <input type="checkbox"/> ALUMINUM		MOUNTING: <input checked="" type="checkbox"/> SURFACE <input type="checkbox"/> FLUSH						
O.C. DEVICES: <input checked="" type="checkbox"/> BOLT-ON <input type="checkbox"/> PLUG-ON		DEVICE FAMILY:		INTERIOR: <input checked="" type="checkbox"/> MAIN LUGS <input type="checkbox"/> MAIN CIRCUIT BREAKER - SEE ONE LINE						
				<input type="checkbox"/> SUB-FEED CIRCUIT BREAKER - SEE ONE LINE						
DESCRIPTION	WIRE	VOLT • AMPS	BRK.	CKT NO.	BUS CONN.	CKT NO.	BRK.	VOLT • AMPS	DESCRIPTION	
SPARE	X	0		20	1	2	30	2500	X DRYER #1	
SPARE	X			20	3	4	-	2500	X DRYER #1	
CIRC PUMP: DHW-1A	X			20	5	6	30		X DRYER #2	
CIRC PUMP: DHW-1B	X	528		20	7	8	-	2500	X DRYER #2	
MAIN TELCO BACKBOARD	X	750		20	9	10	30	2500	X DRYER #3	
FACP	X			20	11	12	-	2500	X DRYER #3	
FS RISER BELL	X	250		20	13	14	20	1500	X WASHER #1	
ROOF SERVICE PLUGS	X	500		20	15	16	20	1500	X WASHER #2	
ELECT & MECH RM SERVICE PLUGS	X	500		20	17	18	20	1500	X WASHER #3	
COMMON ROOM HP-1	X	1746		30	19	20	20	1200	X LAUNDRY RM COUNTER PLUG	
COMMON ROOM HP-1	X	1746		-	21	22	20		X IT PANEL COMMON ROOM	
EF-2 & ERV 1ST FL, 2ND, 3RD CORR & OFFICE	X			20	23	24	20		X COMMON ROOM PLUGS	
LANDSCAPE CONTROLLER	X	250		20	25	26	20	1200	X COMMON ROOM COUNTER PLUGS	
SOLAR PUMP STATION: PS-1	X	240		20	27	28	20	900	X LOBBY & CORR. PLUGS	
SPACE		0		20	29	30	20	720	X 2nd FL CORR. PLUGS	
SPACE		0		20	31	32	20	720	X 3rd FL CORR. PLUGS	
SPACE		0		20	33	34	20	0	SPACE	
EV CHARGER #1		3328		40	35	36	20		SPACE	
EV CHARGER #1		3328		-	37	38			SPACE	
EV CHARGER #2		3328		40	39	40			SPACE	
EV CHARGER #2		3328		-	41	42			SPACE	
TOTALS		6102	6564	8862				9620	7600	8480
BUS A	15.8 KVA	ACCESSORIES: COLOR		COVER		NAME PLATES		OTHER		
BUS B	14.2 KVA	EITHER: <input checked="" type="checkbox"/> ANSI 61 LT GRAY <input type="checkbox"/> ANSI 49 DK GRAY		<input checked="" type="checkbox"/> DOOR-IN-DOOR <input type="checkbox"/> KEYS LATCH		<input checked="" type="checkbox"/> 1/4" LETTERS <input type="checkbox"/> WHITE LETTERS ON BLACK		<input checked="" type="checkbox"/> GROUND BAR <input type="checkbox"/> PNL DIRECTORY		
BUS C	17.4 KVA							<input type="checkbox"/> ISO GROUND BAR		
TOTAL	47.4 KVA									

ONE-LINE DIAGRAM

PROPRIETARY DATA

THE USE OF THE PLANS AND SPECIFICATIONS IS LIMITED TO THE PROJECT AND SITE FOR WHICH THEY WERE PREPARED, AND NO PART THEREOF IS TO BE REPRODUCED OR TRANSMITTED IN ANY FORM OR BY ANY MEANS, ELECTRONIC OR MECHANICAL, INCLUDING PHOTOCOPYING, RECORDING, OR BY ANY INFORMATION STORAGE AND RETRIEVAL SYSTEM, WITHOUT THE WRITTEN PERMISSION OF CENTRAL PACIFIC ENGINEERING, INC.

REGISTERED PROFESSIONAL ENGINEER
ELECTRICAL
STATE OF CALIFORNIA
EXPIRATION DATE: 08-30-24
E 15492

Central Pacific Engineering, Inc.
Professional Engineers
9035 Soquel Avenue, Suite 205
Santa Cruz, CA 95062
831-478-1525
CPE JOB 21-044-0

AFFORDABLE HOUSING PROJECT


LOCATION: 415 NATURAL BRIDGES DRIVE
SANTA CRUZ, CALIFORNIA
OWNER: THE HOUSING AUTHORITY OF THE COUNTY OF SANTA CRUZ


DR. DATE: 04/20/22
CHK. SAK
APPD. DGS
SCALE: AS NOTED

DATE: 08/27/22
ISSUED FOR PLAN CHECK
PLAN CHECK & OWNER COMMENTS

REV. DATE DESCRIPTION

JOB NO. 21-044-0
DWG. NO. E5.00
SH 20 OF 32
REV. 1

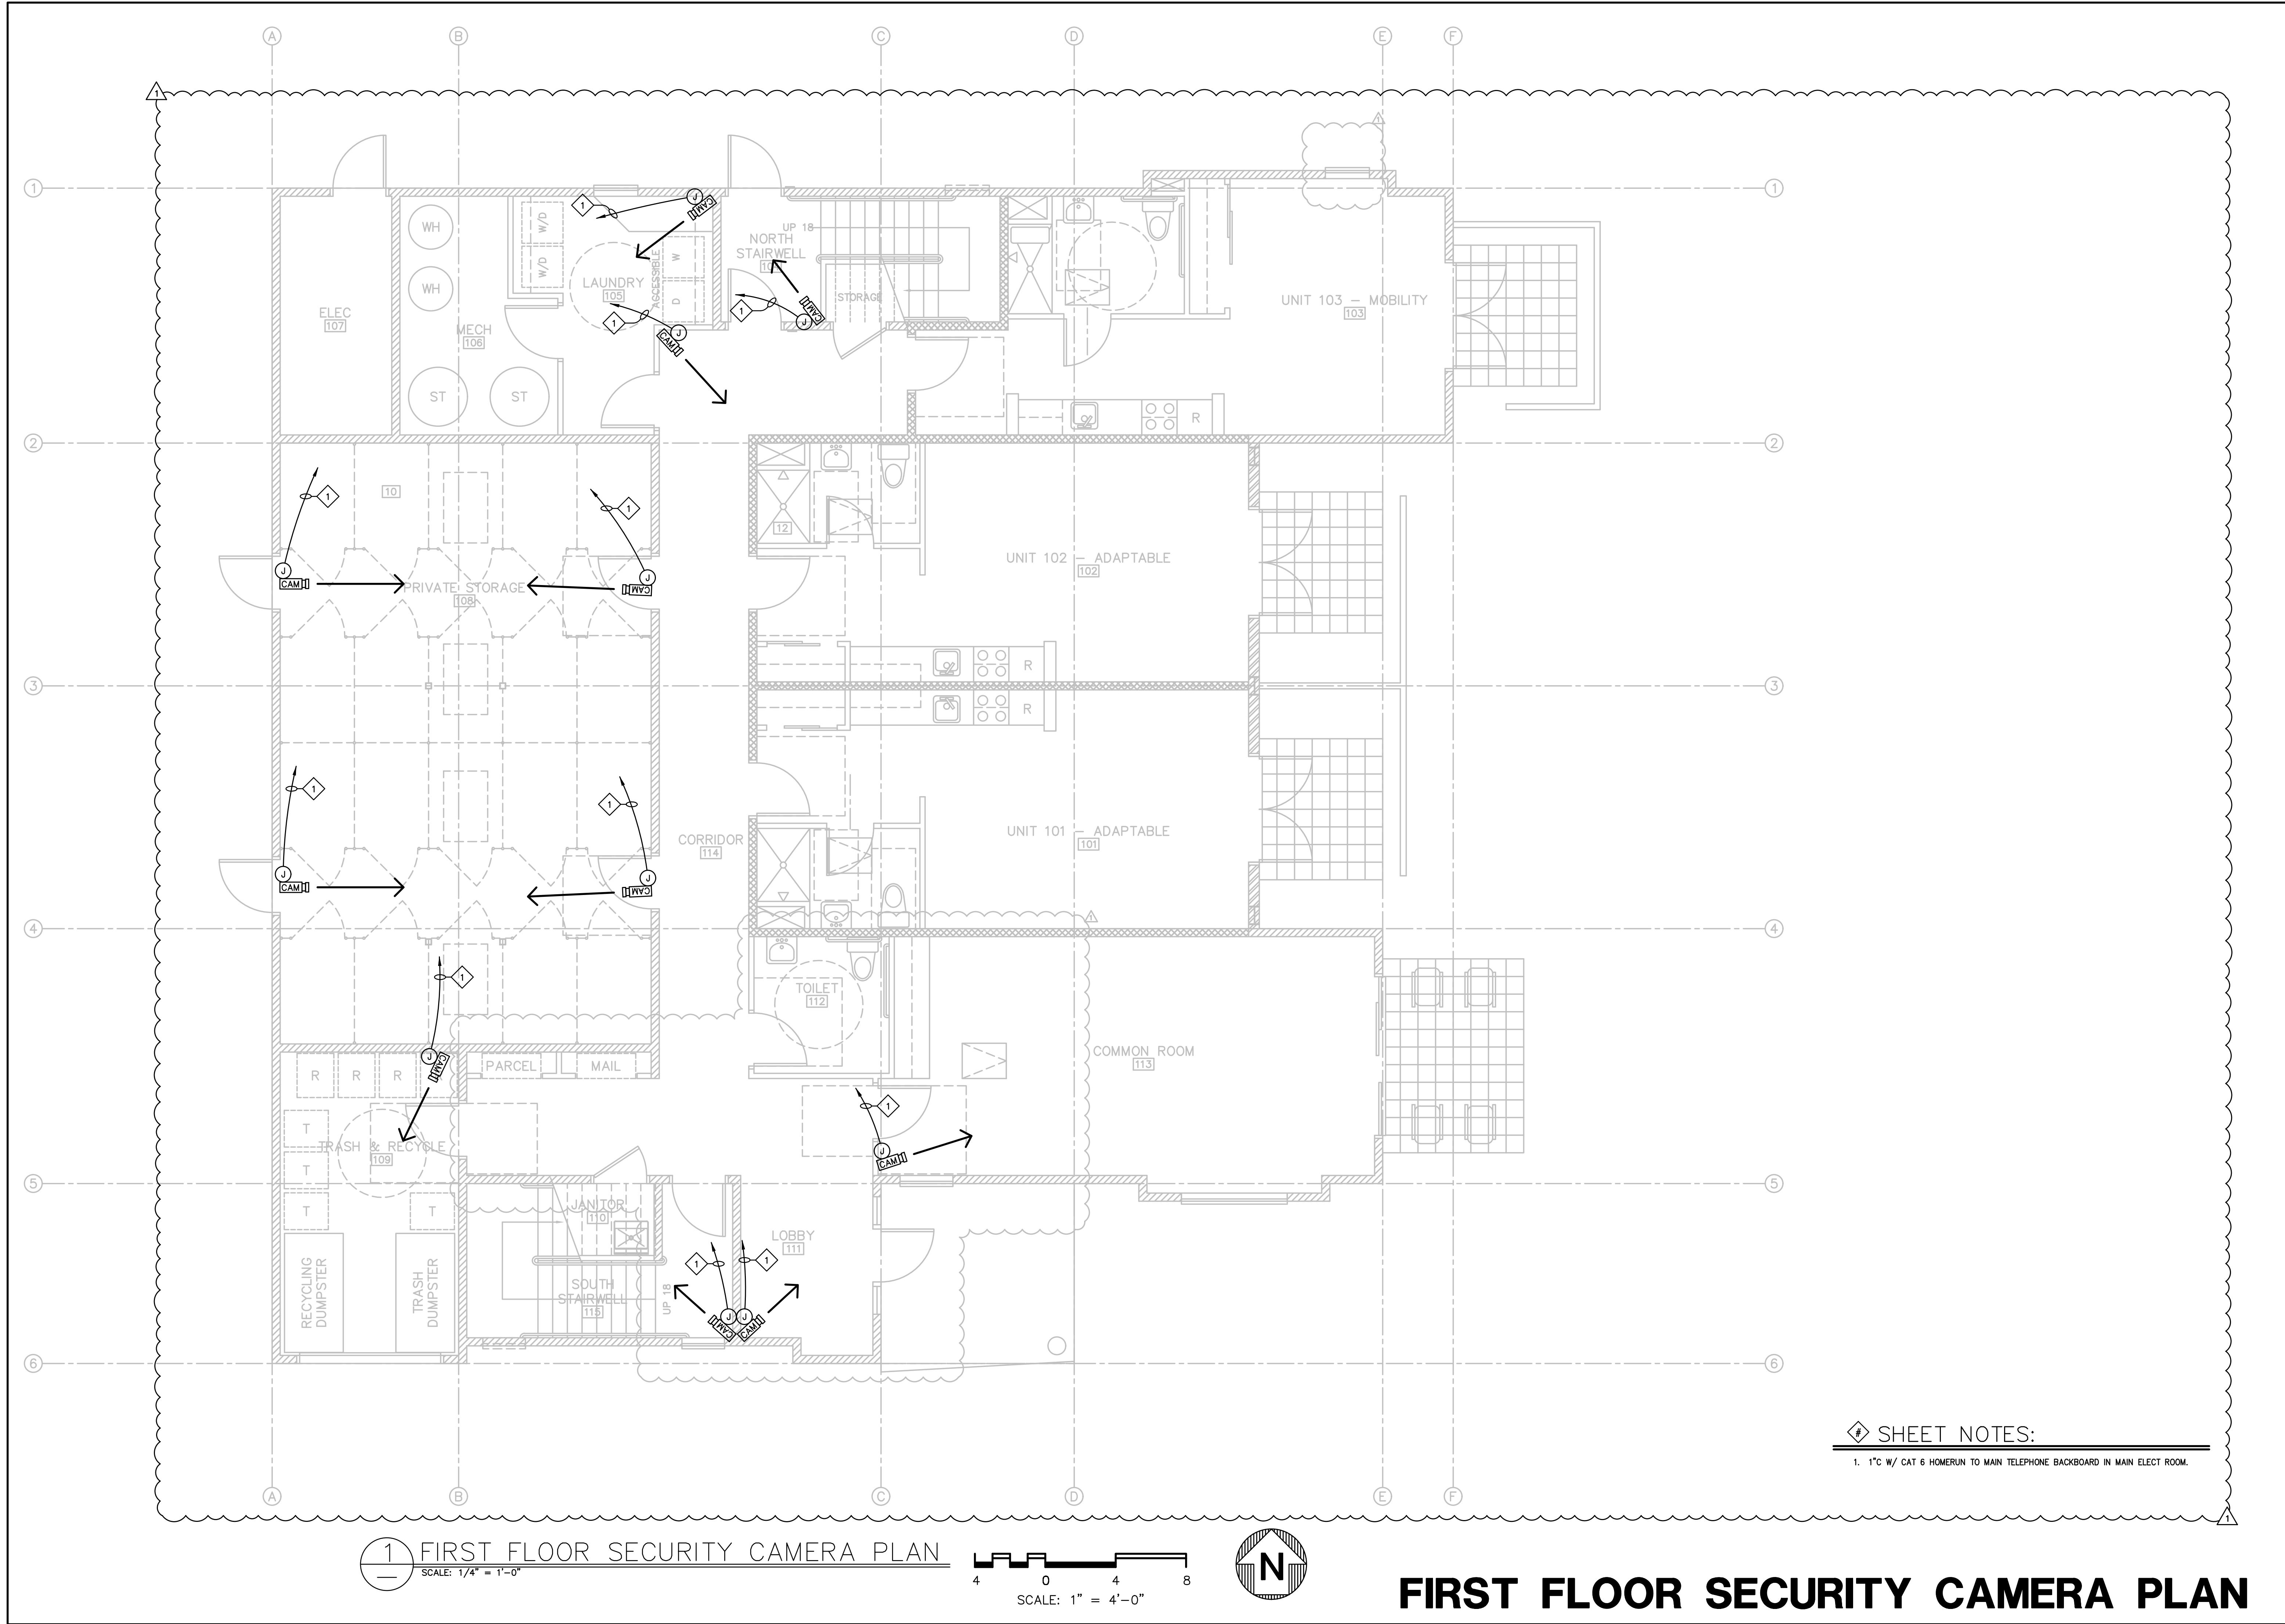


PROPRIETARY DATA THE USE OF THE PLANS AND SPECIFICATIONS IS LIMITED TO THE PROJECT AND SITE FOR WHICH THEY WERE PREPARED, AND PUBLICATION THEREOF IS PROHIBITED WITHOUT THE WRITTEN CONSENT OF THE ENGINEER. ANY REUSE OR MODIFICATION OF THE PLANS OR SPECIFICATIONS FOR ANY OTHER PROJECT WITHOUT THE WRITTEN CONSENT OF THE ENGINEER IS PROHIBITED. THE ENGINEER ASSUMES NO LIABILITY FOR THE ACCURACY OF THE PLANS OR SPECIFICATIONS, OR FOR THE RESULTS OF ANY CONSTRUCTION BASED THEREON. THE USER OF THE PLANS OR SPECIFICATIONS SHALL BE RESPONSIBLE FOR OBTAINING ALL NECESSARY PERMITS AND FOR COMPLYING WITH ALL APPLICABLE CODES AND REGULATIONS. THE ENGINEER'S LIABILITY IS LIMITED TO THE PROFESSIONAL ENGINEERING ACT. THE USER OF THE PLANS OR SPECIFICATIONS SHALL BE RESPONSIBLE FOR OBTAINING ALL NECESSARY PERMITS AND FOR COMPLYING WITH ALL APPLICABLE CODES AND REGULATIONS. THE ENGINEER'S LIABILITY IS LIMITED TO THE PROFESSIONAL ENGINEERING ACT.	
	
Central Pacific Engineering, Inc. Professional Engineers 9035 Soquel Avenue, Suite 205 Santa Cruz, CA 95062 831-478-1525 CPE JOB 21-044-0	
REV.	DESCRIPTION
1	ISSUED FOR PLAN CHECK
2	PLAN CHECK & OWNER COMMENTS
3	
4	
5	
6	
DATE	DATE
08/27/22	10/14/22
TITLE: AFFORDABLE HOUSING PROJECT	
LOCATION: 415 NATURAL BRIDGES DRIVE SANTA CRUZ, CALIFORNIA	
OWNER: THE HOUSING AUTHORITY OF THE COUNTY OF SANTA CRUZ	
DR.	CHK.
SAK	DGS
DATE	DATE
04/20/22	04/20/22
APPD.	APPD.
DGS	DGS
SCALE	SCALE
AS NOTED	AS NOTED
JOB NO.	JOB NO.
21-044-0	21-044-0
DWG. NO.	DWG. NO.
E6.10	E6.10
SH	REV.
22	1
OF	OF
32	1




4 0 4 8

SCALE: 1" = 4'-0"

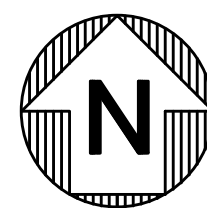

SECOND FLOOR SECURITY CAMERA PLAN

TITLE: AFFORDABLE HOUSING PROJECT		REV.		DESCRIPTION	DATE
JOB NO. 21-044-0		1		ISSUED FOR PLAN CHECK	08/27/22
DWG. NO. E6.20		2		PLAN CHECK & OWNER COMMENTS	10/14/22
SH 23		3			
OF 32		4			
		5			
		6			
		7			
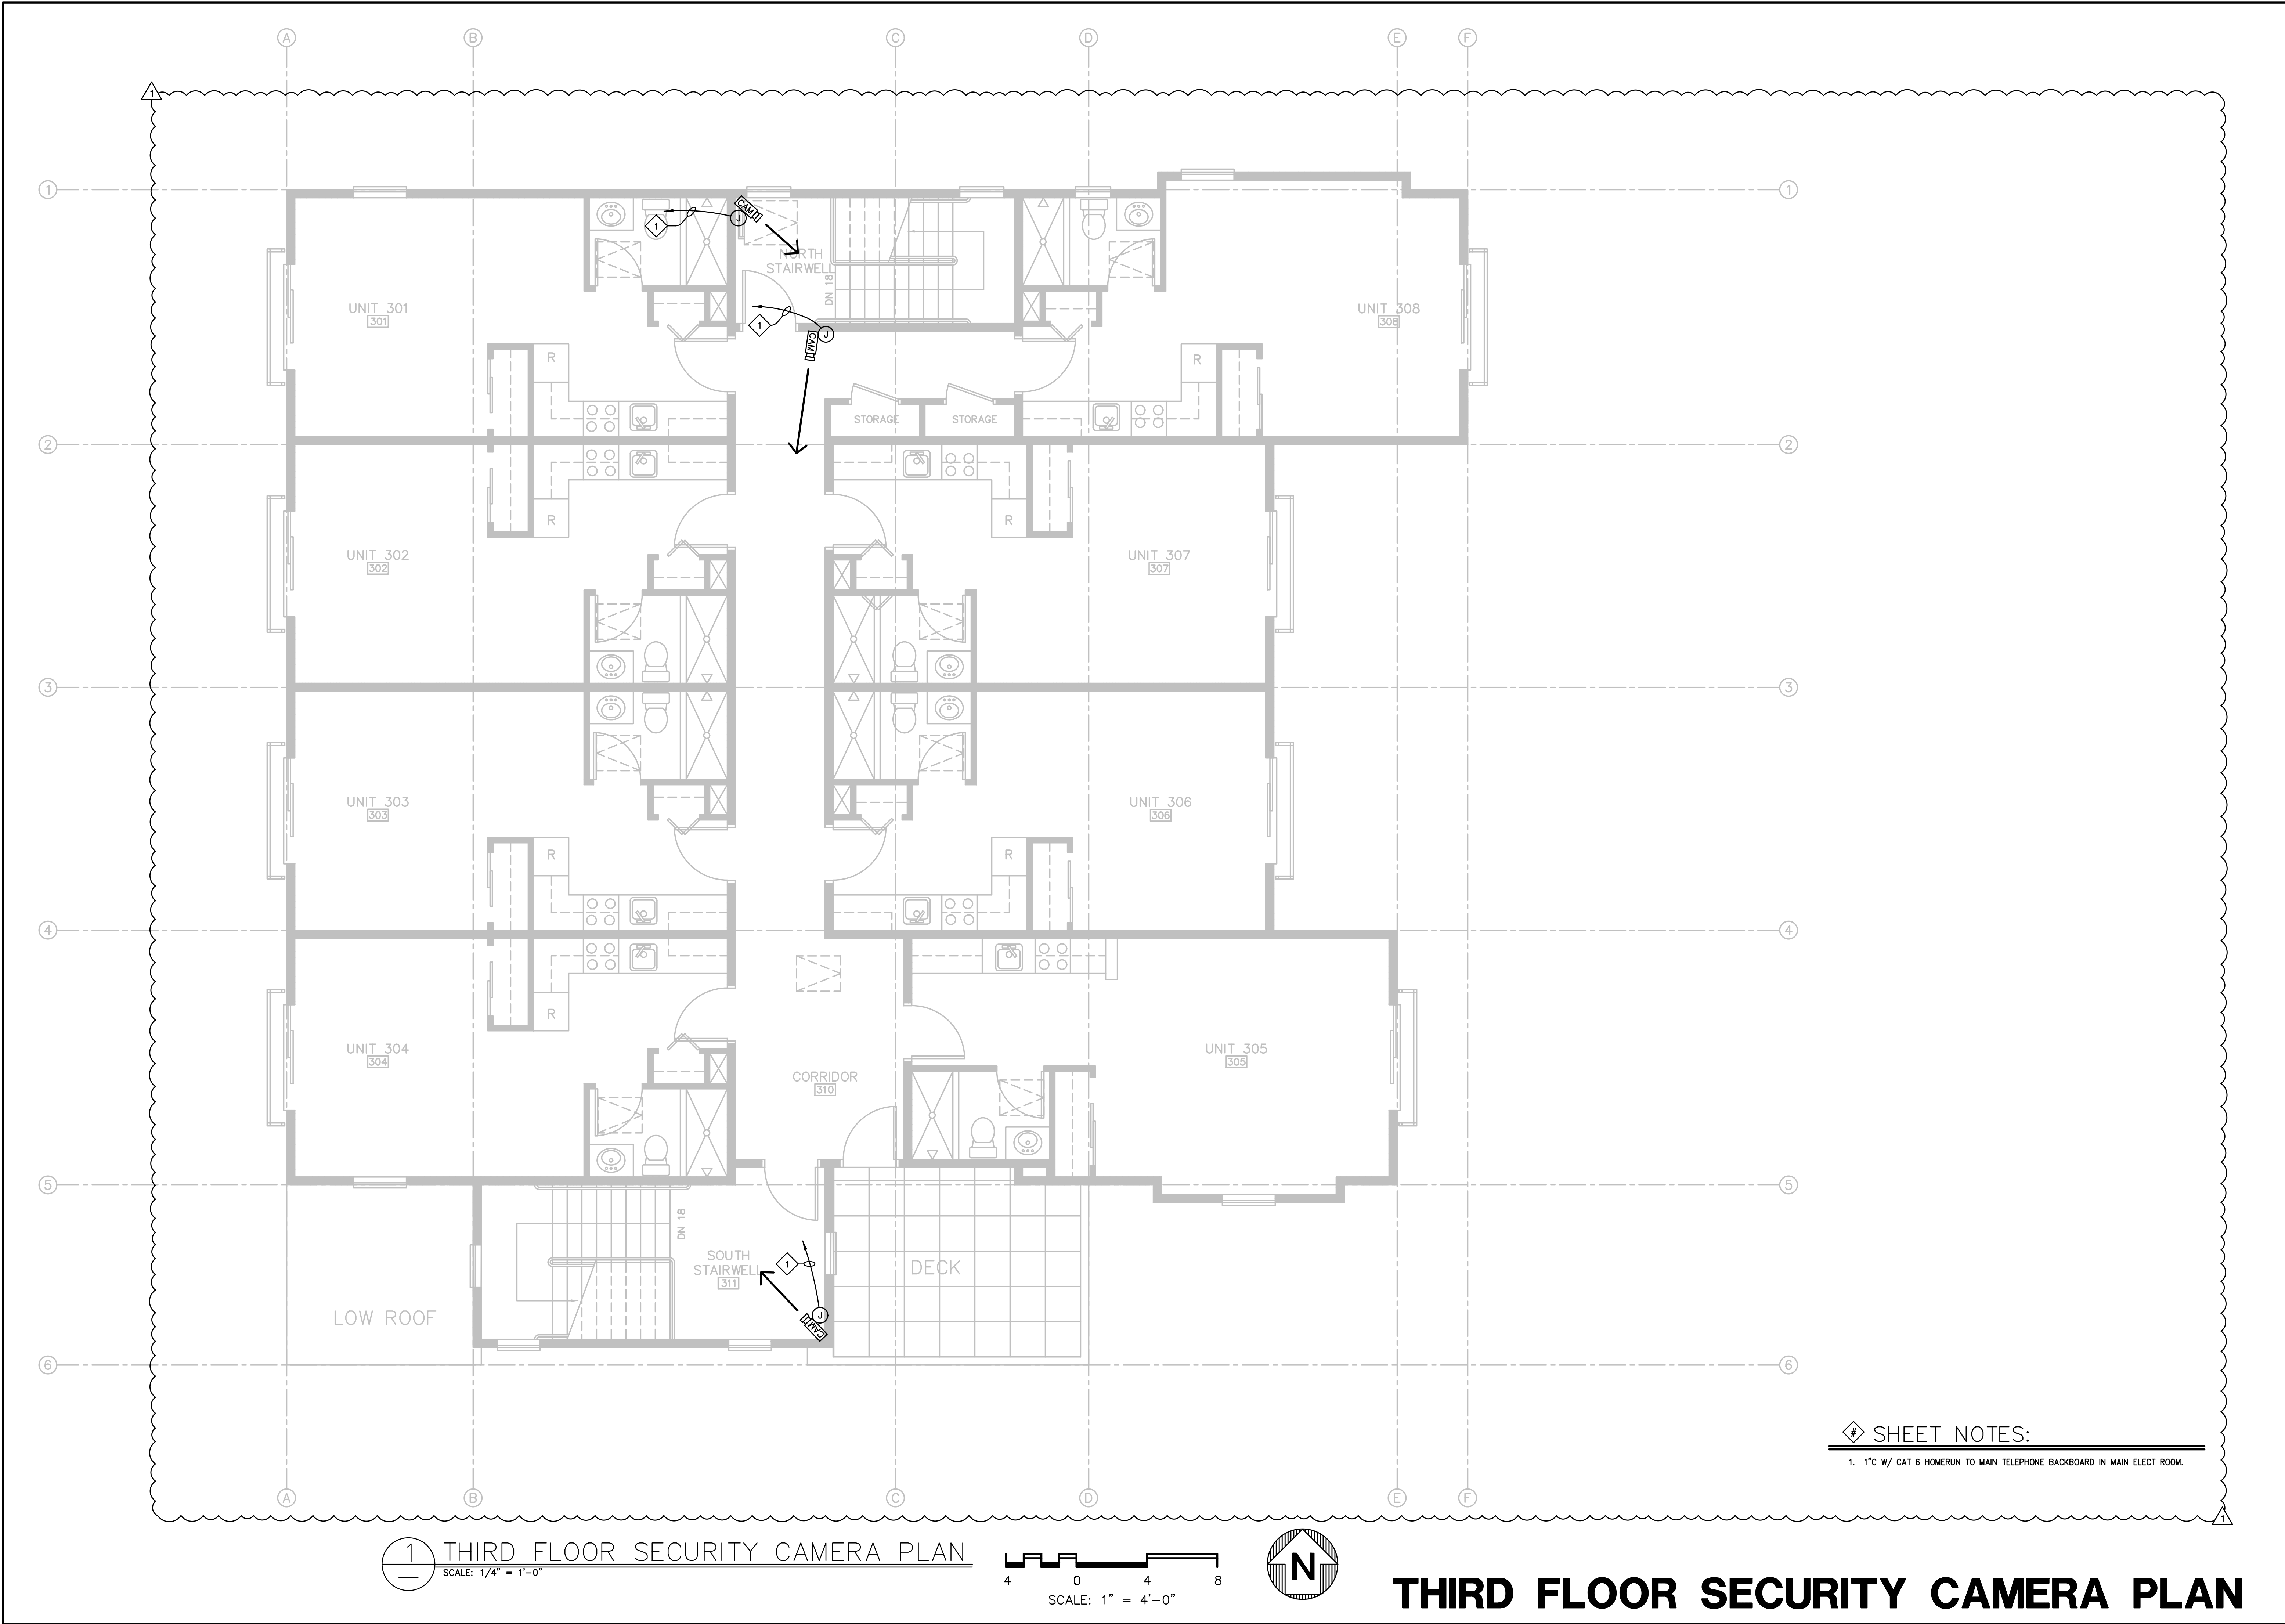

THE USE OF THE PLANS AND SPECIFICATIONS IS LIMITED TO THE PROJECT AND SITE FOR WHICH THEY WERE PREPARED, AND PUBLICATION THEREOF IS PROHIBITED WITHOUT THE WRITTEN CONSENT OF THE ENGINEER. ANY REUSE OR MODIFICATION OF THE PLANS OR SPECIFICATIONS WITHOUT THE WRITTEN CONSENT OF THE ENGINEER IS PROHIBITED. THE ENGINEER ASSUMES NO LIABILITY FOR ANY DAMAGE OR INJURY RESULTING FROM THE USE OF THESE PLANS OR SPECIFICATIONS.				PROPRIETARY DATA			
AFFORDABLE HOUSING PROJECT				REGISTERED PROFESSIONAL ENGINEER			
LOCATION: 415 NATURAL BRIDGES DRIVE SANTA CRUZ, CALIFORNIA				DATE GRANT: 08-30-24			
OWNER: THE HOUSING AUTHORITY OF THE COUNTY OF SANTA CRUZ				ELECTRICAL			
DR. SAK				STATE OF CALIFORNIA			
DATE: 04/20/22				SHEET 11			
CHK. DGS				EXPIRATION DATE: 08-30-24			
APPD. DGS				COPY RIGHT 2008			
JOB NO. 21-044-0				CENTRAL PACIFIC ENGINEERING, INC.			
DWG. NO. E6.30				Professional Engineers			
SH 24 OF 32				9035 Soquel Avenue, Suite 205			
				Santa Cruz, CA 95062			
				831-478-1525			
				CPE JOB 21-044-0			

BASIC ELECTRICAL REQUIREMENTS
SECTION 260000

1. PART 1 GENERAL
- 1.1 SECTION INCLUDES
- A. BASIC ELECTRICAL REQUIREMENTS SPECIFICALLY APPLICABLE TO DIVISION 16 SECTIONS, IN ADDITION TO DIVISION 1 - GENERAL REQUIREMENTS.
- B. THE ELECTRICAL CONTRACTOR SHALL PROVIDE ALL LABOR, MATERIALS TOOLS, TRANSPORTATION, EQUIPMENT, SERVICES, AND FACILITIES REQUIRED FOR THE COMPLETE AND PROPER INSTALLATION OF ALL ELECTRICAL WORK SHOWN ON THE DRAWINGS AND/OR OUTLINED IN THESE SPECIFICATIONS. WORK SHALL INCLUDE ALL MATERIALS, APPLIANCES, AND APPARATUS NOT SPECIFICALLY MENTIONED HEREIN OR NOTED ON THE PLANS BUT NECESSARY TO MAKE A COMPLETE WORKING INSTALLATION OF ALL ELECTRICAL SYSTEMS SHOWN OR DESCRIBED HEREIN.

- 1.2 WORK SEQUENCE
- A. INSTALL WORK IN STAGES DURING THE CONSTRUCTION PERIOD AND COORDINATE ELECTRICAL SCHEDULE AND OPERATIONS WITH OTHER CONTRACTORS DOING WORK OF VARIOUS TRADES EMPLOYED IN CONSTRUCTION OF THE BUILDING. REFER TO CONSTRUCTION DRAWINGS AND SPECIFICATIONS FOR DETAILS.

- 1.3 SUBMITTALS
- A. SUBMITTAL PROCEDURES
1. SCHEDULE SUBMITTALS TO EXPEDITE THE PROJECT, AND DELIVER TO ARCHITECT/ENGINEER AT BUSINESS ADDRESS.
2. IDENTIFY VARIATIONS FROM CONTRACT DOCUMENTS AND PRODUCT OR SYSTEM LIMITATIONS, THAT MAY BE DETRIMENTAL TO SUCCESSFUL PERFORMANCE OF THE COMPLETED WORK.
3. SUBMITTALS SHALL BE MARKED AND / OR HIGHLIGHTED TO IDENTIFY SPECIFIC PRODUCTS BEING SUPPLIED AND/OR INSTALLED. THE MARKING SHALL MAKE REFERENCE TO REFERENCE TO THE CORRESPONDING EQUIPMENT THAT THE MATERIAL IS RELATED TO. EXAMPLE: A SUBMITTAL FOR DISCONNECT SWITCH WOULD HAVE THE MECHANICAL REFERENCE "EF-1", "SF-5" PLACED ON THE SUBMITTAL SHEET.

WHERE BEING SUPPLIED AND/OR INSTALLED ON THE PROJECT SUBMIT ON THE FOLLOWING ITEMS:

- A. GROUND ROD, GROUND CLAMPS
B. OVERHEAD WIREWAY AND MOUNTING HARDWARE
C. DISCONNECT SWITCHES
D. MOTOR STARTERS
E. COMBINATION MOTOR STARTER DISCONNECT SWITCHES
F. FUSES
G. FUSES, SWITCHES AND COVER PLATES
H. TRANSFORMERS
I. WIRE
J. WIRE PULLING LUBRICANT
K. WIREMOLD RACEWAY, COVER PLATES, DEVICE MOUNTING HARDWARE, FITTINGS
L. CONDUIT
M. CONDUIT FITTINGS, CONNECTORS AND COUPLINGS - WEATHERPROOF AND NON-WEATHERPROOF
N. WIRENUTS
O. COMPRESSION CONNECTORS FOR CONDUCTORS
P. WRAPPING MATERIALS AND TAPE
Q. PANELS
R. CIRCUIT BREAKERS
S. ENCLOSED CIRCUIT BREAKERS
T. BOXES
U. STRUT, HANGERS, BRACKETS, MOUNTING HARDWARE

- 1.4 QUALITY CONTROL
- A. QUALITY ASSURANCE/CONTROL OF INSTALLATION
1. MONITOR QUALITY CONTROL OVER SUPPLIERS, MANUFACTURERS, PRODUCTS, SERVICES, SITE CONDITIONS, AND WORKMANSHIP, TO PRODUCE WORK OF SPECIFIED QUALITY.
2. COMPLY FULLY WITH MANUFACTURER'S INSTRUCTIONS, INCLUDING EACH STEP IN SEQUENCE.
3. COMPLY WITH SPECIFIED STANDARDS AS A MINIMUM QUALITY FOR THE WORK EXCEPT WHEN MORE STRINGENT TOLERANCES, CODES, OR SPECIFIED REQUIREMENTS INDICATE HIGHER STANDARDS OR MORE PRECISE WORKMANSHIP.

- 1.5 SAFETY AND INDEMNITY
- A. THE CONTRACTOR SHALL BE RESPONSIBLE FOR IMPLEMENTING, MAINTAINING AND SUPERVISING ALL NECESSARY SAFETY PRECAUTIONS WHICH WILL INSURE AGAINST INJURY TO PERSONS OR DAMAGE TO PROPERTY AS A RESULT OF ANY OF HIS WORK, TOOLS OR EQUIPMENT ON OR OFF THE PROJECT, BEFORE, DURING OR AFTER NORMAL WORKING HOURS. NO DRAWING REVIEW, CONSTRUCTION REVIEW OR ANY OTHER ACT OR SERVICE RENDERED BY THE OWNER, ENGINEER, THEIR EMPLOYEES OR CONSULTANTS SHALL BE CONSTRUED TO APPROVE OR JUDGE UPON THE ADEQUACY OF THE CONTRACTOR'S SAFETY MEASURES.
- B. THE CONTRACTOR SHALL HOLD HARMLESS, INDEMNIFY AND DEFEND THE OWNER, ENGINEER, THEIR EMPLOYEES AND CONSULTANTS FROM ANY AND ALL LIABILITY CLAIMS, LOSSES OR DAMAGE ARISING OR ALLEGED TO ARISE FROM THE PERFORMANCE OF THE WORK DESCRIBED HEREIN, BUT NOT INCLUDING THE SOLE NEGLIGENCE OF THE OWNER, ENGINEER, THEIR EMPLOYEES OR CONSULTANTS.

- 1.6 MATERIALS AND EQUIPMENT
- A. PRODUCTS
1. PRODUCTS: MEANS NEW MATERIAL, MACHINERY, COMPONENTS, EQUIPMENT, FIXTURES, AND SYSTEMS FORMING THE WORK DOES NOT INCLUDE MACHINERY AND EQUIPMENT USED FOR PREPARATION, FABRICATION, CONVEYING AND ERECTION OF THE WORK. PRODUCTS MAY ALSO INCLUDE EXISTING MATERIALS OR COMPONENTS REQUIRED FOR REUSE.
2. DO NOT USE MATERIALS AND EQUIPMENT REMOVED FROM EXISTING PREMISES, EXCEPT AS SPECIFICALLY PERMITTED BY THE CONTRACT DOCUMENTS.
- B. SUBSTITUTIONS
1. THE ENGINEER WILL CONSIDER REQUESTS FOR SUBSTITUTIONS ONLY WITHIN 15 DAYS AFTER DATE OF OWNER-CONTRACTOR AGREEMENT.
2. SUBSTITUTIONS MAY BE CONSIDERED WHEN A PRODUCT BECOMES UNAVAILABLE THROUGH NO FAULT OF THE CONTRACTOR.
3. DOCUMENT EACH REQUEST WITH COMPLETE DATA SUBSTANTIATING COMPLIANCE OF PROPOSED SUBSTITUTION WITH CONTRACT DOCUMENTS.
- C. DELIVERY, STORAGE, AND HANDLING
1. DELIVER, STORE, PROTECT, AND HANDLE PRODUCTS TO SITE.

- 1.7 CONTRACT CLOSEOUT
- A. CLOSEOUT PROCEDURES
1. SUBMIT WRITTEN CERTIFICATION THAT CONTRACT DOCUMENTS HAVE BEEN REVIEWED, WORK HAS BEEN INSPECTED, AND THAT WORK IS COMPLETE IN ACCORDANCE WITH CONTRACT DOCUMENTS AND READY FOR ENGINEER'S INSPECTION.
2. RECORD DRAWINGS: CONTRACTOR SHALL KEEP AN ACCURATE RECORD DURING CONSTRUCTION OF AS-BUILT CONDITIONS ON A SET OF CONTRACT DRAWINGS. PROGRESS AS-BUILTS SHALL BE AVAILABLE FOR OWNER REVIEW WITH EACH SUBMISSION FOR PAYMENT APPLICATION. FINAL RED LINE RECORD DRAWING MARK-UPS SHALL BE SUBMITTED TO THE OWNERS

REPRESENTATIVE WITHIN 30 DAYS OF COMPLETION OF THE PROJECT

3. OPERATION & MAINTENANCE (O&M) MANUALS: AT COMPLETION OF PROJECT CONTRACTOR SHALL SUBMIT TO THE OWNER UP TO 4 COPIES (QTY TO BE VERIFIED WITH OWNER) OF O&M MANUALS WHICH SHALL INCLUDE:

- MFG'S. O&M INSTRUCTIONS FOR ALL EQUIPMENT
- COPIES OF APPROVED SUBMITTAL DATA SHOWING EQUIPMENT SPECIFICATIONS, CAPACITIES, ETC.
- 11x17 (FOLDED) COPIES OF ALL SHOP DRAWINGS
- 11x17 (FOLDED) COPIES OF CONTRACT RECORD DRAWINGS

ALL O&M MANUALS SHALL BE INDEXED & BOUND IN 3 RING BINDERS WITH CLEAR LABELING & TABBED DIVIDERS.

4. OWNERS STAFF AND MAINTENANCE STAFF SHALL BE THOROUGHLY INSTRUCTED IN THE USE AND MAINTENANCE OF THE ELECTRICAL SYSTEM EQUIPMENT, LIGHT FIXTURE, LIGHTING CONTROLS, AND COMMUNICATION SYSTEMS BY MANUFACTURERS AUTHORIZED DISTRIBUTOR PERSONNEL, OR OWNER APPROVED EQUAL. THE INSTRUCTION TO THE STAFF SHALL INCLUDE HANDS ON DEMONSTRATION OF THE VARIOUS FUNCTIONS & OPERATIONS OF THE SYSTEMS AND INCLUDED REQUIRED MAINTENANCE TASKS AND INSTRUCTIONS. TRAINING SHALL INCLUDE A MINIMUM OF EIGHT (8) HOURS.

- A. FINAL CLEANING
1. EXECUTE FINAL CLEANING PRIOR TO FINAL INSPECTION.
2. CLEAN EQUIPMENT AND FIXTURES TO A SANITARY CONDITION.
3. REMOVE WASTE AND SURPLUS MATERIALS, RUBBISH, AND CONSTRUCTION FACILITIES FROM THE SITE.

- 1.8 REGULATORY REQUIREMENTS
- A. CONFORM TO APPLICABLE UNIFORM BUILDING CODE.
- B. CONFORM TO NFPA 70.
- C. CONFORM TO LOCAL ORDINANCES AND REGULATIONS.
- D. OBTAIN PERMITS, AND REQUEST INSPECTIONS FROM AUTHORITY HAVING JURISDICTION.
- E. FURNISH PRODUCTS LISTED AND CLASSIFIED BY UNDERWRITERS LABORATORIES, INC. AND TESTING FIRM ACCEPTABLE TO AUTHORITY HAVING JURISDICTION AS SUITABLE FOR PURPOSE SPECIFIED AND SHOWN.
- F. SHOULD THERE BE ANY CONFLICTS BETWEEN THE DRAWINGS, SPECIFICATIONS, OR REGULATORY REQUIREMENTS, THE MOST STRINGENT CONDITION SHALL GOVERN, UNLESS APPROVED BY THE ENGINEER.
- G. FURNISH WITHOUT EXTRA CHARGE ADDITIONAL MATERIALS AND LABOR WHICH MAY BE REQUIRED FOR COMPLIANCE WITH THE LAWS, RULES AND REGULATIONS EVEN THOUGH THE WORK IS NOT MENTIONED IN THESE SPECIFICATIONS OR SHOWN ON THE DRAWINGS.
- 1.9 PROJECT/SITE CONDITIONS
- A. INSTALL WORK IN LOCATIONS SHOWN ON DRAWINGS, UNLESS PREVENTED BY PROJECT CONDITIONS.
- B. PREPARE DRAWINGS SHOWING PROPOSED REARRANGEMENT OF WORK TO MEET PROJECT CONDITIONS, INCLUDING CHANGES TO WORK SPECIFIED IN OTHER SECTIONS. OBTAIN PERMISSION OF ENGINEER BEFORE PROCEEDING.

2. PART 2 PRODUCTS
- 2.1 CONDUIT REQUIREMENTS
- A. MINIMUM SIZE: 1/2 INCH UNLESS OTHERWISE SPECIFIED.
- B. UNDERGROUND INSTALLATIONS:
- 1. USE PVC SCH 40 NONMETALLIC CONDUIT.
 - 2. MINIMUM SIZE: 3/4 INCH.
- C. OUTDOOR LOCATIONS, ABOVE GRADE:
- 1. EXPOSED: USE RIGID GALVANIZED STEEL CONDUIT.
 - 2. CONCEALED: USE PVC SCH 40 NONMETALLIC CONDUIT.
- D. IN SLAB:
- 1. USE PVC SCH 40 NONMETALLIC CONDUIT.
 - 2. MINIMUM SIZE CONDUIT IN SLAB: 3/4 INCH, UNLESS OTHERWISE SPECIFIED.
 - 3. MAXIMUM SIZE CONDUIT IN SLAB: 1 INCH, UNLESS OTHERWISE SPECIFIED.
- E. WET AND DAMP LOCATIONS:
- 1. EXPOSED: USE RIGID GALVANIZED STEEL CONDUIT.
 - 2. CONCEALED: USE PVC SCH 40 NONMETALLIC CONDUIT.
- F. INDOOR DRY LOCATIONS:
- 1. CONCEALED: USE RIGID GALVANIZED STEEL CONDUIT, ELECTRICAL METALLIC TUBING, PVC SCH 40 NONMETALLIC CONDUIT.
 - 2. EXPOSED: USE RIGID GALVANIZED STEEL CONDUIT, AND ELECTRICAL METALLIC TUBING.

- 2.2 BUILDING WIRE AND CABLE
- A. DESCRIPTION: SINGLE CONDUCTOR INSULATED STRANDED WIRE.
- 1. CONDUCTOR: COPPER.
 - 2. INSULATION VOLTAGE RATING: 600 VOLTS.
 - 3. INSULATION: ANSINFFPA 70, TYPE THHN/THWN.
 - 4. SIZE: 12 AWG. MINIMUM UNLESS OTHERWISE NOTED.
- B. DESCRIPTION: NON-METALLIC SHEATHED CABLE ("ROMEX").
- 1. CONDUCTOR: COPPER.
 - 2. INSULATION VOLTAGE RATING: 600 VOLTS.
 - 3. INSULATION: ANSINFFPA 70, TYPE NMC
 - 4. SIZE: 12 AWG. MINIMUM UNLESS OTHERWISE NOTED.
- C. DESCRIPTION: FLEXIBLE METAL CLAD CABLE "MC"
- 1. CONDUCTOR: SOLID/ STRANDED COPPER.
 - 2. VOLTAGE RATING: 600 VOLTS.
 - 3. TEMPERATURE RATING: 90 DEGREE C, (DRY)
 - 4. CONDUCTOR INSULATION: ANSINFFPA 70, TYPE THHN/THWN.
 - 5. CONDUCTOR SIZE: 12 AWG. WITH 10 AWG NEU. FOR SHARED NEUTRAL MINIMUM UNLESS OTHERWISE NOTED.
 - 6. ASSEMBLY COVERING: MYLAR TYPE
 - 7. ARMOR: GALVANIZED OR ALUMINUM STEEL

- D. DESCRIPTION: TELCOM CABLE CAT 6
- 1. CONDUCTOR: UTP CABLE SHALL BE 4-PAIR, 23 AWG, SOLID CONDUCTOR UL LISTED OFNP (OPTICAL FIBER NONCONDUCTIVE RISER) CABLING THAT MEETS ANS/ISA-688 CATEGORY 6 CABLE. TO INCLUDE ALL CURRENT ADDENDUMS AND BULLETINS AND SHALL MEET SPECIFIED SPECIFICATIONS AND PERFORMANCE REQUIREMENTS. USE BERKETER LANMARK-6 CMP, BLUE.
- E. DESCRIPTION: RG-11 CABLE
- 1. CONDUCTOR: 75 OHM SDI COAX, RG-11, 14 AWG SOLID BARE COPPER CONDUCTOR, PE INSULATION, FOIL + 95% TINNED COPPER BRAID SHIELD, LSZH JACKET, CMG-LS, SHIPBOARD ABS TYPE APPROVED

- 2.3 OUTLET BOXES
- A. SHEET METAL OUTLET BOXES: ANSINEMA OS 1, GALVANIZED STEEL
- 1. LUMINAIRE AND EQUIPMENT SUPPORTING BOXES: RATED FOR WEIGHT OF EQUIPMENT SUPPORTED.
- B. NONMETALLIC OUTLET BOXES: ANSINEMA OS 2.
- C. CAST BOXES: NEMA FB 1, TYPE FD, GALVANIZED STEEL. PROVIDE GASKETED COVER BY BOX MANUFACTURER. PROVIDE THREADED HUBS.

- 2.4 PULL AND JUNCTION BOXES
- A. SHEET METAL BOXES: NEMA OS 1, GALVANIZED STEEL.
- B. SURFACE-MOUNTED CAST METAL BOX: NEMA 250, TYPE 4; FLAT-FLANGED, SURFACE-MOUNTED JUNCTION BOX.
- 1. MATERIAL: CAST GALVANIZED STEEL.
 - 2. COVER: FURNISH WITH GROUND FLANGE, NEOPRENE GASKET, AND STAINLESS STEEL COVER SCREWS.

- 2.5 WALL SWITCHES
- A. MANUFACTURERS:
- 1. LEVITON: SPECIFICATION GRADE.
- B. DESCRIPTION: HEAVY-DUTY, AC ONLY GENERAL-USE SWITCH.
- C. DEVICE BODY: WHITE PLASTIC WITH (DECORA) HANDLE.
- D. VOLTAGE RATING: 120-277 VOLTS, AC.
- E. CURRENT RATING: 20 AMPERES.

- 2.6 RECEPTACLES
- A. MANUFACTURERS:
- 1. LEVITON: SPECIFICATION GRADE.
- B. DESCRIPTION: HEAVY-DUTY, RECEPTACLE - COMMERCIAL UNITS
- C. DEVICE BODY: WHITE PLASTIC, (DECORA) STYLE
- D. CONFIGURATION: TYPE AS SPECIFIED AND INDICATED.
- E. CONVENIENCE RECEPTACLE: TYPE 5-20R.
- F. GFCI RECEPTACLE: CONVENIENCE RECEPTACLE WITH INTEGRAL GROUND FAULT CIRCUIT INTERRUPTER TO MEET REGULATORY REQUIREMENTS, WITH LED STATUS INDICATOR LIGHT.

- 2.7 WALL PLATES
- A. DECORATIVE COVER PLATE: WHITE SMOOTH (NYLON, DECORA)
- 1. LEVITON.
- B. WEATHERPROOF COVER PLATE: GASKETED IN USE TYPE WITH METAL HINGED GASKETED DEVICE COVER.

- 2.8 CORDS AND CAPS
- A. MANUFACTURERS:
- 1. APPLETON
 - 2. HUBBELL
 - 3. SLATER
 - 4. ARROW-HART
- B. ATTACHMENT PLUG CONSTRUCTION: CONFORM TO NEMA.
- C. CONFIGURATION: MATCH RECEPTACLE CONFIGURATION AT OUTLET PROVIDED FOR EQUIPMENT.
- D. CORD CONSTRUCTION: MULTICONDUCTOR FLEXIBLE CORD WITH IDENTIFIED EQUIPMENT GROUNDING CONDUCTOR, SUITABLE FOR USE IN DAMP LOCATIONS.
- E. SIZE: SUITABLE FOR CONNECTED LOAD OF EQUIPMENT, LENGTH OF CORD, AND RATING OF BRANCH CIRCUIT OVERCURRENT PROTECTION.

- 2.9 SUPPORTING DEVICES
- A. MATERIALS AND FINISHES: PROVIDE ADEQUATE CORROSION RESISTANCE.
- B. PROVIDE MATERIALS, SIZES, AND TYPES OF ANCHORS, FASTENERS AND SUPPORTS TO CARRY THE LOADS OF EQUIPMENT AND CONDUIT. CONSIDER WEIGHT OF WIRE IN CONDUIT WHEN SELECTING PRODUCTS.
- C. ANCHORS AND FASTENERS:
- 1. CONCRETE STRUCTURAL ELEMENTS: USE PRECAST INSERT SYSTEM, EXPANSION ANCHORS, POWDER ACTUATED ANCHORS AND PRESET INSERTS.
 - 2. CONCRETE SURFACES: USE SELF-DRILLING ANCHORS AND EXPANSION ANCHORS.
 - 3. HOLLOW MASONRY, PLASTER, AND GYPSUM BOARD PARTITIONS: USE TOGGLE BOLTS AND BOLLARD WALL FASTENERS.
 - 4. SOLID MASONRY WALLS: USE EXPANSION ANCHORS AND PRESET INSERTS.
 - 5. SHEET METAL: USE SHEET METAL SCREWS.
 - 6. WOOD ELEMENTS: USE WOOD SCREWS.

- 2.10 NAMEPLATES AND LABELS
- A. NAMEPLATES: ENGRAVED THREE-LAYER LAMINATED PLASTIC, WHITE LETTERS ON BLACK BACKGROUND.
- B. LOCATIONS:
- 1. EACH ELECTRICAL DISTRIBUTION AND CONTROL EQUIPMENT ENCLOSURE.
- C. LETTER SIZE:
- 1. USE 1/4 INCH (6 MM) LETTERS FOR IDENTIFYING INDIVIDUAL EQUIPMENT AND LOADS.
- D. LABELS: EMBOSSED ADHESIVE TAPE, WITH 3/16 INCH (5 MM) WHITE LETTERS ON BLACK BACKGROUND. USE ONLY FOR IDENTIFICATION OF INDIVIDUAL WALL SWITCHES AND RECEPTACLES.

- 2.11 WIRE MARKERS
- A. DESCRIPTION: CLOTH, TAPE, SPLIT SLEEVE, OR TUBING TYPE WIRE MARKERS.
- B. LOCATIONS: EACH CONDUCTOR AT PANELBOARD GUTTERS, PULL BOXES, OUTLET AND JUNCTION BOXES, AND EACH LOAD CONNECTION.
- C. LEGEND:
- 1. POWER AND LIGHTING CIRCUITS: BRANCH CIRCUIT OR FEEDER NUMBER INDICATED ON DRAWINGS.
 - 2. CONTROL CIRCUITS: CONTROL WIRE NUMBER INDICATED ON SCHEMATIC AND INTERCONNECTION DIAGRAMS ON DRAWINGS/ SHOP DRAWINGS.

- 2.12 PANELBOARDS/LOADCENTERS (AS SCHEDULED)
- A. MANUFACTURE:
- 1. SQUARE "D"
 - 2. CUTLER-HAMMER
 - 3. SIEMENS
 - 4. GENERAL ELECTRIC.
- B. ENCLOSURE: GENERAL PURPOSE, NEMA 1; UNLESS OTHERWISE NOTED.
- C. PROVIDE FLUSH/SURFACE (AS SCHEDULED) BOX, AND LATCH ON DOOR. FINISH IN MANUFACTURER'S STANDARD GRAY ENAMEL.
- D. PROVIDE BUS RATINGS AND MATERIALS AS SCHEDULED.
- E. MINIMUM INTEGRATED SHORT CIRCUIT RATING: 10,000 AMPERES RMS SYMMETRICAL.
- F. MOLDED CASE CIRCUIT BREAKERS: BOLT-ON/PLUG-ON (AS SCHEDULED) TYPE THERMAL MAGNETIC TRIP CIRCUIT BREAKERS, WITH COMMON TRIP HANDLE FOR ALL POLES. PROVIDE UL CLASS A GROUND FAULT INTERRUPTER CIRCUIT BREAKERS WHERE SCHEDULED.
- G. DO NOT USE TANDEM CIRCUIT BREAKERS.

- 2.13 LUMINAIRES
- A. FURNISH PRODUCTS AS SPECIFIED IN SCHEDULE ON DRAWINGS.
- B. SUBSTITUTIONS: UNDER PROVISIONS OF THE CONTRACT.
- C. INSTALL DRIVERS, LEDS, AND SPECIFIED ACCESSORIES AT FACTORY.
- D. SPECIFY AN IN-LINE DISCONNECT TO MEET NEC. FURTHER REQUIRE THAT THE LIGHTING MANUFACTURER PROVIDE A "WIRE NUT" CONNECTION ON THE LOAD SIDE OF THE DISCONNECT TO FACILITATE LIGHT FIXTURE SERVICING.
- E. COLOR TEMPERATURE & CRI: U.O.N. 3500K, CRI ≥ 80.
- F. LED DRIVERS SHALL HAVE THE FOLLOWING CHARACTERISTICS (UNLESS APPROVED BY ENGINEER):
- 1. MAXIMUM DRIVE CURRENT: 350MA.
 - 2. MINIMUM EFFICIENCY: 85%.
 - 3. OPERATING TEMPERATURE RANGE: -40°C TO 50°C.
 - 4. MINIMUM RATED LIFE: 50,000 HOURS.
 - 5. DIMMING RANGE: 100% TO 10%.
 - 6. UL CLASS I OR II OUTPUT.
 - 7. POWER FACTOR: 90%.
 - 8. TOTAL HARMONIC DISTORTION: 20%.
 - 9. COMPLY WITH FCC 47 CFR PART 15 NON-CONSUMER RF/EMI STANDARDS.
- G. ACCESSORIES: PROVIDE LUMINAIRE ACCESSORIES AS INDICATED.

- 2.14 ENCLOSED SWITCHES
- A. FUSIBLE SWITCH ASSEMBLIES: NEMA 1 - INDOOR, NEMA 3R - OUTDOOR, TYPE HD (HEAVY DUTY) LOAD INTERRUPTER ENCLOSED KNIFE SWITCH WITH EXTERNALLY OPERABLE HANDLE INTERLOCKED TO PREVENT OPENING FRONT COVER WITH SWITCH IN ON POSITION. HANDLE LOCKABLE IN OFF POSITION. FUSE CLIPS: DESIGNED TO ACCOMMODATE CLASS R FUSES.
- B. NONFUSIBLE SWITCH ASSEMBLIES: NEMA 1 - INDOOR, NEMA 3R - OUTDOOR, TYPE HD LOAD INTERRUPTER ENCLOSED KNIFE SWITCH WITH EXTERNALLY OPERABLE HANDLE INTERLOCKED TO PREVENT OPENING FRONT COVER WITH SWITCH IN ON POSITION. HANDLE LOCKABLE IN OFF POSITION.

- 2.15 FUSES
- A. MANUFACTURERS:
- 1. BUSSMAN
 - 2. GUILD - SCHWAMUT.
- B. DESCRIPTION: DUAL ELEMENT, CURRENT LIMITING, ONE-TIME FUSE, 250 OR 600 VOLT AS APPLICATION REQUIRES.
- C. INTERRUPTING RATING: 200,000 RMS AMPERES.

3. PART 3 EXECUTION

- 3.1 CONDUIT
- A. INSTALL CONDUIT IN ACCORDANCE WITH NECA "STANDARD OF INSTALLATION."
- B. ARRANGE CONDUIT TO MAINTAIN HEADROOM AND PRESENT NEAT APPEARANCE.
- C. ROUTE CONDUIT PARALLEL AND PERPENDICULAR TO WALLS.
- D. MAINTAIN 12 INCH (300 MM) CLEARANCE BETWEEN CONDUIT AND SURFACES WITH TEMPERATURES EXCEEDING 104 DEGREES F (40 DEGREES C).
- E. CUT CONDUIT SQUARE USING SAW OR PIPECUTTER; DE-BURR CUT ENDS.
- F. BRING CONDUIT TO SHOULDER OF FITTINGS; FASTEN SECURELY.
- G. JOIN NON-METALLIC CONDUIT USING CEMENT AS RECOMMENDED BY MANUFACTURER. WIRE NONMETALLIC CONDUIT DRY AND CLEAN BEFORE JOINING. APPLY FULL EVEN COAT OF CEMENT TO ENTIRE AREA INSERTED IN FITTING. ALLOW JOINT TO CURE FOR 20 MINUTES, MINIMUM.
- H. USE CONDUIT HUBS OR SEALING LOCKNUTS TO FASTEN CONDUIT TO SHEET METAL BOXES IN DAMP AND WET LOCATIONS AND TO CAST BOXES.
- I. INSTALL NO MORE THAN EQUIVALENT OF THREE 90-DEGREE BENDS BETWEEN BOXES. USE CONDUIT BODIES TO MAKE SHARP CHANGES IN DIRECTION, AS AROUND BEAMS. USE HYDRAULIC ONE-SHOT BENDER TO FABRICATE FACTORY ELBOWS FOR BENDS IN METAL CONDUIT LARGER THAN 2 INCH (50 MM) SIZE.

- 3.2 BUILDING WIRE & CABLE
- A. PULL ALL CONDUCTORS INTO RACEWAY AT SAME TIME.
- B. USE SUITABLE WIRE PULLING LUBRICANT FOR BUILDING WIRE.
- C. USE SUITABLE CABLE FITTINGS AND CONNECTORS.
- D. NEATLY TRAIN AND LACE WIRING INSIDE BOXES, EQUIPMENT, AND PANELBOARDS.
- E. CLEAN CONDUCTOR SURFACES BEFORE INSTALLING LUGS AND CONNECTORS.
- F. MAKE SPLICES, TAPS, AND TERMINATIONS TO CARRY FULL AMPLACITY OF CONDUCTORS WITH NO PERCEPTIBLE TEMPERATURE RISE.
- G. USE COMPRESSION CONNECTORS FOR COPPER CONDUCTOR SPLICES AND TAPS, AND WIRE PULLING EQUIPMENT UNINSULATED CONDUCTORS AND CONNECTOR WITH ELECTRICAL TAPE TO 150 PERCENT OF INSULATION RATING OF CONDUCTOR.
- H. USE INSULATED SPRING WIRE CONNECTORS WITH PLASTIC CAPS FOR COPPER CONDUCTOR SPLICES AND TAPS, 10 AWG AND SMALLER.
- I. UNLESS OTHERWISE NOTED BRANCH CIRCUIT WIRING MAXIMUM 50 AMPS, MAY BE "ROMEX" OR FLEXIBLE METAL CLAD CABLE "MC" WHERE CONCEALED IN WOOD FRAMED SPACES, LIGHTING CONTROL, CAT 5E WIRING WHERE CONCEALED IN WOOD FRAMED SPACES MAY BE RUN WITHOUT CONDUIT.
- ALL OTHER LOW-VOLTAGE WIRING INCLUDING TELCOM & CABLE WIRING, SHALL BE INSTALLED IN CONDUIT.

- 3.3 BOXES
- A. INSTALL ELECTRICAL BOXES AS SHOWN ON DRAWINGS, AND AS REQUIRED FOR SPLICES, TAPS, WIRE PULLING, EQUIPMENT CONNECTIONS AND COMPLIANCE WITH REGULATORY REQUIREMENTS.
- B. INSTALL ELECTRICAL BOXES TO MAINTAIN HEADROOM AND TO PRESENT NEAT MECHANICAL APPEARANCE.
- C. INSTALL BOXES TO PRESERVE FIRE RESISTANCE RATING OF PARTITIONS AND OTHER ELEMENTS, USING MATERIALS AND METHODS UNDER THE PROVISIONS IN THE SPECIFICATIONS.
- D. SUPPORT BOXES INDEPENDENTLY OF CONDUIT EXCEPT CAST BOX THAT IS CONNECTED TO TWO RIGID METAL CONDUITS BOTH SUPPORTED WITHIN 12 INCHES (300 MM) OF BOX.
- E. USE GANG BOX WHERE MORE THAN ONE DEVICE IS MOUNTED TOGETHER. DO NOT USE SECTIONAL BOX.
- F. USE GANG BOX WITH PLASTER RING FOR SINGLE DEVICE OUTLETS.
- G. USE CAST OUTLET BOX IN EXTERIOR LOCATIONS EXPOSED TO THE WEATHER AND WET LOCATIONS.

- 3.4 WIRING DEVICES
- A. INSTALL PRODUCTS IN ACCORDANCE WITH MANUFACTURER'S INSTRUCTIONS.
- B. INSTALL DEVICES PLUMB AND LEVEL.
- C. INSTALL SWITCHES WITH OFF POSITION DOWN.
- D. INSTALL RECEPTACLES WITH GROUNDING POLE ON BOTTOM.
- E. CONNECT WIRING DEVICE GROUNDING TERMINAL TO OUTLET BOX WITH BONDING JUMPER AND BRANCH CIRCUIT EQUIPMENT GROUNDING CONDUCTOR WHEN INSTALLED PER DRAWINGS.
- F. CONNECT WIRING DEVICES BY WRAPPING CONDUCTOR AROUND SCREW TERMINAL.
- G. COORDINATE LOCATIONS OF OUTLET BOXES TO OBTAIN MOUNTING HEIGHTS SPECIFIED AND INDICATED ON DRAWINGS.

- H. INSTALL WALL SWITCH 46 INCHES (1.2 M) ABOVE FINISHED FLOOR, UNLESS OTHERWISE NOTED.
- I. INSTALL CONVENIENCE RECEPTACLE 15 INCHES (381 MM) ABOVE FINISHED FLOOR, UNLESS OTHERWISE NOTED.
- J. INSTALL CONVENIENCE RECEPTACLE 6 INCHES (153 MM) ABOVE COUNTER, UNLESS OTHERWISE NOTED.

- 3.5 EQUIPMENT WIRING AND SYSTEMS
- A. MAKE ELECTRICAL CONNECTIONS IN ACCORDANCE WITH EQUIPMENT MANUFACTURER'S INSTRUCTIONS.
- B. MAKE CONDUIT CONNECTIONS TO EQUIPMENT USING FLEXIBLE CONDUIT. USE LIQUDTIGHT FLEXIBLE CONDUIT WITH WATERTIGHT CONNECTORS IN DAMP OR WET LOCATIONS.
- C. MAKE WIRING CONNECTIONS USING WIRE AND CABLE WITH INSULATION SUITABLE FOR TEMPERATURES ENCOUNTERED IN HEAT PRODUCING EQUIPMENT.
- D. INSTALL DISCONNECT SWITCHES, CONTROLLERS, CONTROL STATIONS, AND CONTROL DEVICES AS INDICATED.
- E. MODIFY EQUIPMENT CONTROL WIRING WITH TERMINAL BLOCK JUMPERS AS INDICATED.
- F. PROVIDE INTERCONNECTING CONDUIT AND WIRING BETWEEN DEVICES AND EQUIPMENT WHERE INDICATED.

- 3.6 SUPPORTING DEVICES
- A. INSTALL PRODUCTS IN ACCORDANCE WITH MANUFACTURER'S INSTRUCTIONS.
- B. PROVIDE ANCHORS, FASTENERS, AND SUPPORTS IN ACCORDANCE WITH NECA "STANDARD OF INSTALLATION".
- C. DO NOT FASTEN SUPPORTS TO PIPES, DUCTS, MECHANICAL EQUIPMENT, AND CONDUIT.
- D. OBTAIN PERMISSION FROM ARCHITECT/ENGINEER BEFORE DRILLING OR CUTTING STRUCTURAL MEMBERS.


- 3.7 ELECTRICAL IDENTIFICATION
- A. DEGREASE AND CLEAN SURFACES TO RECEIVE NAMEPLATES AND LABELS.
- B. INSTALL NAMEPLATE AND LABEL PARALLEL TO EQUIPMENT LINES.
- C. SECURE NAMEPLATE TO EQUIPMENT FRONT USING SCREWS, OR RIVETS.
- 3.8 PANELBOARDS/LOADCENTERS (AS SCHEDULED)
- A. INSTALL PLUMB AND FLUSH WITH WALL FINISHES, IN CONFORMANCE WITH NEMA FB 1.
- B. HEIGHT: 6 FT (2 M), TO TOP OF BOX.
- C. PROVIDE FILLER PLATES FOR UNUSED SPACES.
- D. PROVIDE TYPED CIRCUIT DIRECTORY FOR EACH BRANCH CIRCUIT PANELBOARD/LOADCENTER. REVISE DIRECTORY TO REFLECT CIRCUITING CHANGES REQUIRED TO BALANCE PHASE LOADS.
- E. MEASURE STEADY STATE LOAD CURRENTS AT EACH PANELBOARD/LOADCENTERS FEEDER. SHOULD THE DIFFERENCE BETWEEN PHASES EXCEED 20 PERCENT, REARRANGE CIRCUITS IN THE PANELBOARD/LOADCENTER TO BALANCE THE PHASE LOADS WITHIN 20 PERCENT. TAKE CARE TO MAINTAIN PROPER PHASING FOR MULTI-WIRE BRANCH CIRCUITS.
- F. VISUAL AND MECHANICAL INSPECTION: INSPECT FOR PHYSICAL DAMAGE, PROPER ALIGNMENT, ANCHORAGE, AND GROUNDING. CHECK PROPER INSTALLATION AND TIGHTNESS OF CONNECTIONS FOR CIRCUIT BREAKERS, FUSIBLE SWITCHES, AND FUSES.

- 3.9 LUMINAIRES
- A. INSTALL IN ACCORDANCE WITH MANUFACTURERS INSTRUCTIONS.
- B. INSTALL SURFACE MOUNTED LUMINAIRES AND PLUMB AND ADJUST TO ALIGN WITH BUILDING LINES AND WITH EACH OTHER. SECURE TO PROHIBIT MOVEMENT.
- C. INSTALL WALL MOUNTED LUMINAIRES, AT HEIGHT AS INDICATED ON DRAWINGS.
- D. INSTALL SPECIFIED LAMPS / LED COLOR, OUTPUT AND DRIVERS IN EACH LUMINAIRE.
- E. CLEAN ELECTRICAL PARTS TO REMOVE CONDUCTIVE AND DELETERIOUS MATERIALS.
- F. REMOVE DIRT AND DEBRIS FROM ENCLOSURE.
- G. CLEAN PHOTOMETRIC CONTROL SURFACES AS RECOMMENDED BY MANUFACTURER.
- H. CLEAN FINISHES AND TOUCH UP DAMAGE.
- 3.10 ENCLOSED SWITCHES
- A. INSTALL DISCONNECT SWITCHES WHERE INDICATED.
- B. INSTALL FUSES IN FUSIBLE DISCONNECT SWITCHES.
- C. PROVIDE ADHESIVE LABEL ON INSIDE DOOR OF EACH SWITCH INDICATING UL FUSE CLASS AND SIZE FOR REPLACEMENT.

END OF SECTION 260000

TITLE: AFFORDABLE HOUSING PROJECT		REV.		DESCRIPTION		DATE		PROPRIETARY DATA	
JOB NO. 21-044-0		DWG. NO. E7.00		SH 25 OF 32		REV. 1		THE USE OF THE PLANS AND SPECIFICATIONS IS LIMITED TO THE PROJECT AND SITE SPECIFICALLY IDENTIFIED HEREIN. THEY ARE NOT TO BE REPRODUCED, COPIED, OR PUBLISHED IN ANY MANNER WITHOUT THE WRITTEN PERMISSION OF THE ENGINEER. ANY REUSE OF THESE PLANS OR SPECIFICATIONS FOR ANY OTHER PROJECT WITHOUT THE WRITTEN PERMISSION OF THE ENGINEER WILL BE AT THE USER'S SOLE RISK AND WITHOUT LIABILITY TO THE ENGINEER. THE USER AGREES TO HOLD THE ENGINEER HARMLESS FROM ANY AND ALL CLAIMS, DAMAGES, LOSSES, AND EXPENSES, INCLUDING ATTORNEY'S FEES, THAT MAY BE INCURRED BY THE ENGINEER AS A RESULT OF SUCH REUSE. THE USER AGREES TO INDEMNIFY AND HOLD THE ENGINEER HARMLESS FROM ANY AND ALL CLAIMS, DAMAGES, LOSSES, AND EXPENSES, INCLUDING ATTORNEY'S FEES, THAT MAY BE INCURRED BY THE ENGINEER AS A RESULT OF SUCH REUSE.	
LOCATION: 415 NATURAL BRIDGES DRIVE SANTA CRUZ, CALIFORNIA		OWNER: THE HOUSING AUTHORITY OF THE COUNTY OF SANTA CRUZ		DR. SAK		DATE 04/20/22		REGISTERED PROFESSIONAL ENGINEER DATE OF GRANT: 09-30-24 EXPIRATION DATE: 09-30-24 ELECTRICAL STATE OF CALIFORNIA	
OWNER: THE HOUSING AUTHORITY OF THE COUNTY OF SANTA CRUZ		DR. SAK		DATE 04/20/22		SCALE AS NOTED		Professional Engineers 9035 Soquel Avenue, Suite 205 Santa Cruz, CA 95062 831-478-1525 CPE JOB 21-044-0	

ELECTRICAL SPECIFICATIONS

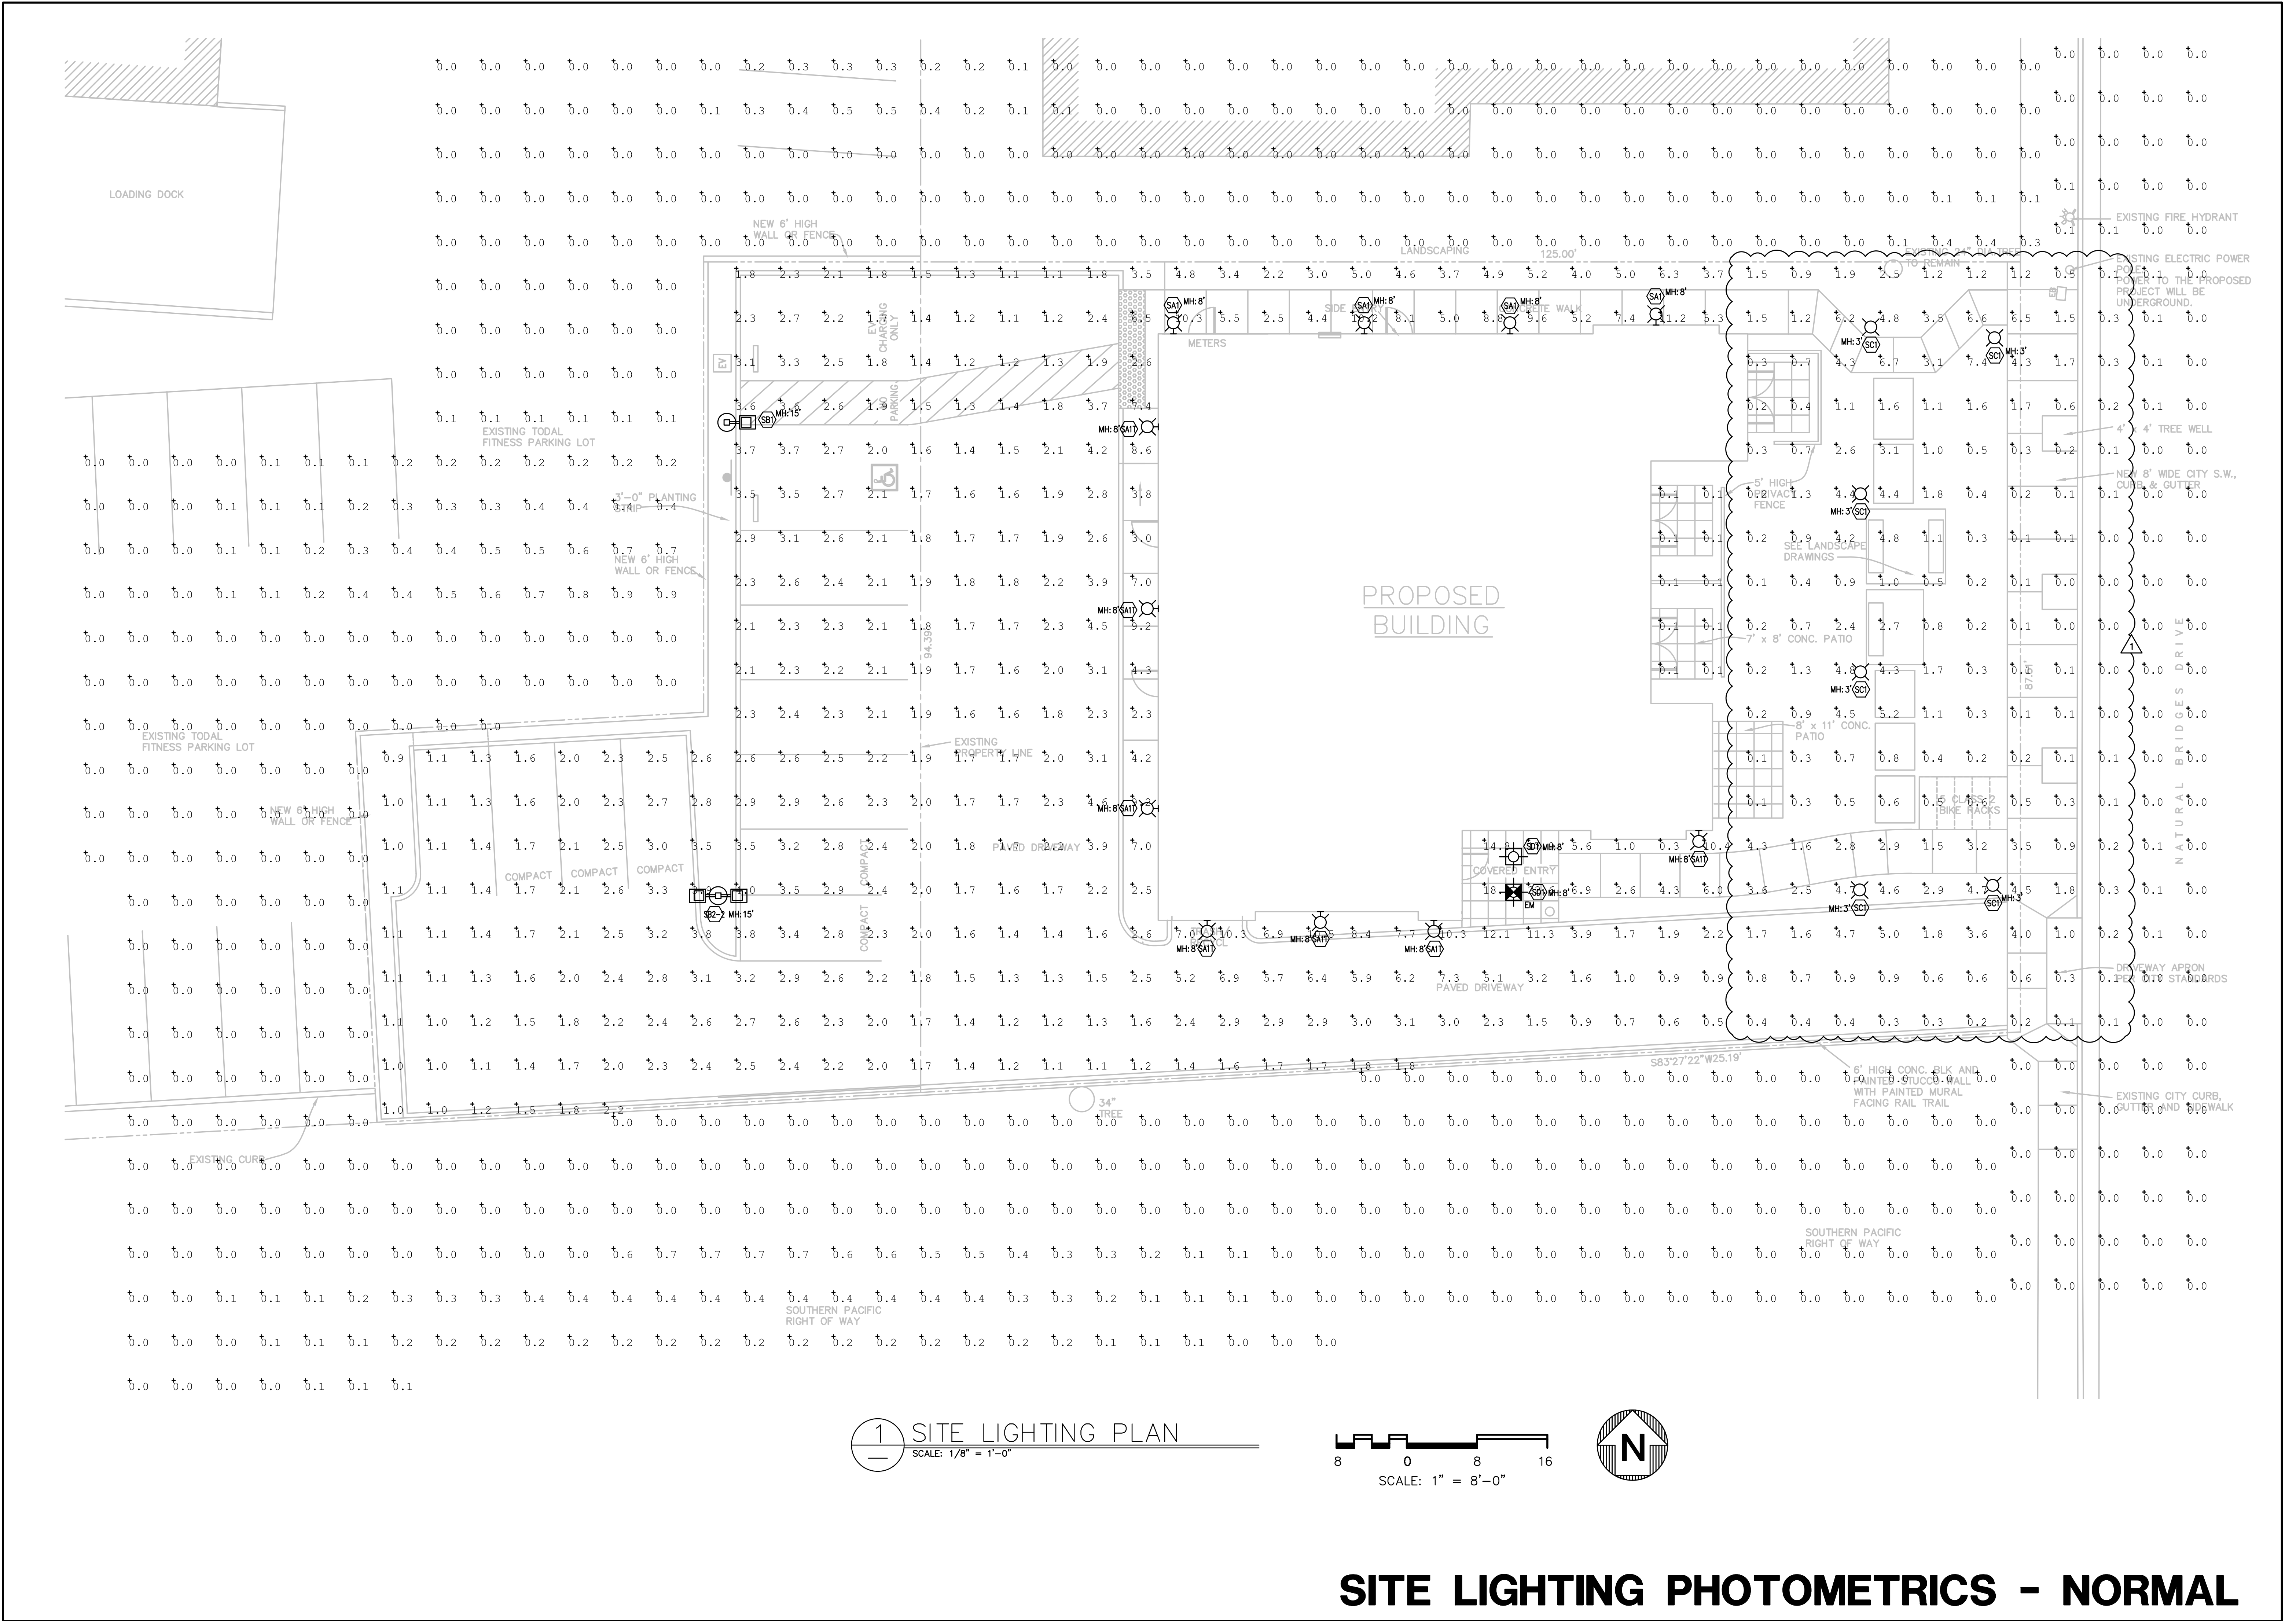

PROPRIETARY DATA
THE USE OF THE PLANS AND SPECIFICATIONS IS LIMITED TO THE PROJECT AND SITE FOR WHICH THEY WERE PREPARED, AND NO PART OF THEM SHALL BE REPRODUCED OR TRANSMITTED IN ANY FORM OR BY ANY MEANS, ELECTRONIC OR MECHANICAL, WITHOUT THE WRITTEN PERMISSION OF CENTRAL PACIFIC ENGINEERING, INC.
COPYRIGHT 2006

REGISTERED PROFESSIONAL ENGINEER
DATE: 11/15/2023
EXPIRATION DATE: 09-30-24
ELECTRICAL
STATE OF CALIFORNIA

Central Pacific Engineering, Inc.
Professional Engineers
9035 Soquel Avenue, Suite 205
Santa Cruz, CA 95062
831-478-1525
CPE JOB 21-044-0

REV.	DESCRIPTION	DATE
1	ISSUED FOR PLAN CHECK	08/27/22
2	PLAN CHECK & OWNER COMMENTS	10/14/22
3		
4		
5		

TITLE: AFFORDABLE HOUSING PROJECT

LOCATION: 415 NATURAL BRIDGES DRIVE
SANTA CRUZ, CALIFORNIA

OWNER: THE HOUSING AUTHORITY OF THE COUNTY OF SANTA CRUZ

DR. DATE: 04/20/22

CHK. DGS

APPD. DGS

SCALE: AS NOTED


JOB NO. 21-044-0

DWG. NO. EL110


SH 26 OF 32

REV. 1

SITE LIGHTING PHOTOMETRICS - NORMAL

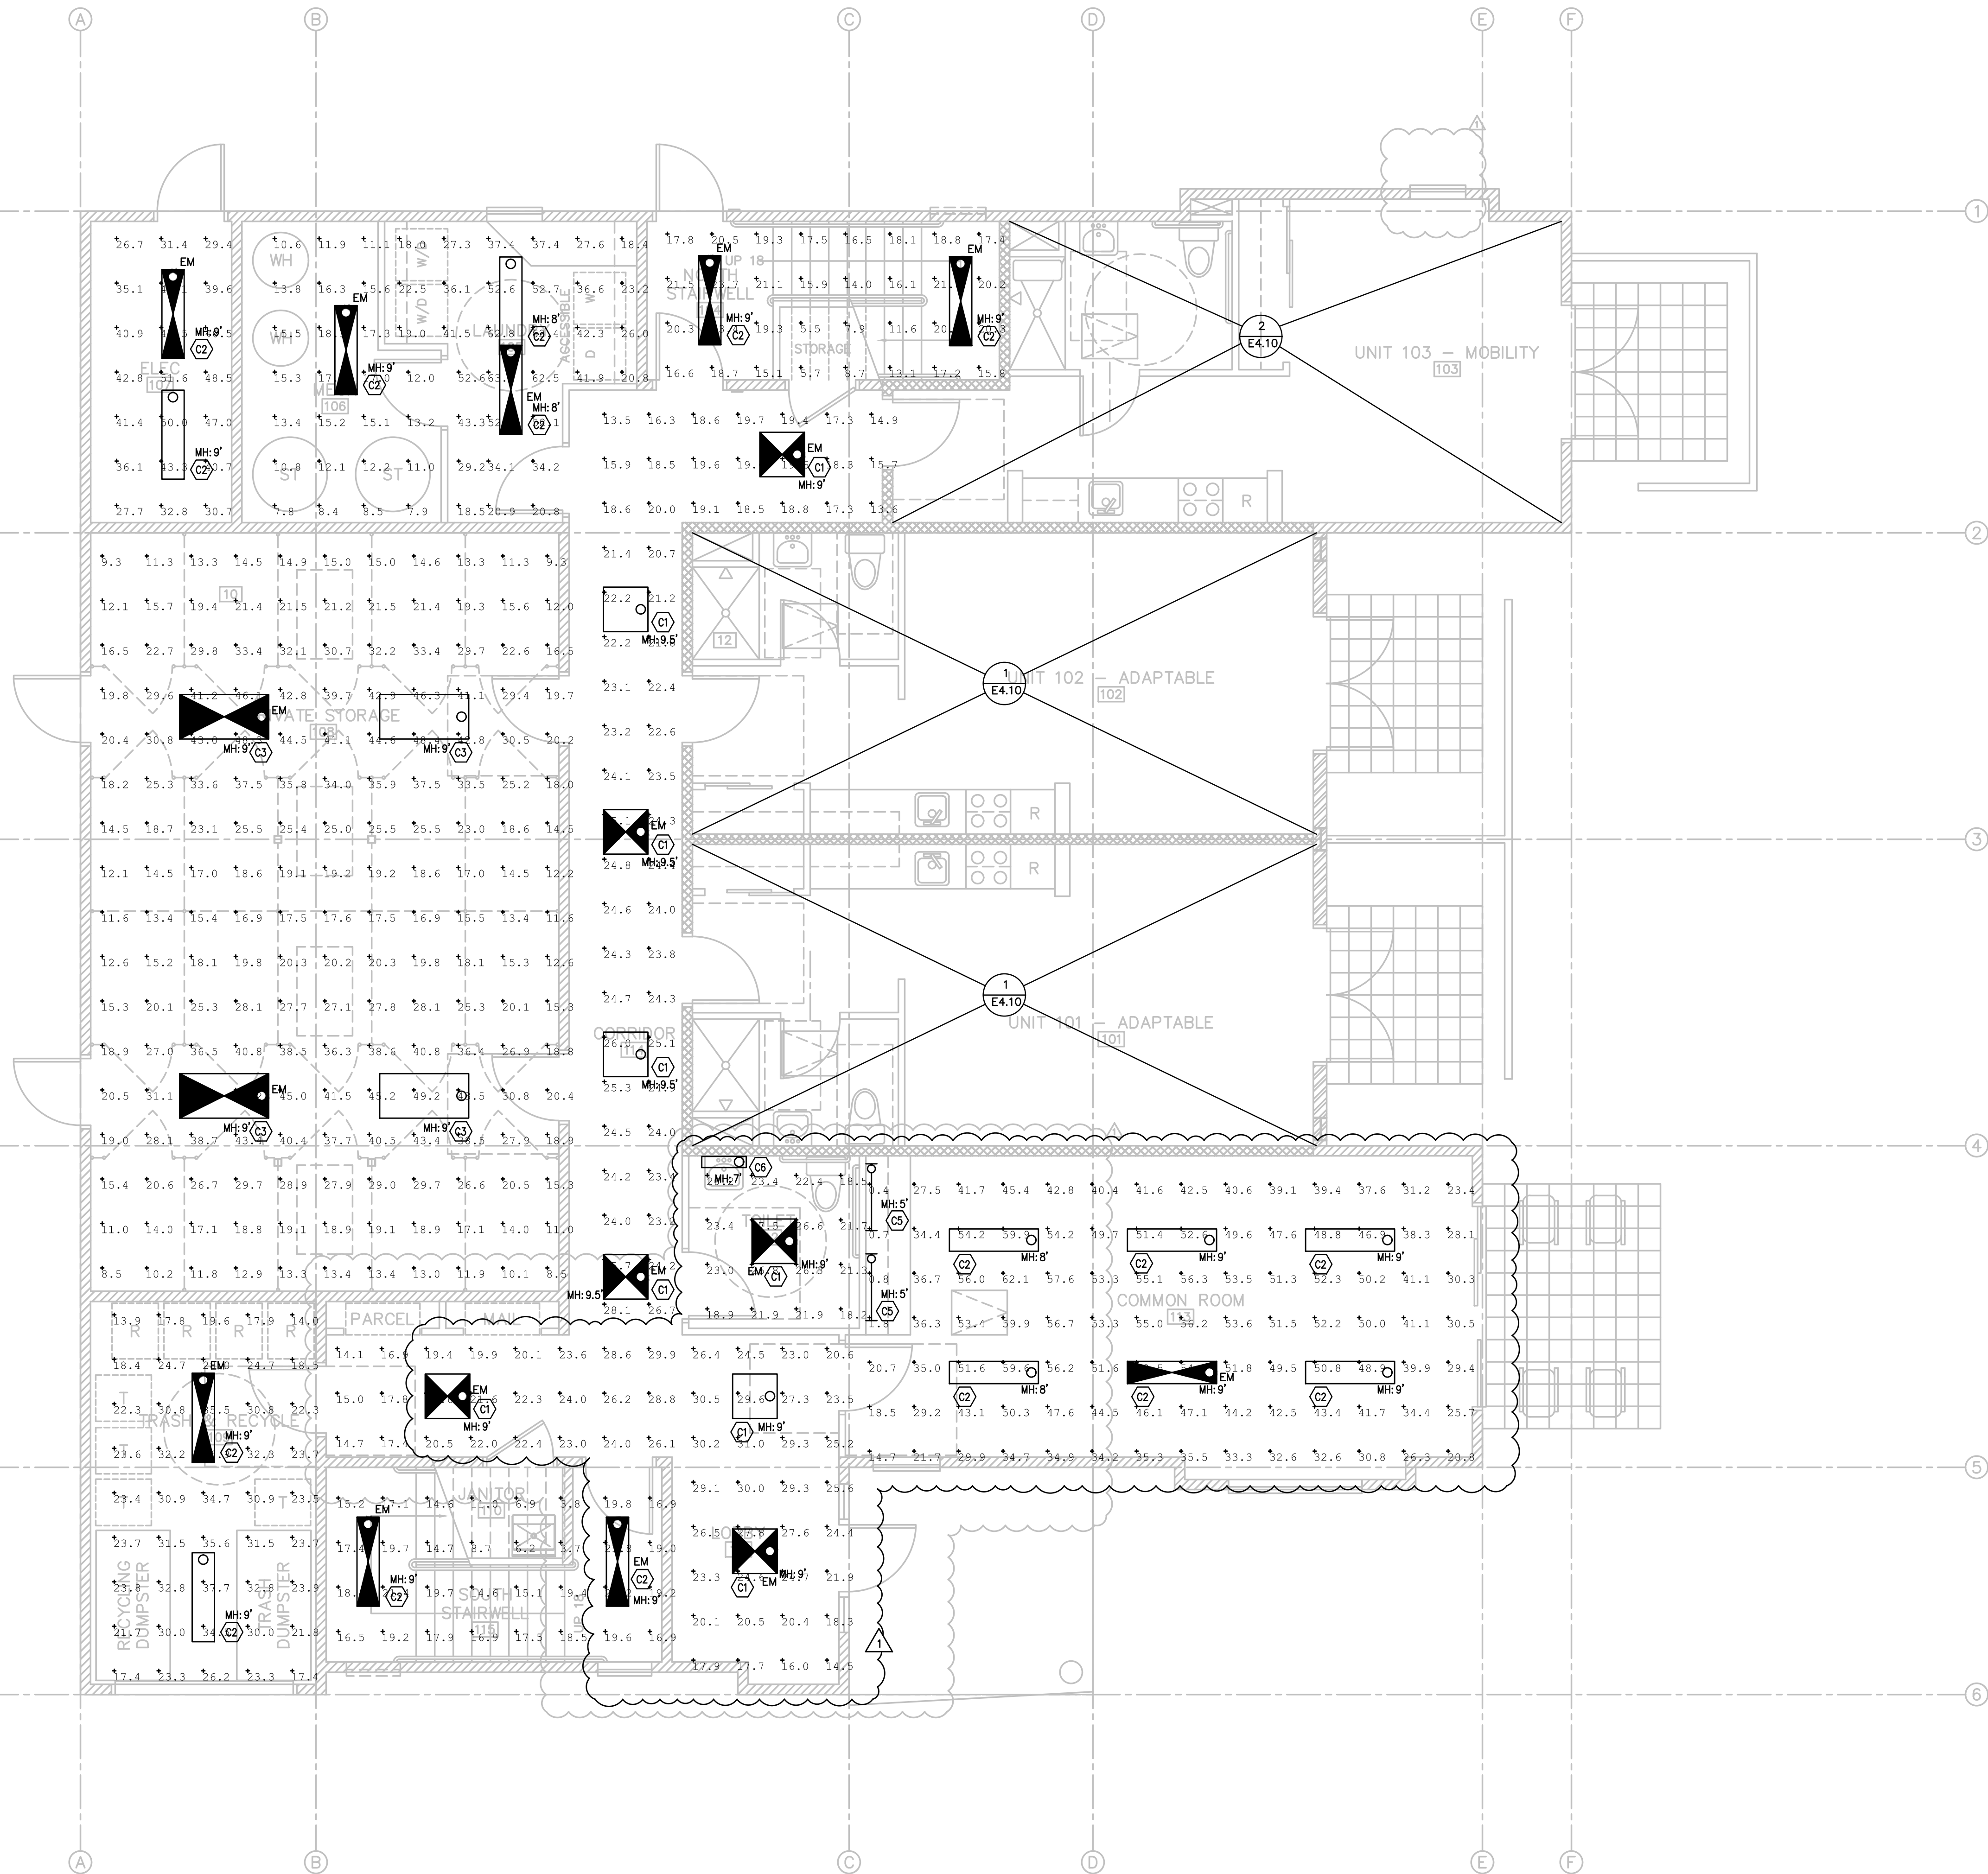

1 FIRST FLOOR PHOTOMETRICS — NORMAL
SCALE: 1/4" = 1'-0"

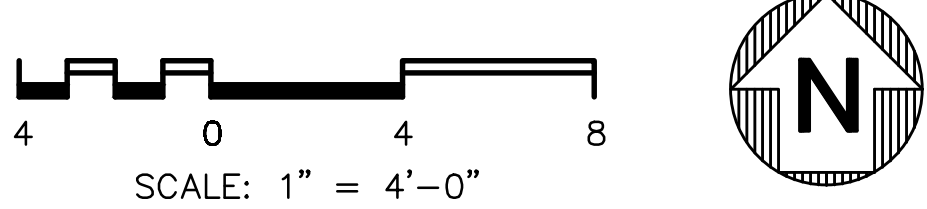

FIRST FLOOR PHOTOMETRICS - NORMAL

PROPRIETARY DATA
THE USE OF THE PLANS AND SPECIFICATIONS IS LIMITED TO THE PROJECT AND SITE FOR WHICH THEY WERE PREPARED, AND PUBLICATION THEREOF IN ANY FORM OR BY ANY MEANS WITHOUT THE WRITTEN CONSENT OF CENTRAL PACIFIC ENGINEERING, INC. IS PROHIBITED. THE PROJECT FOR WHICH THE PLANS AND SPECIFICATIONS WERE PREPARED CONSTITUTES PRIMA FACIE EVIDENCE OF THE ACCEPTANCE OF THESE RESTRICTIONS.
CENTRAL PACIFIC ENGINEERING, INC.
COPYRIGHT 2006

REGISTERED PROFESSIONAL ENGINEER
E. L. LUGO
EXPIRATION DATE: 08-30-24
ELECTRICAL
STATE OF CALIFORNIA

Central Pacific Engineering, Inc.
Professional Engineers
9035 Soquel Avenue, Suite 205
Santa Cruz, CA 95062
831-478-1525
CPE JOB 21-044-0

REV.	DESCRIPTION	DATE
1	ISSUED FOR PLAN CHECK	08/27/22
2	PLAN CHECK & OWNER COMMENTS	10/14/22
3		
4		
5		

TITLE: **AFFORDABLE HOUSING PROJECT**

JOB NO. 21-044-0

DWG. NO. **EL2.10**

SH 27 OF 32

LOCATION: 415 NATURAL BRIDGES DRIVE
SANTA CRUZ, CALIFORNIA

OWNER: THE HOUSING AUTHORITY OF THE COUNTY OF SANTA CRUZ


DR. SAK

DATE 04/20/22


CHK. DGS

APPD. DGS

SCALE AS NOTED

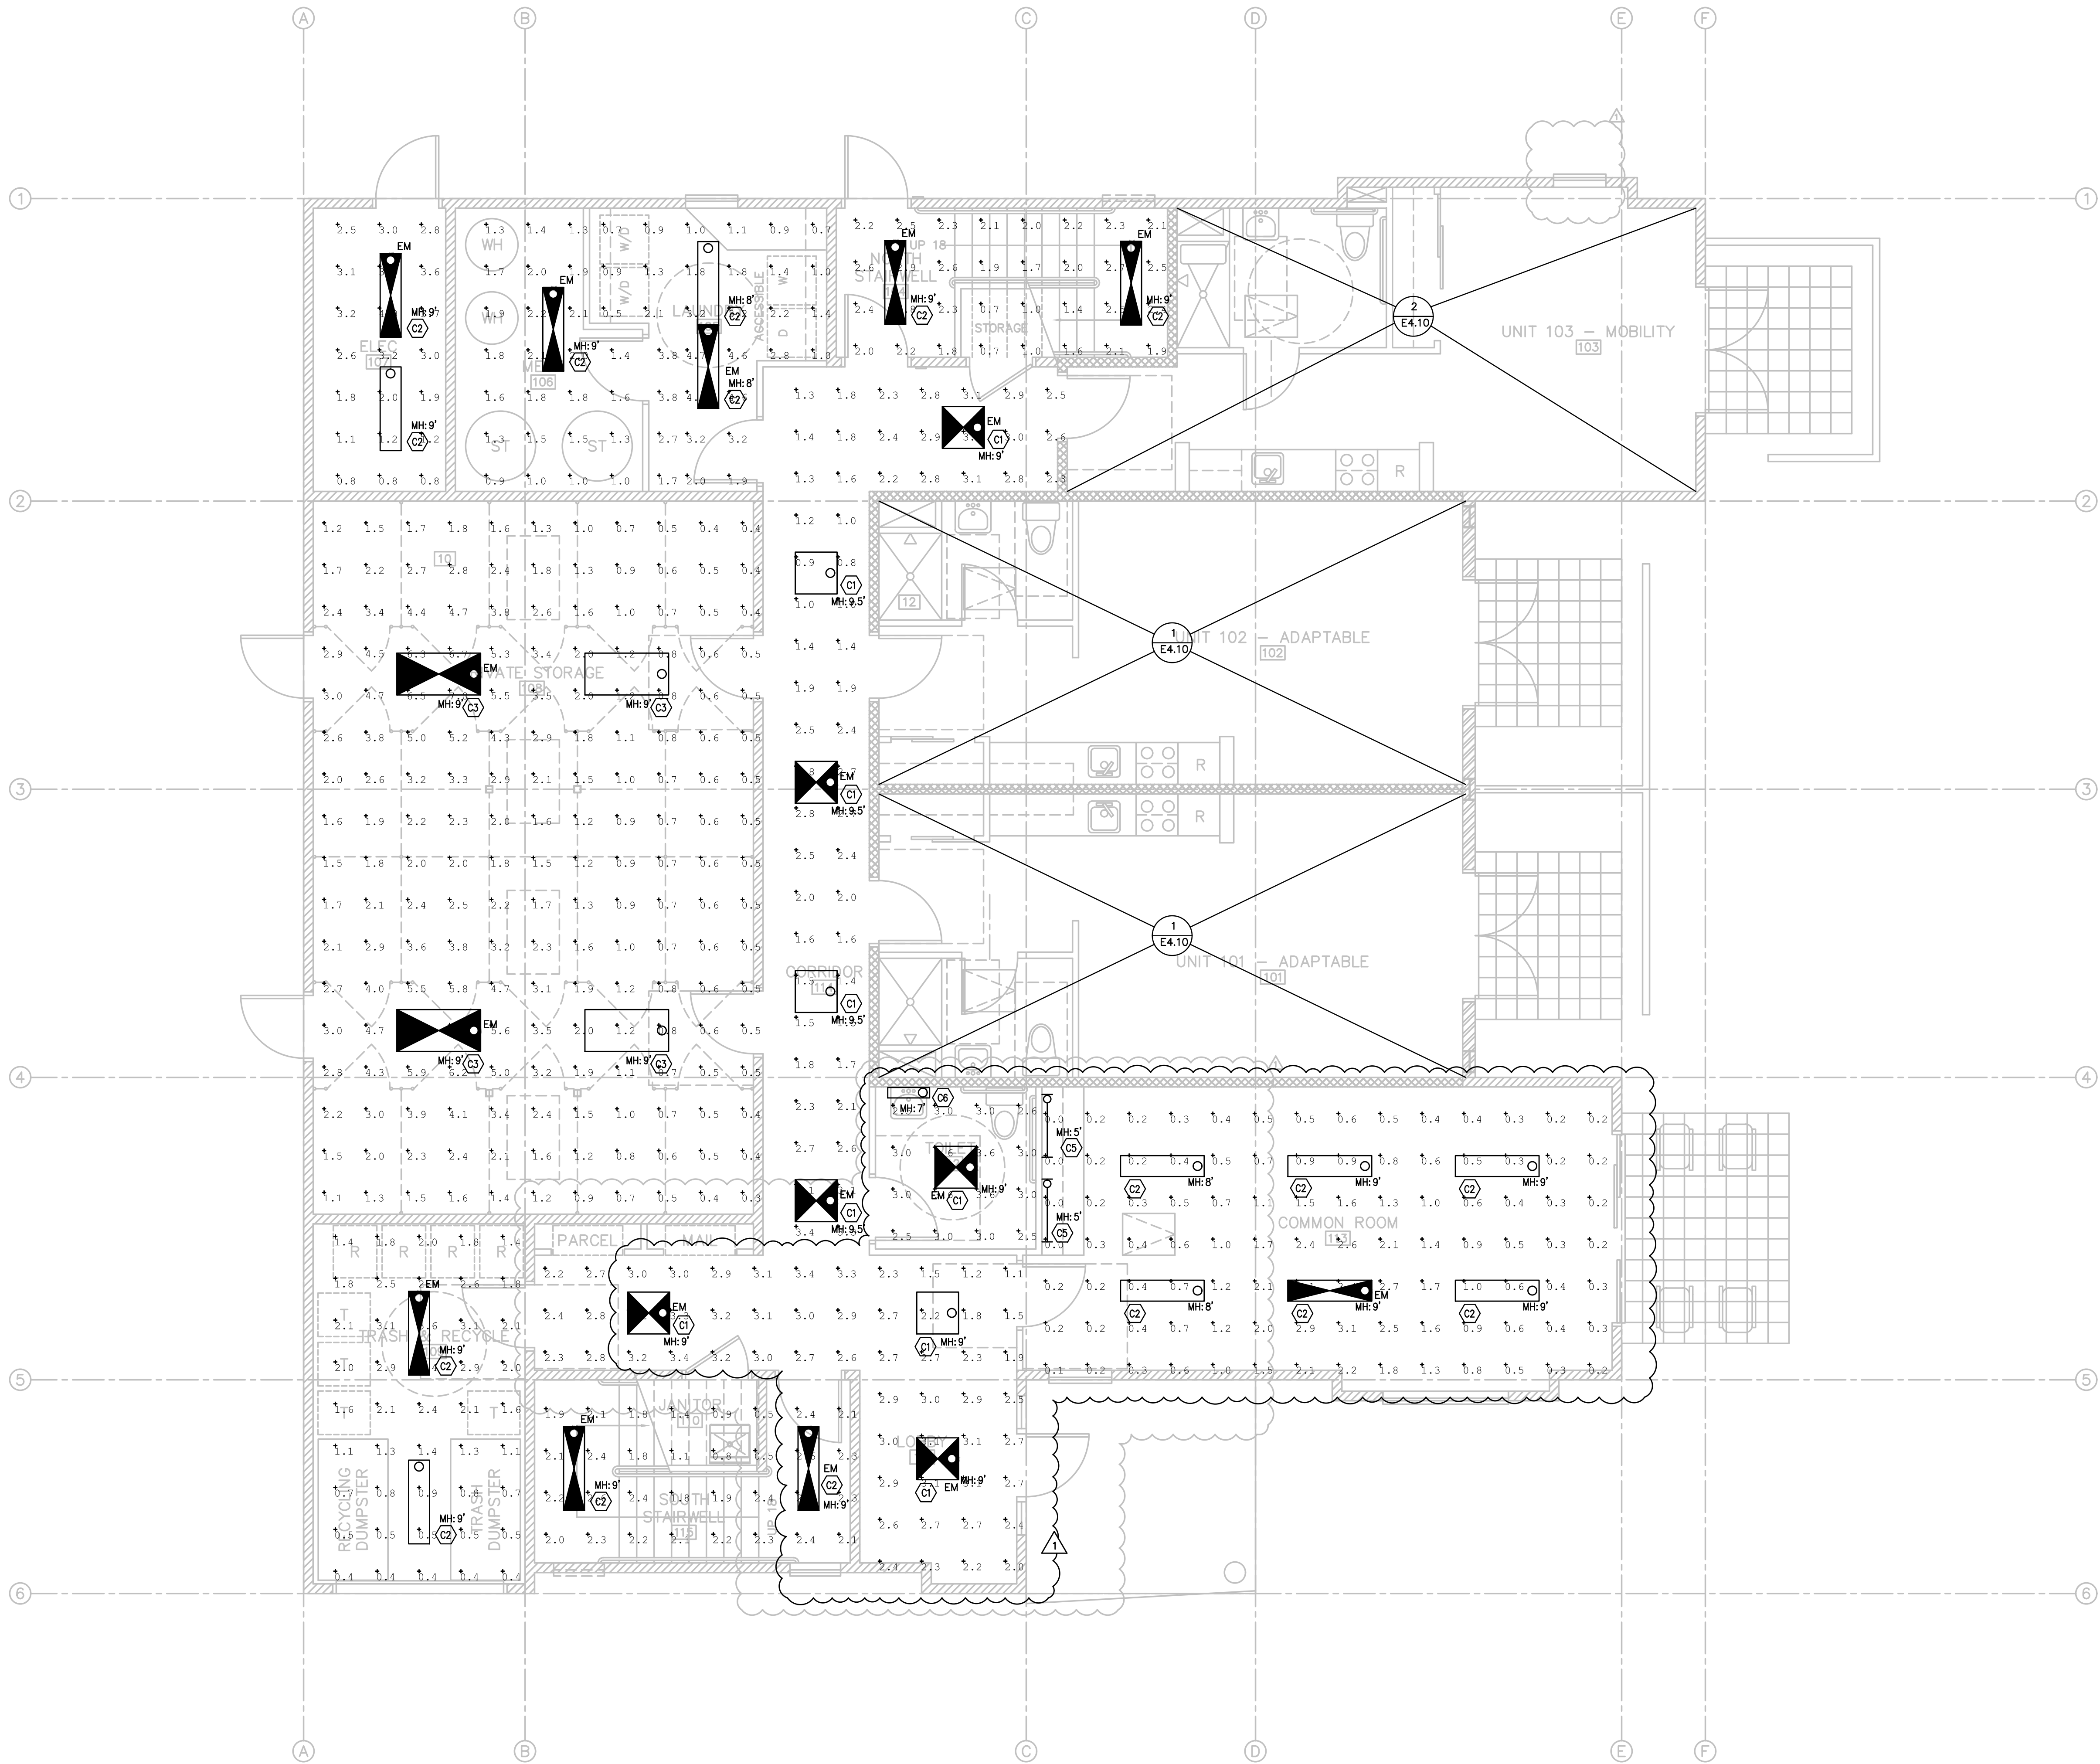

1 FIRST FLOOR PHOTOMETRICS — EMERG
SCALE: 1/4" = 1'-0"

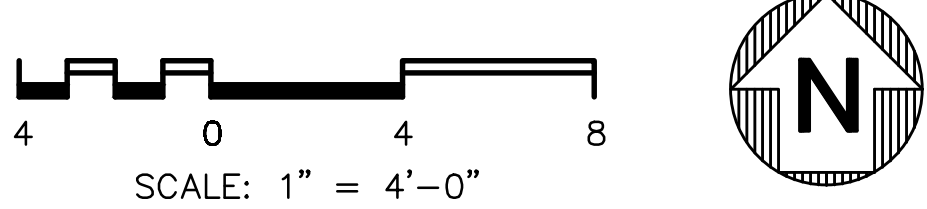

FIRST FLOOR PHOTOMETRICS - EMERG

PROPRIETARY DATA
THE USE OF THE PLANS AND SPECIFICATIONS IS LIMITED TO THE PROJECT AND SITE FOR WHICH THEY WERE PREPARED, AND PUBLICATION THEREOF IN ANY FORM OR BY ANY MEANS WITHOUT THE WRITTEN CONSENT OF CENTRAL PACIFIC ENGINEERING, INC. IS PROHIBITED. THE PROJECT FOR WHICH THE PLANS AND SPECIFICATIONS WERE PREPARED IS NOT TO BE REPRODUCED OR TRANSMITTED IN ANY FORM OR BY ANY MEANS WITHOUT THE WRITTEN CONSENT OF CENTRAL PACIFIC ENGINEERING, INC. IF YOU ARE A CONTRACTOR, YOU AGREE TO HOLD CENTRAL PACIFIC ENGINEERING, INC. HARMLESS FROM ANY AND ALL CLAIMS, DAMAGES, LOSSES AND EXPENSES, INCLUDING REASONABLE ATTORNEY'S FEES, THAT MAY BE ASSERTED AGAINST OR INCURRED BY CENTRAL PACIFIC ENGINEERING, INC. DUE TO YOUR REPRODUCTION OR TRANSMISSION OF THE PLANS AND SPECIFICATIONS WITHOUT THE WRITTEN CONSENT OF CENTRAL PACIFIC ENGINEERING, INC. THIS AGREEMENT SHALL BE A PART OF THE CONTRACT BETWEEN YOU AND THE OWNER. YOUR ACCEPTANCE OF THESE PLANS AND SPECIFICATIONS SHALL BE DEEMED YOUR ACCEPTANCE OF THIS AGREEMENT.
CENTRAL PACIFIC ENGINEERING, INC.
COPYRIGHT 2006

REGISTERED PROFESSIONAL ENGINEER
DATE GRANT: 11/19/82
EXPIRATION DATE: 08-30-24
ELECTRICAL
STATE OF CALIFORNIA

Central Pacific Engineering, Inc.
Professional Engineers
9035 Soquel Avenue, Suite 205
Santa Cruz, CA 95062
831-478-1525
CPE JOB 21-044-0

11/19/82

08-30-24

ELECTRICAL

STATE OF CALIFORNIA

REV.	DESCRIPTION	DATE
1	ISSUED FOR PLAN CHECK	08/27/22
2	PLAN CHECK & OWNER COMMENTS	10/14/22
3		
4		
5		

TITLE: AFFORDABLE HOUSING PROJECT

LOCATION: 415 NATURAL BRIDGES DRIVE
SANTA CRUZ, CALIFORNIA

OWNER: THE HOUSING AUTHORITY OF THE COUNTY OF SANTA CRUZ

DR. SAK
DATE: 04/20/22
CHK. DGS
APPD. DGS
SCALE: AS NOTED



JOB NO. 21-044-0

DWG. NO. EL2.10E

SH 28 OF 32

REV. 1


1 SECOND FLOOR PHOTOMETRICS — NORMAL
SCALE: 1/4" = 1'-0"

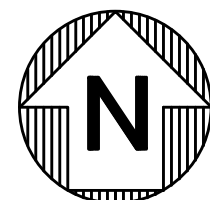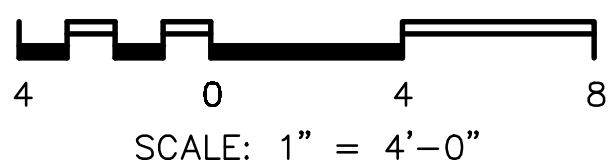

SECOND FLOOR PHOTOMETRICS - NORMAL

TITLE: AFFORDABLE HOUSING PROJECT		JOB NO. 21-044-0	
LOCATION: 415 NATURAL BRIDGES DRIVE SANTA CRUZ, CALIFORNIA		DWG. NO. EL220	
OWNER: THE HOUSING AUTHORITY OF THE COUNTY OF SANTA CRUZ		SH 29 OF 32	
DR. SAK	DATE 04/20/22	CHK. DGS	REV. 1
APPD. DGS	SCALE AS NOTED		


REV.	DESCRIPTION	DATE
1	ISSUED FOR PLAN CHECK	08/27/22
2	PLAN CHECK & OWNER COMMENTS	10/14/22
3		
4		
5		

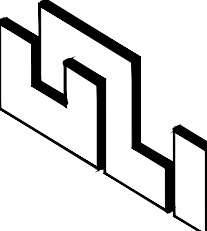


Central Pacific Engineering, Inc.
Professional Engineers
9035 Soquel Avenue, Suite 205
Santa Cruz, CA 95062
831-478-1525
CPE JOB 21-044-0



PROPRIETARY DATA
THE USE OF THE PLANS AND SPECIFICATIONS IS LIMITED TO THE PROJECT AND SITE FOR WHICH THEY WERE PREPARED, AND PUBLICATION THEREOF IN ANY FORM OR BY ANY MEANS WITHOUT THE WRITTEN CONSENT OF CENTRAL PACIFIC ENGINEERING, INC. IS PROHIBITED. THE PROJECT FOR WHICH THE PLANS AND SPECIFICATIONS WERE PREPARED IS THE PROPERTY OF CENTRAL PACIFIC ENGINEERING, INC. AND THE INFORMATION CONTAINED HEREIN IS NOT TO BE USED FOR ANY OTHER PROJECT WITHOUT THE WRITTEN CONSENT OF CENTRAL PACIFIC ENGINEERING, INC. COPYRIGHT 2020

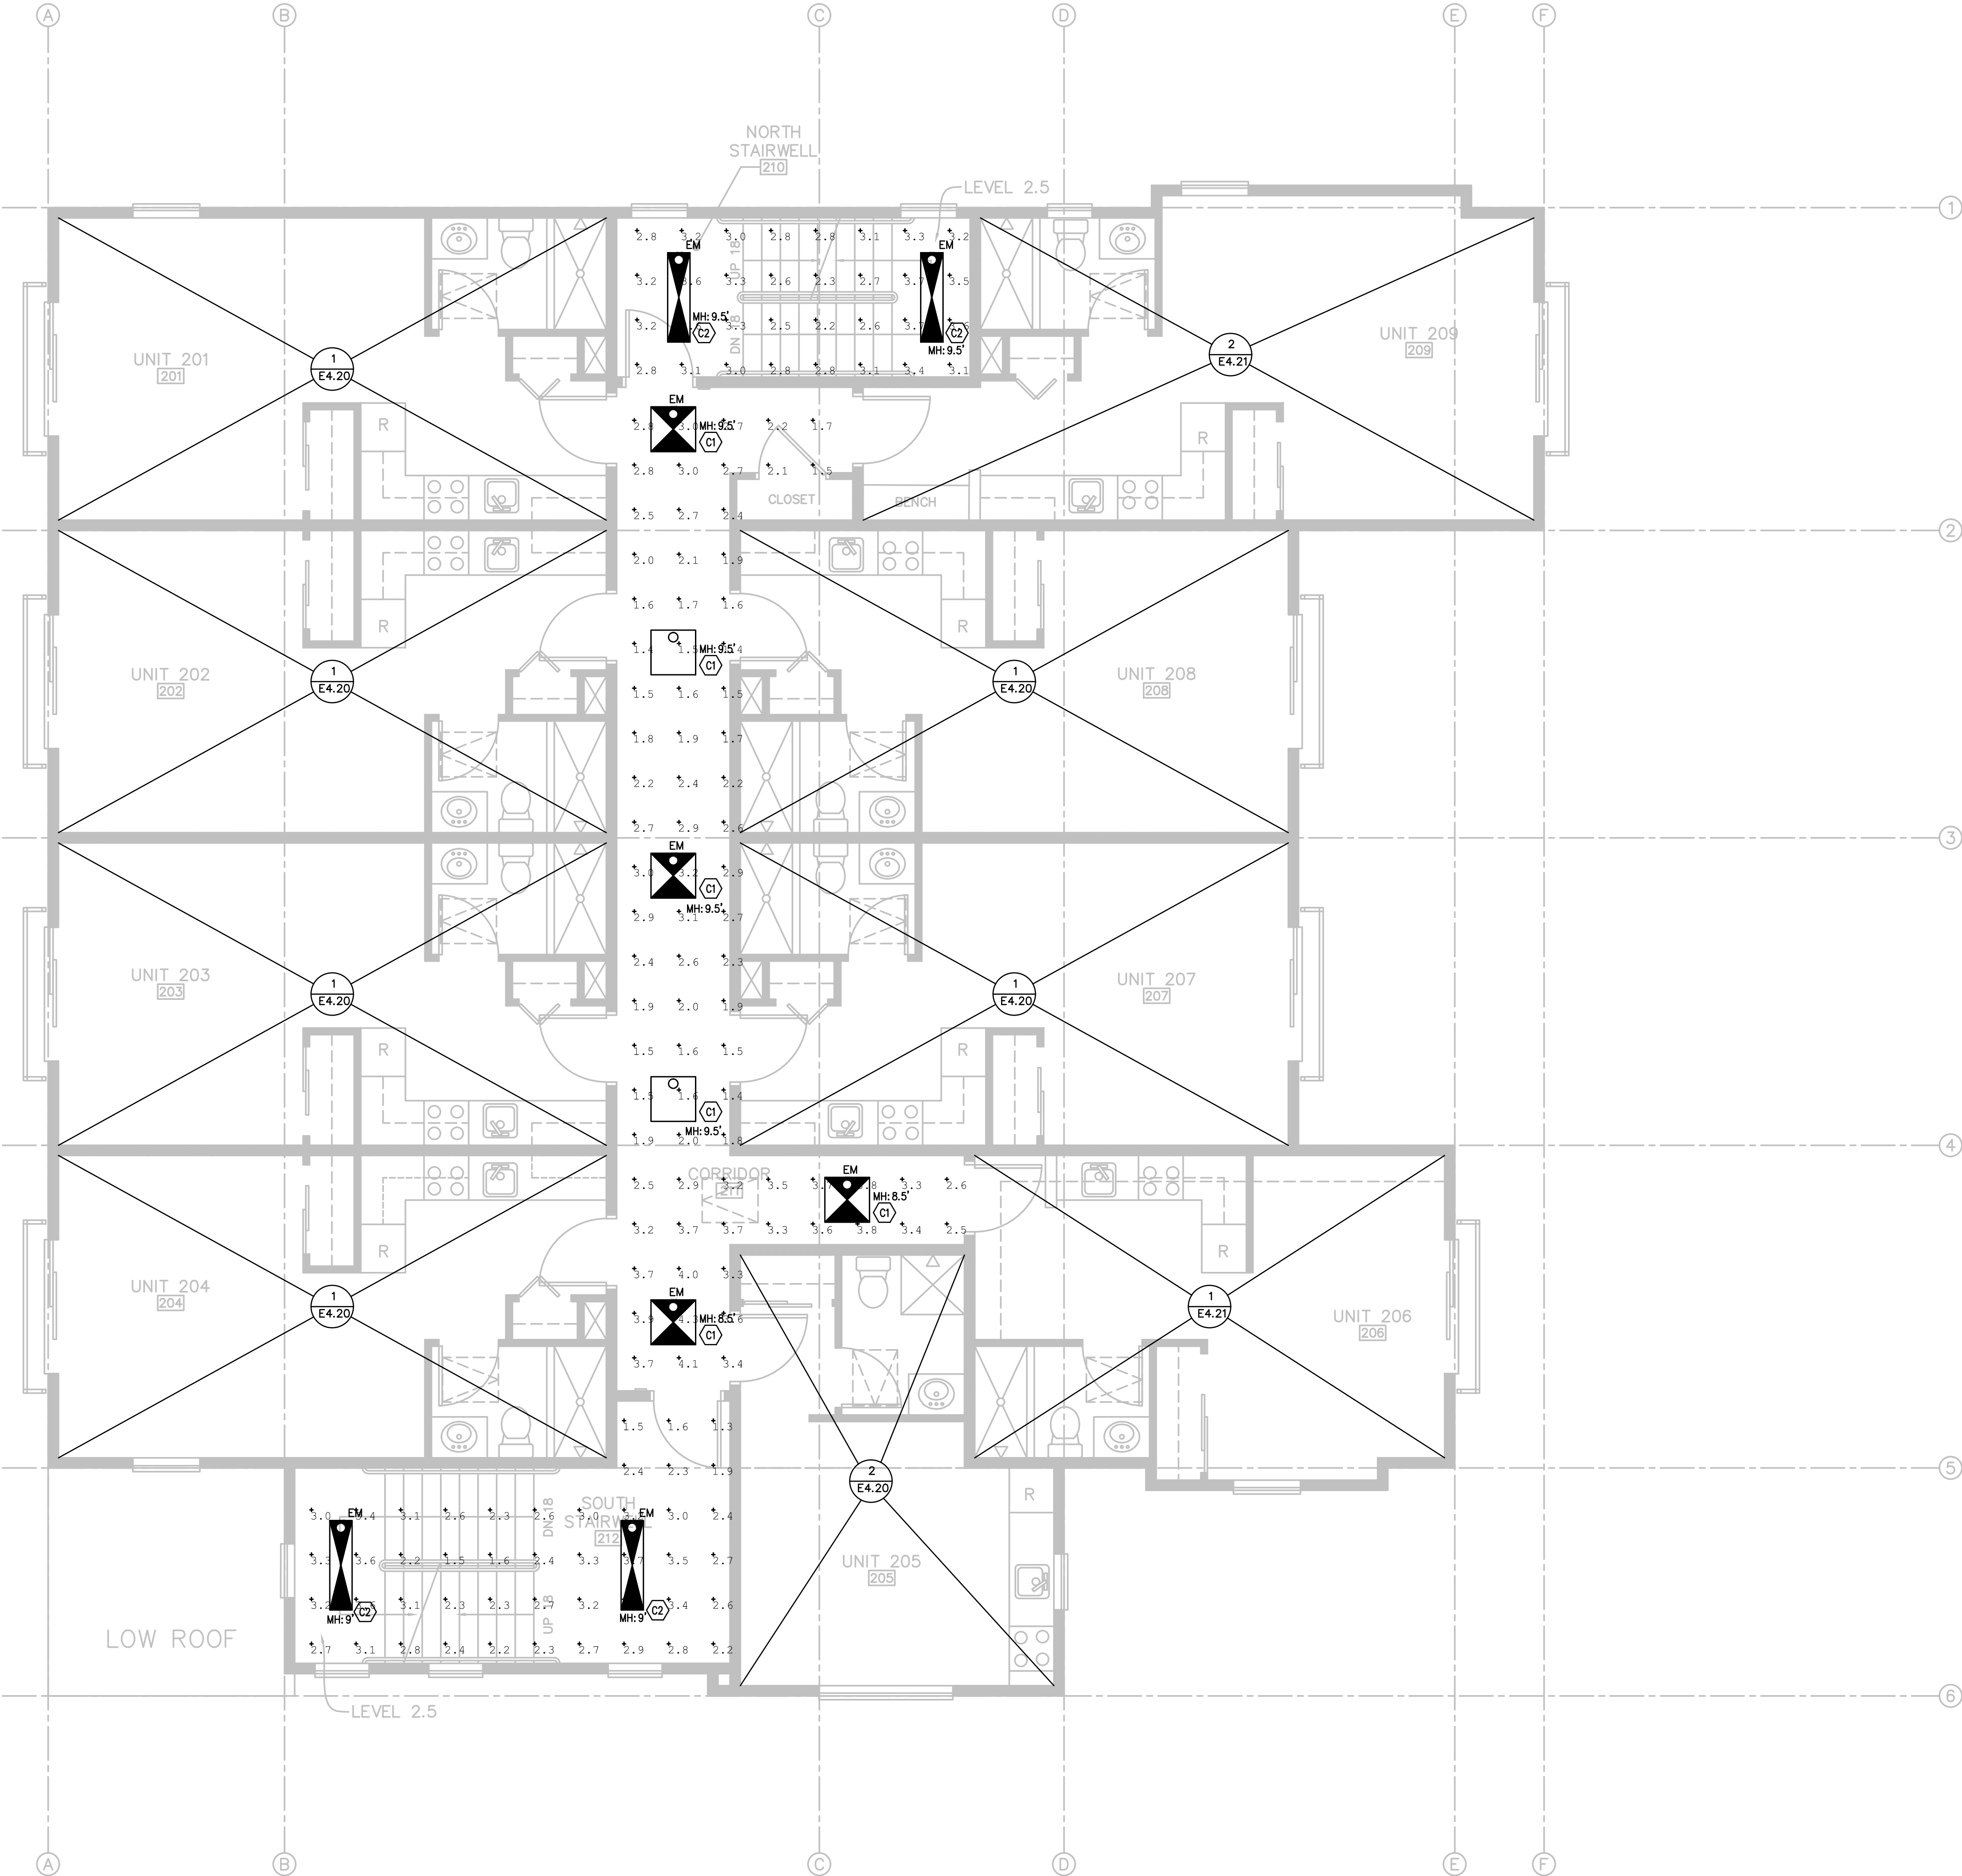

1 SECOND FLOOR PHOTOMETRICS — EMERG
SCALE: 1/4" = 1'-0"

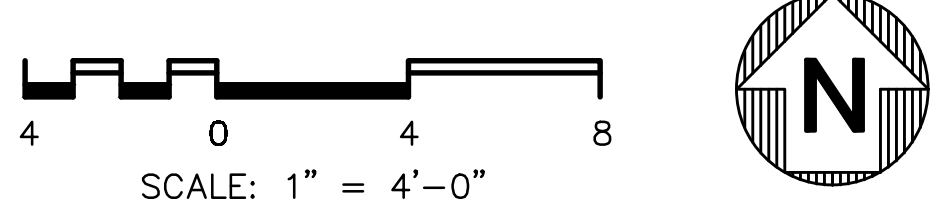

SECOND FLOOR PHOTOMETRICS - EMERG

PROPRIETARY DATA

THE USE OF THE PLANS AND SPECIFICATIONS IS LIMITED TO THE PROJECT AND SITE FOR WHICH THEY WERE PREPARED, AND PUBLICATION THEREOF IS PROHIBITED WITHOUT THE WRITTEN CONSENT OF THE ENGINEER. ANY REUSE OR MODIFICATION OF THE PLANS OR SPECIFICATIONS FOR ANY OTHER PROJECT WITHOUT THE WRITTEN CONSENT OF THE ENGINEER IS PROHIBITED. THE ENGINEER ASSUMES NO LIABILITY FOR ANY DAMAGE OR INJURY TO PERSONS OR PROPERTY, WHETHER CAUSED BY NEGLIGENCE OR OTHERWISE, ARISING OUT OF OR IN CONNECTION WITH THE PERFORMANCE OF THE PROFESSIONAL SERVICES PROVIDED BY THE ENGINEER.

REGISTERED PROFESSIONAL ENGINEER
DATE GRANT: 11/15/22
EXPIRATION DATE: 08-30-24
ELECTRICAL
STATE OF CALIFORNIA

Central Pacific Engineering, Inc.
Professional Engineers
9035 Soquel Avenue, Suite 205
Santa Cruz, CA 95062
831-478-1525
CPE JOB 21-044-0

REV.	DESCRIPTION	DATE
1	ISSUED FOR PLAN CHECK	08/27/22
2	PLAN CHECK & OWNER COMMENTS	10/14/22
3		
4		
5		

TITLE: AFFORDABLE HOUSING PROJECT

JOB NO. 21-044-0

DWG. NO. EL2.20E

SH 30 OF 32

LOCATION: 415 NATURAL BRIDGES DRIVE
SANTA CRUZ, CALIFORNIA

OWNER: THE HOUSING AUTHORITY OF THE COUNTY OF SANTA CRUZ


DR. SAK

DATE 04/20/22



CHK. DGS

APPD. DGS

SCALE AS NOTED

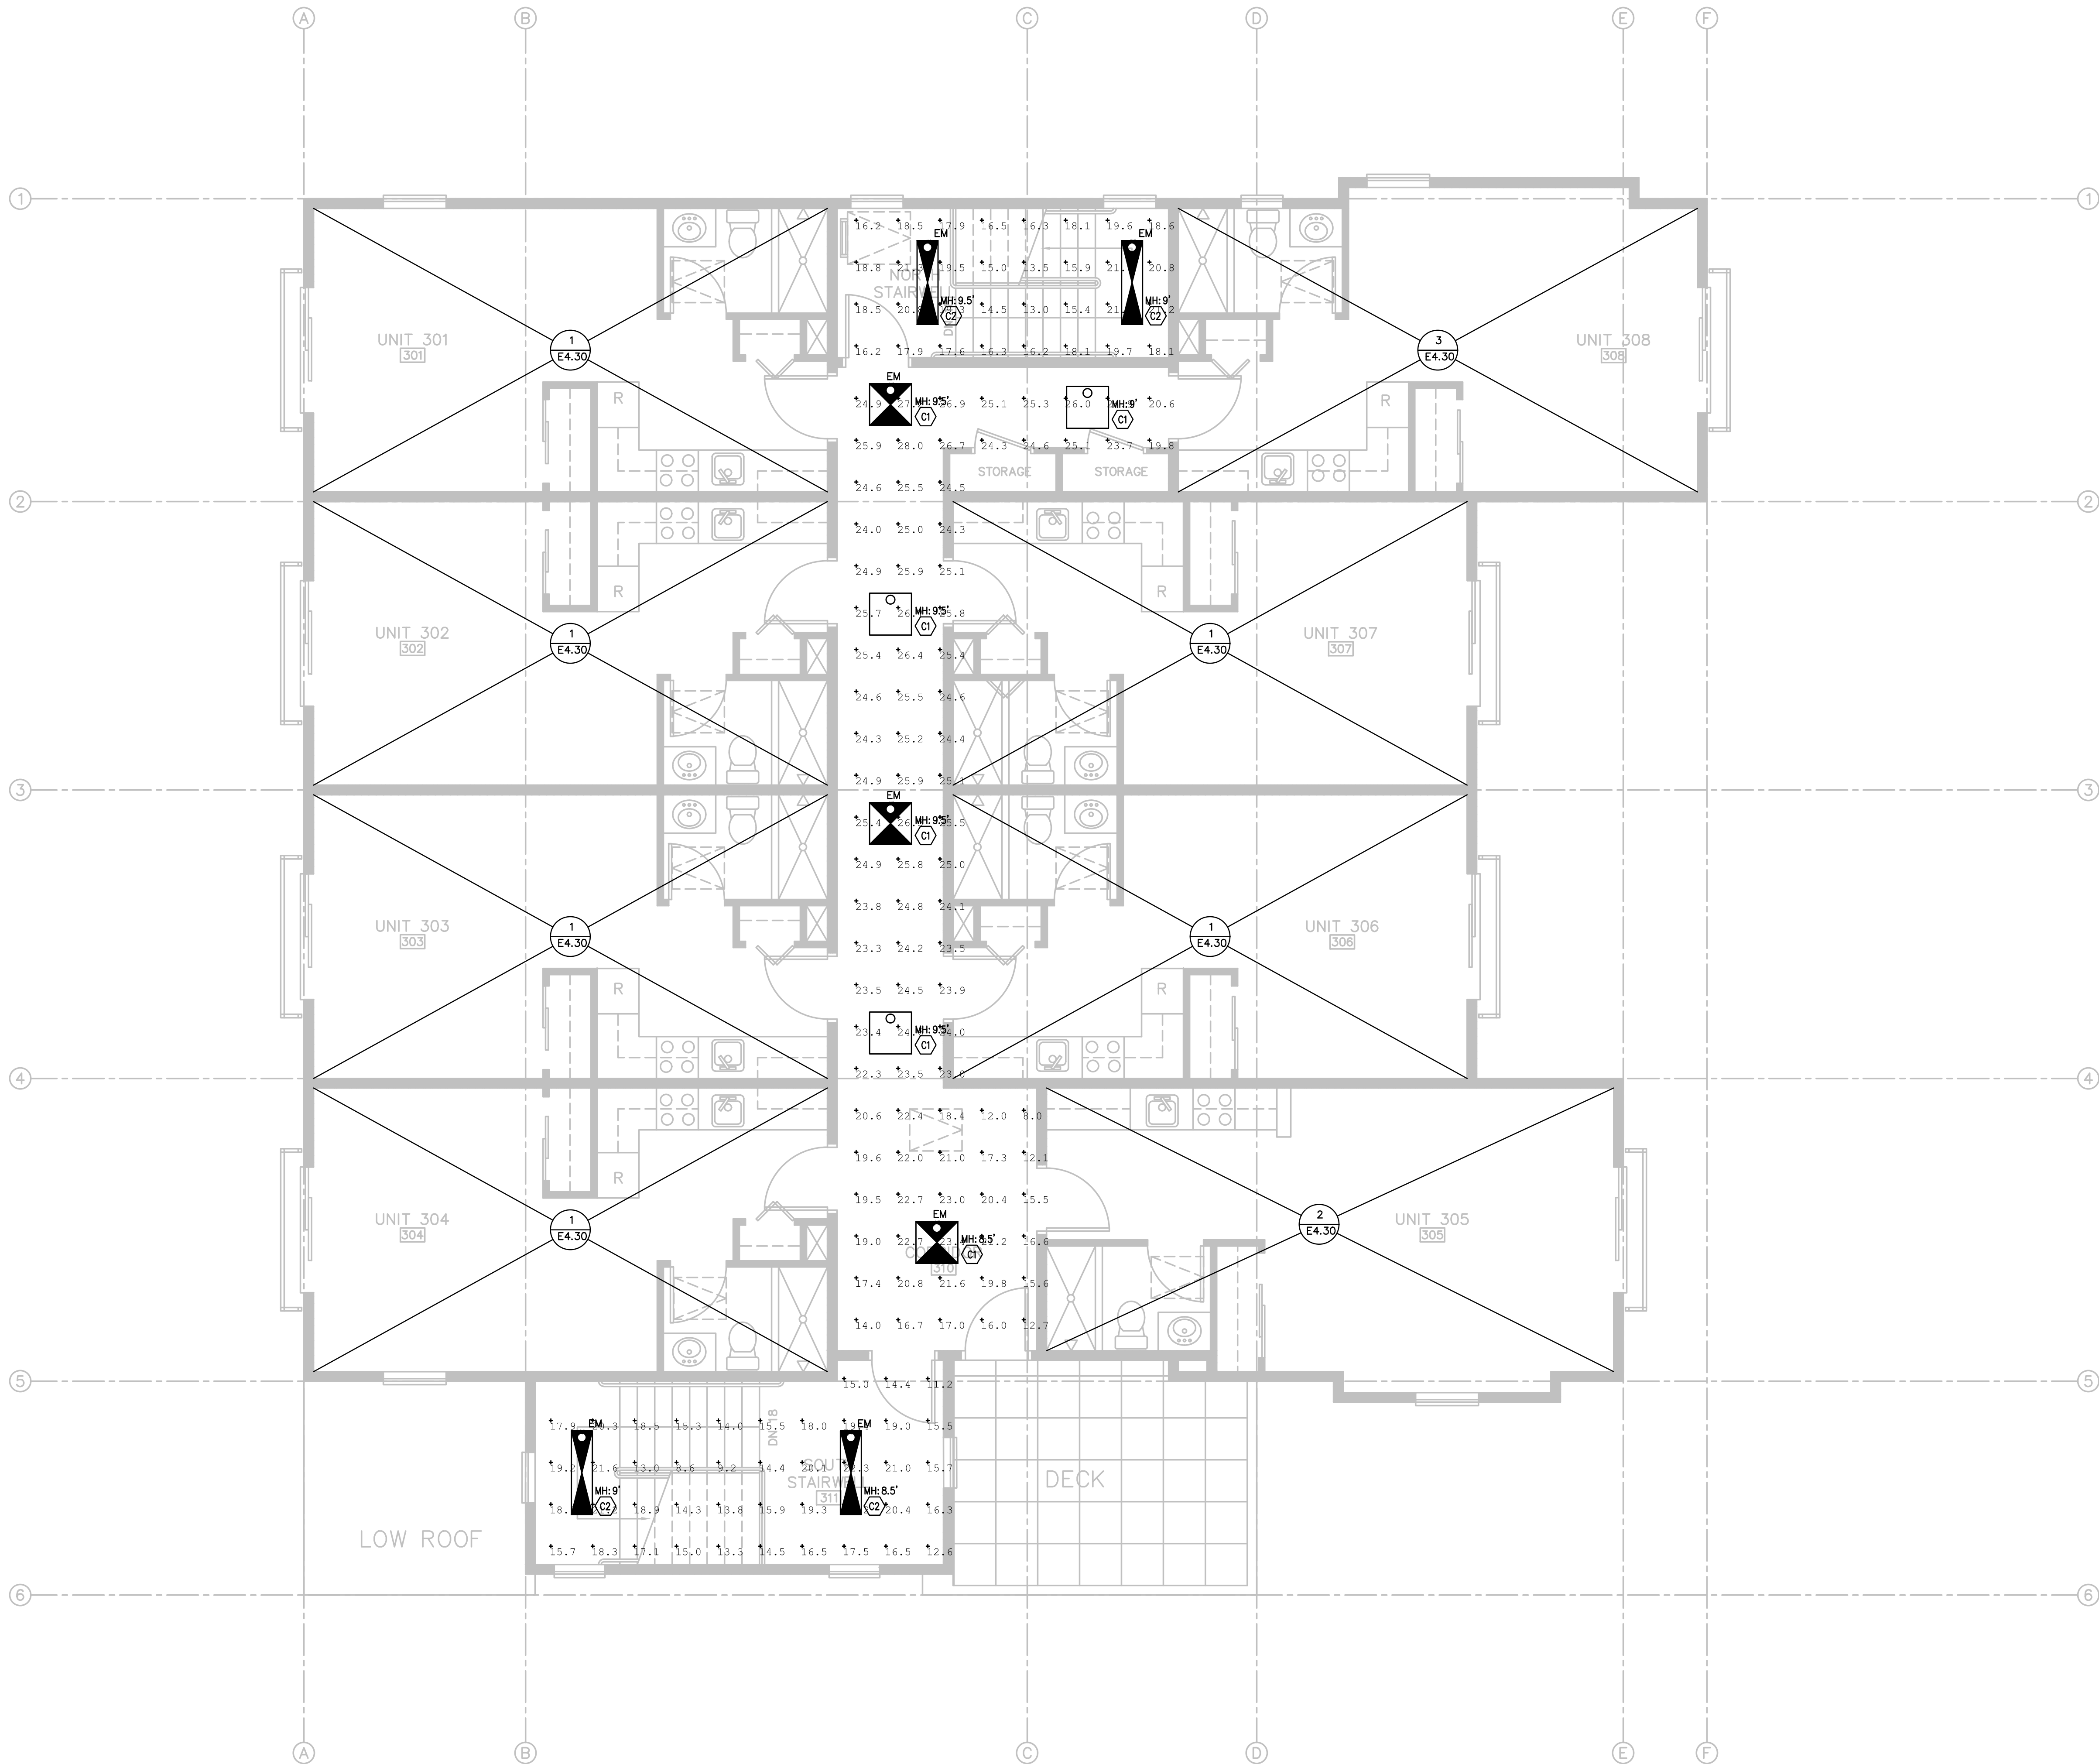

1 THIRD FLOOR PHOTOMETRICS — NORMAL
SCALE: 1/4" = 1'-0"

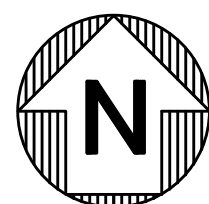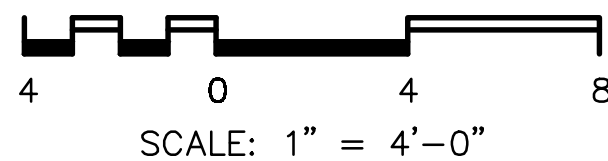

THIRD FLOOR PHOTOMETRICS - NORMAL

PROPRIETARY DATA

THE USE OF THE PLANS AND SPECIFICATIONS IS LIMITED TO THE PROJECT AND SITE FOR WHICH THEY WERE PREPARED, AND PUBLICATION THEREOF IS PROHIBITED WITHOUT THE WRITTEN CONSENT OF THE ENGINEER. ANY REUSE OR MODIFICATION OF THE PLANS OR SPECIFICATIONS FOR ANY OTHER PROJECT WITHOUT THE WRITTEN CONSENT OF THE ENGINEER IS PROHIBITED. THE ENGINEER ASSUMES NO LIABILITY FOR ANY DAMAGE OR INJURY TO PERSONS OR PROPERTY, OR FOR ANY LOSS OF PROFITS OR BUSINESS, ARISING OUT OF THE USE OF THE PLANS OR SPECIFICATIONS, WHETHER THE PROJECT FOR WHICH THE PLANS AND SPECIFICATIONS WERE PREPARED IS OR IS NOT A PUBLIC WORK, OR WHETHER THE PROJECT FOR WHICH THE PLANS AND SPECIFICATIONS WERE PREPARED IS OR IS NOT A PUBLIC WORK, OR WHETHER THE PROJECT FOR WHICH THE PLANS AND SPECIFICATIONS WERE PREPARED IS OR IS NOT A PUBLIC WORK, OR WHETHER THE PROJECT FOR WHICH THE PLANS AND SPECIFICATIONS WERE PREPARED IS OR IS NOT A PUBLIC WORK.

COPYRIGHT 2022
CENTRAL PACIFIC ENGINEERING, INC.

REGISTERED PROFESSIONAL ENGINEER
DATE GRANTED: 11/19/22
EXPIRATION DATE: 09-30-24
ELECTRICAL
STATE OF CALIFORNIA

Central Pacific Engineering, Inc.

Professional Engineers
9035 Soquel Avenue, Suite 205
Santa Cruz, CA 95062
831-478-1525
CPE JOB 21-044-0

REV.	DESCRIPTION	DATE
1	ISSUED FOR PLAN CHECK	08/27/22
2	PLAN CHECK & OWNER COMMENTS	10/14/22
3		
4		
5		

TITLE: AFFORDABLE HOUSING PROJECT

JOB NO. 21-044-0

DWG. NO. EL230

LOCATION: 415 NATURAL BRIDGES DRIVE
SANTA CRUZ, CALIFORNIA

OWNER: THE HOUSING AUTHORITY OF THE COUNTY OF SANTA CRUZ

DR. SAK


DATE 04/20/22

CHK. DGS



APPD. DGS

SCALE AS NOTED

SH 31	REV. 1
OF 32	

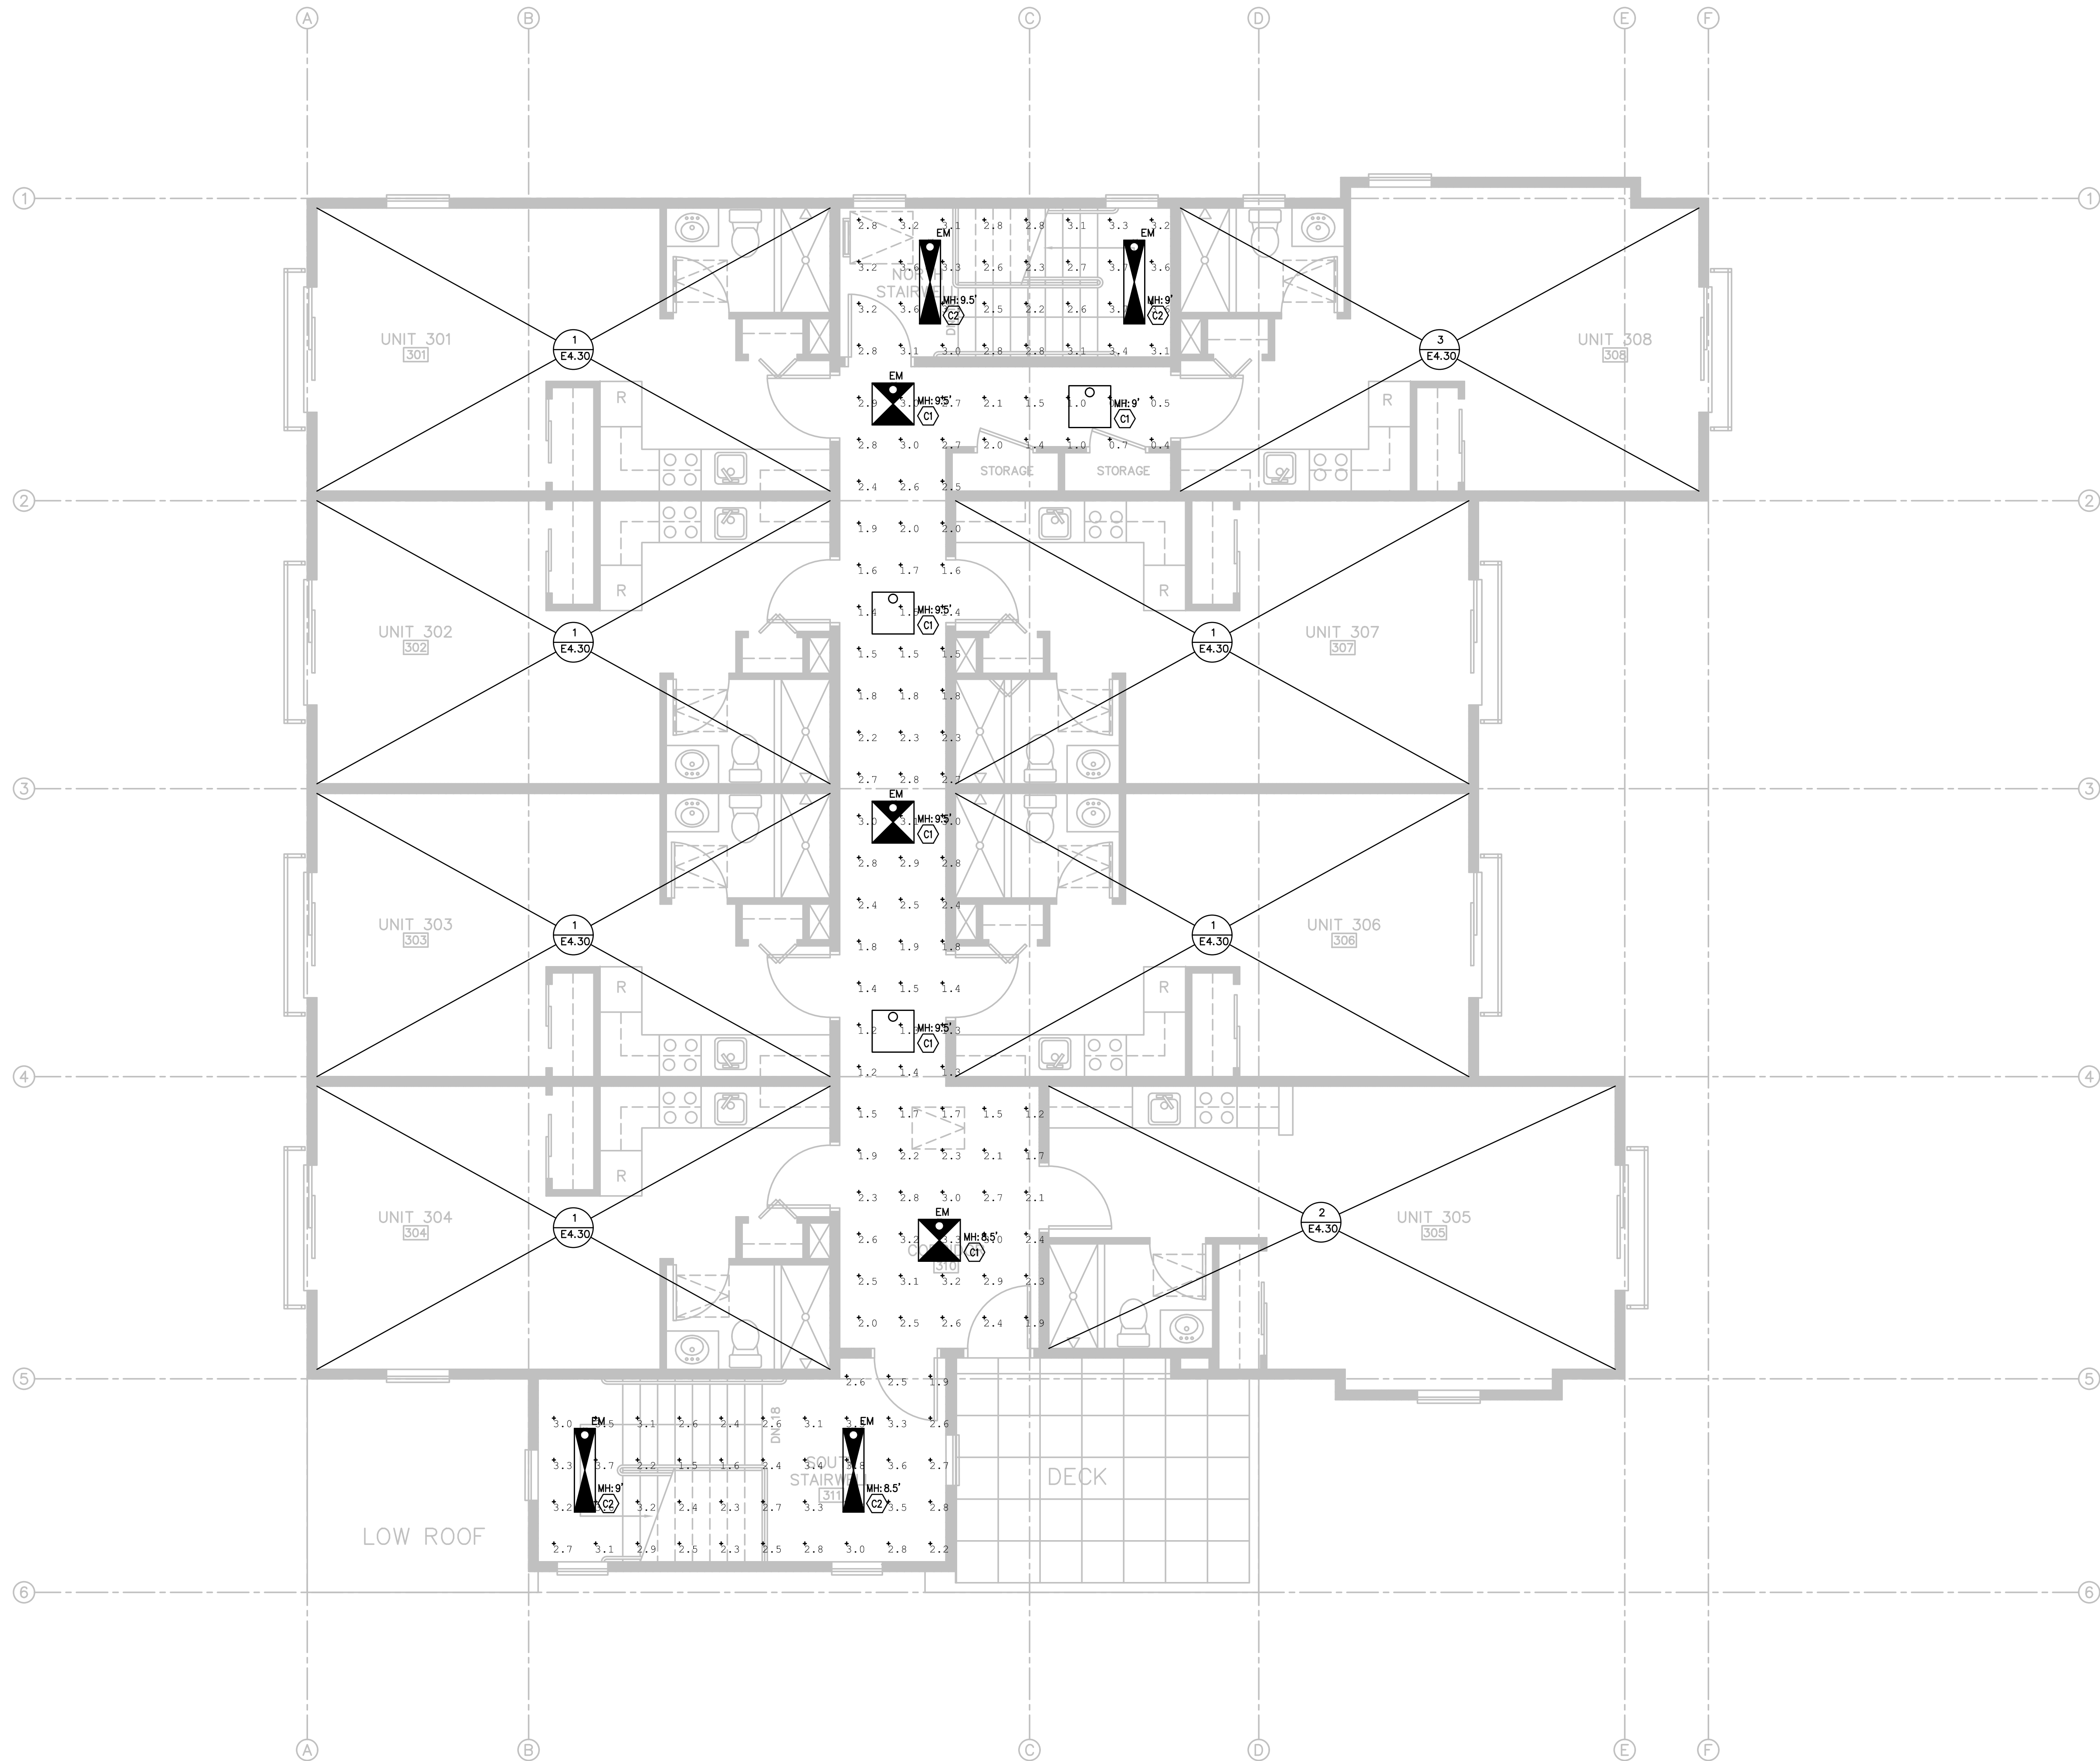

1 THIRD FLOOR PHOTOMETRICS — EMERG
SCALE: 1/4" = 1'-0"

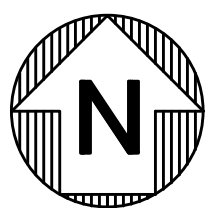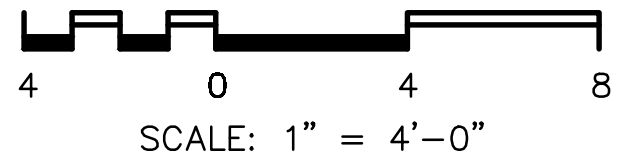

THIRD FLOOR PHOTOMETRICS - EMERG

PROPRIETARY DATA

THE USE OF THE PLANS AND SPECIFICATIONS IS LIMITED TO THE PROJECT AND SITE SPECIFICALLY IDENTIFIED HEREON. ANY REUSE OR MODIFICATION OF THESE PLANS OR SPECIFICATIONS WITHOUT THE WRITTEN CONSENT OF CENTRAL PACIFIC ENGINEERING, INC. IS PROHIBITED. THE USER AGREES TO HOLD CENTRAL PACIFIC ENGINEERING, INC. HARMLESS FROM ANY AND ALL CLAIMS, DAMAGES, LOSSES AND EXPENSES, INCLUDING REASONABLE ATTORNEY'S FEES, ARISING OUT OF OR RESULTING FROM THE USE OF THESE PLANS OR SPECIFICATIONS.

COPYRIGHT 2022
CENTRAL PACIFIC ENGINEERING, INC.

REGISTERED PROFESSIONAL ENGINEER
DATE GRANTED: 11/15/22
EXPIRATION DATE: 08-30-24
ELECTRICAL
STATE OF CALIFORNIA

Central Pacific Engineering, Inc.
Professional Engineers
9035 Soquel Avenue, Suite 205
Santa Cruz, CA 95062
831-478-1525
CPE JOB 21-044-0

REV.	DESCRIPTION	DATE
A	ISSUED FOR PLAN CHECK	08/27/22
A	PLAN CHECK & OWNER COMMENTS	10/14/22
A		
A		
A		
A		

TITLE: AFFORDABLE HOUSING PROJECT	
LOCATION: 415 NATURAL BRIDGES DRIVE SANTA CRUZ, CALIFORNIA	OWNER: THE HOUSING AUTHORITY OF THE COUNTY OF SANTA CRUZ
DR. SAK	DATE: 04/20/22
CHK. DGS	SCALE: AS NOTED
APPD. DGS	

JOB NO. 21-044-0
DWG. NO. EL2.30E
SH 32 OF 32
REV. 1